

PLAT OF SURVEY FOR JACK CUSICK AND ERNIE KOVACS

ORIGINAL LOT 12 - TRACT NO. 12

HENRIETTA TOWNSHIP


LORAIN COUNTY OHIO

SCALE: 1" = 60' APRIL-MAY 1973

Gary E. Penfound

Reg. Surveyor No. 4457

NOTES: ○ indicates iron pin found.
● indicates iron pin set
unless otherwise designated.

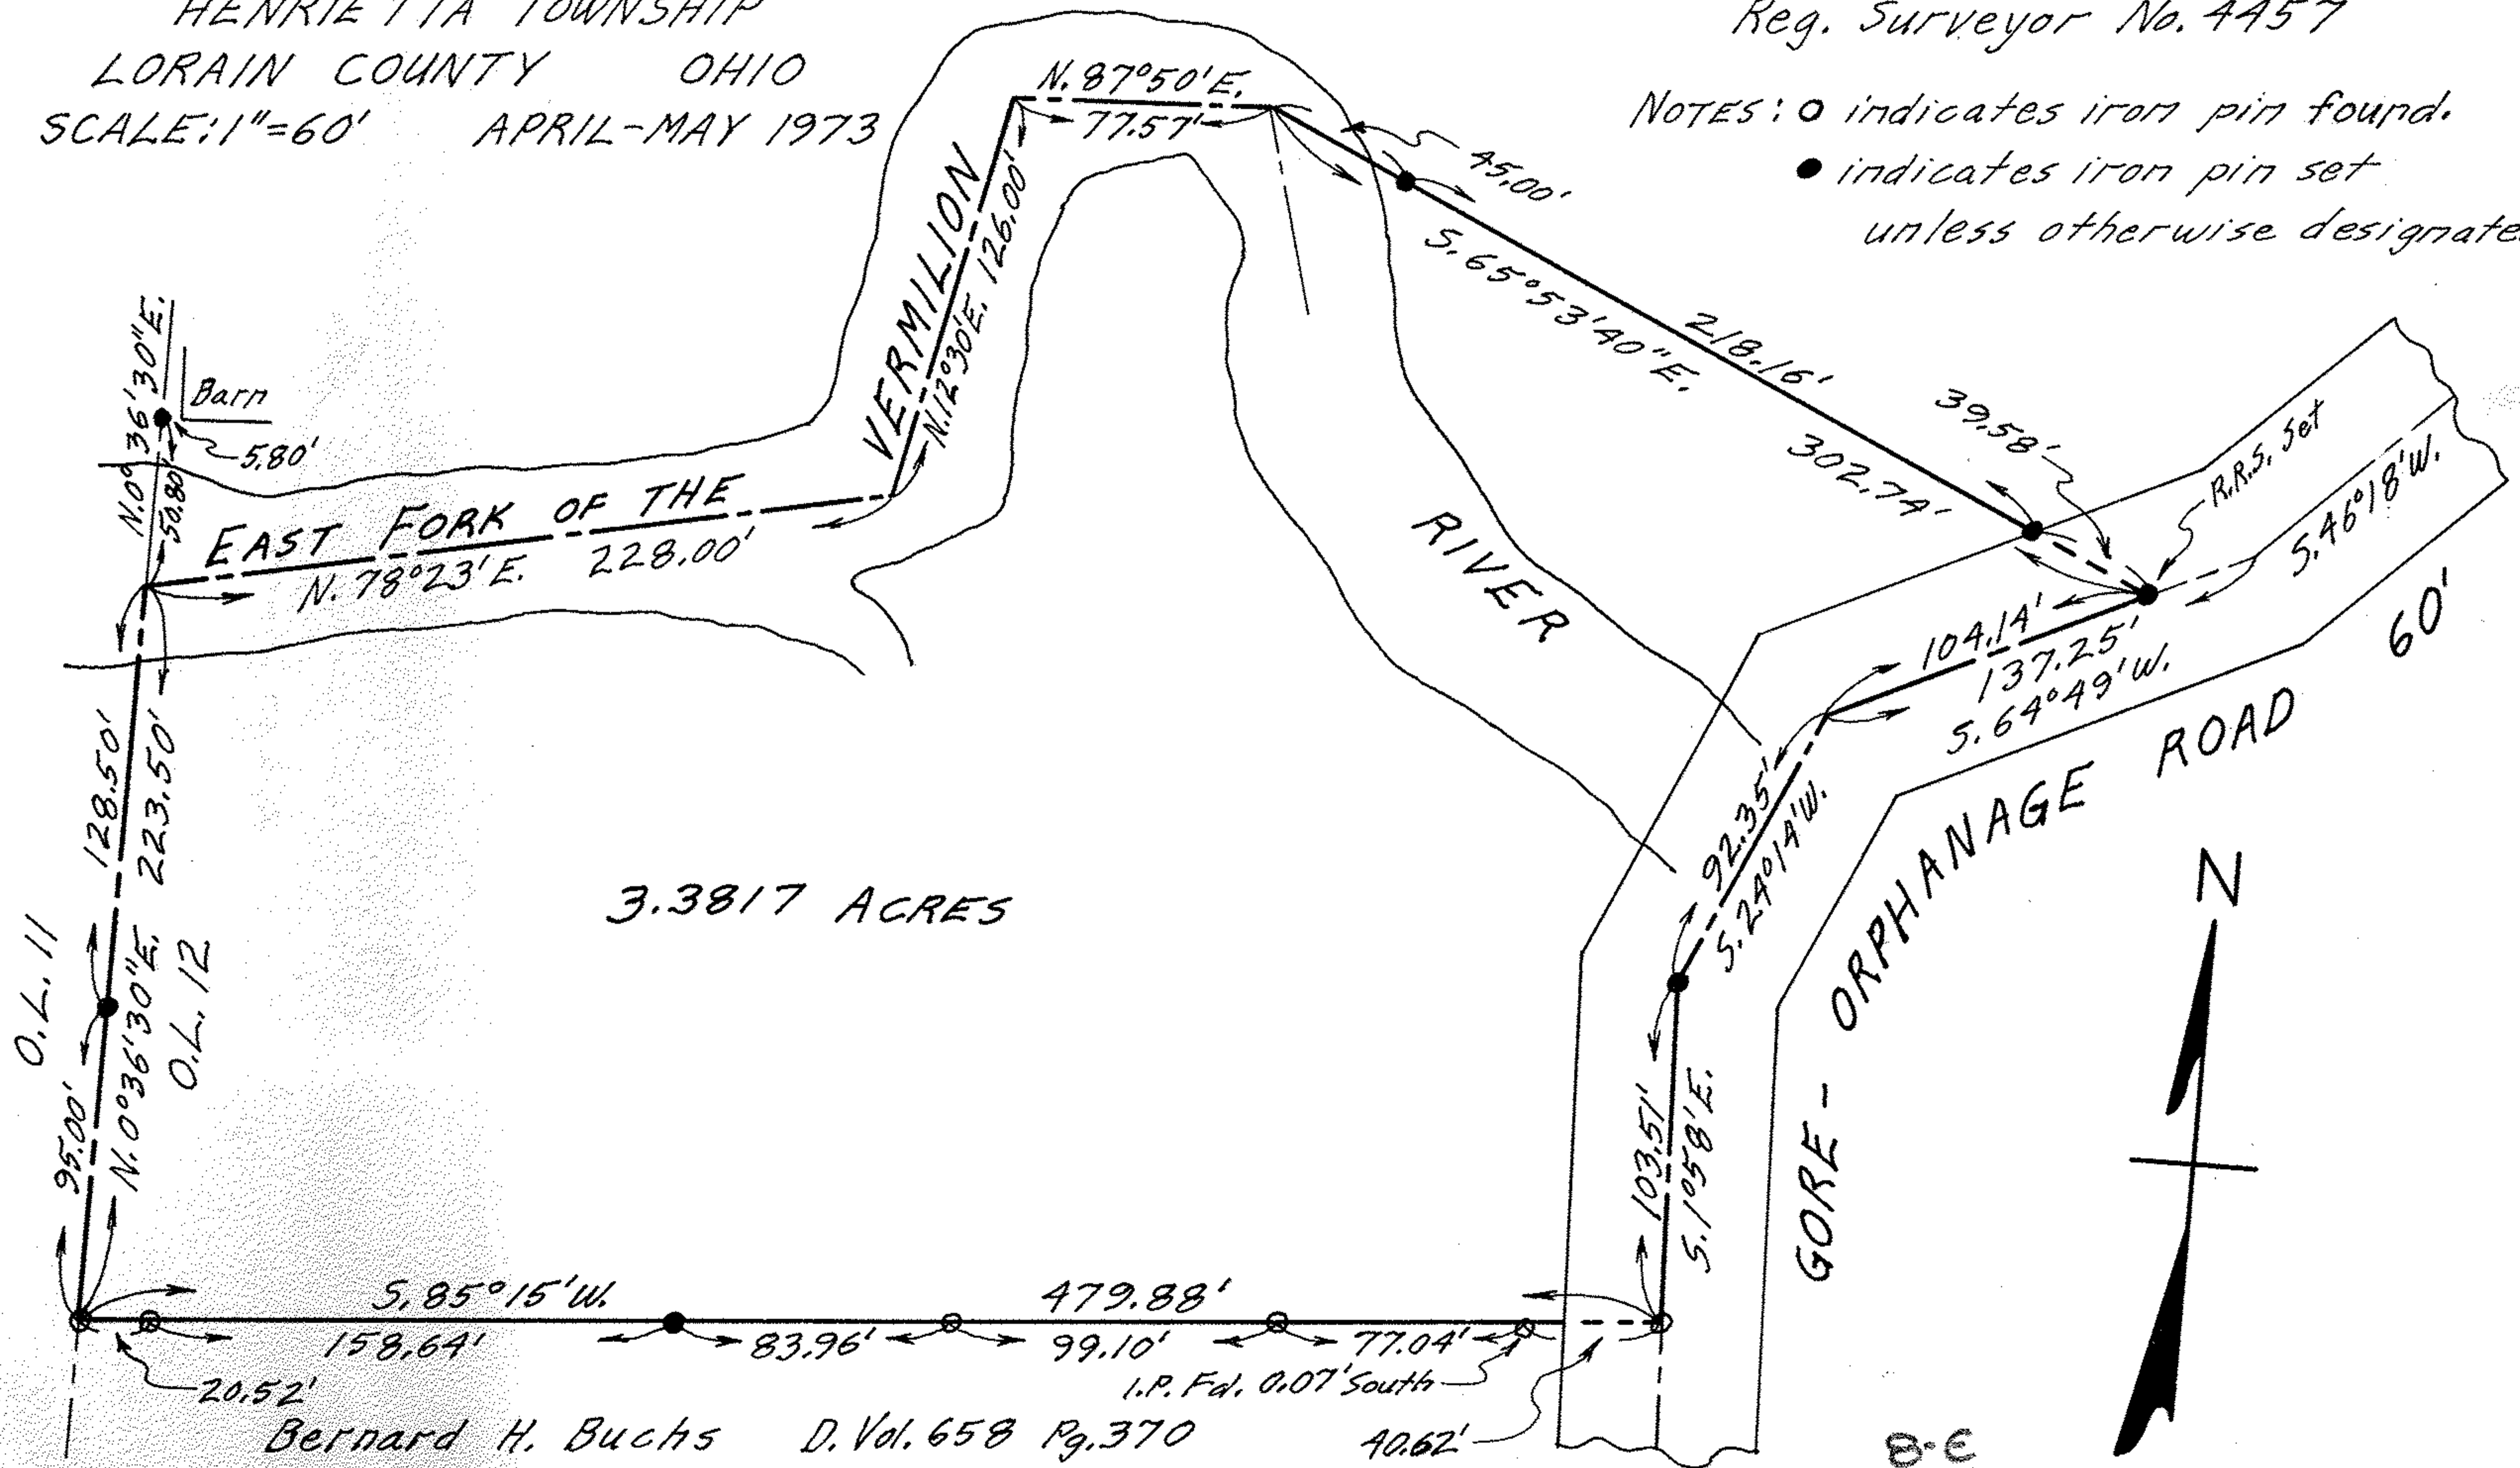

Bernard H. Buchs D. Vol. 658 Pg. 370

B-E

08-17-012-000-025

08-12-012