
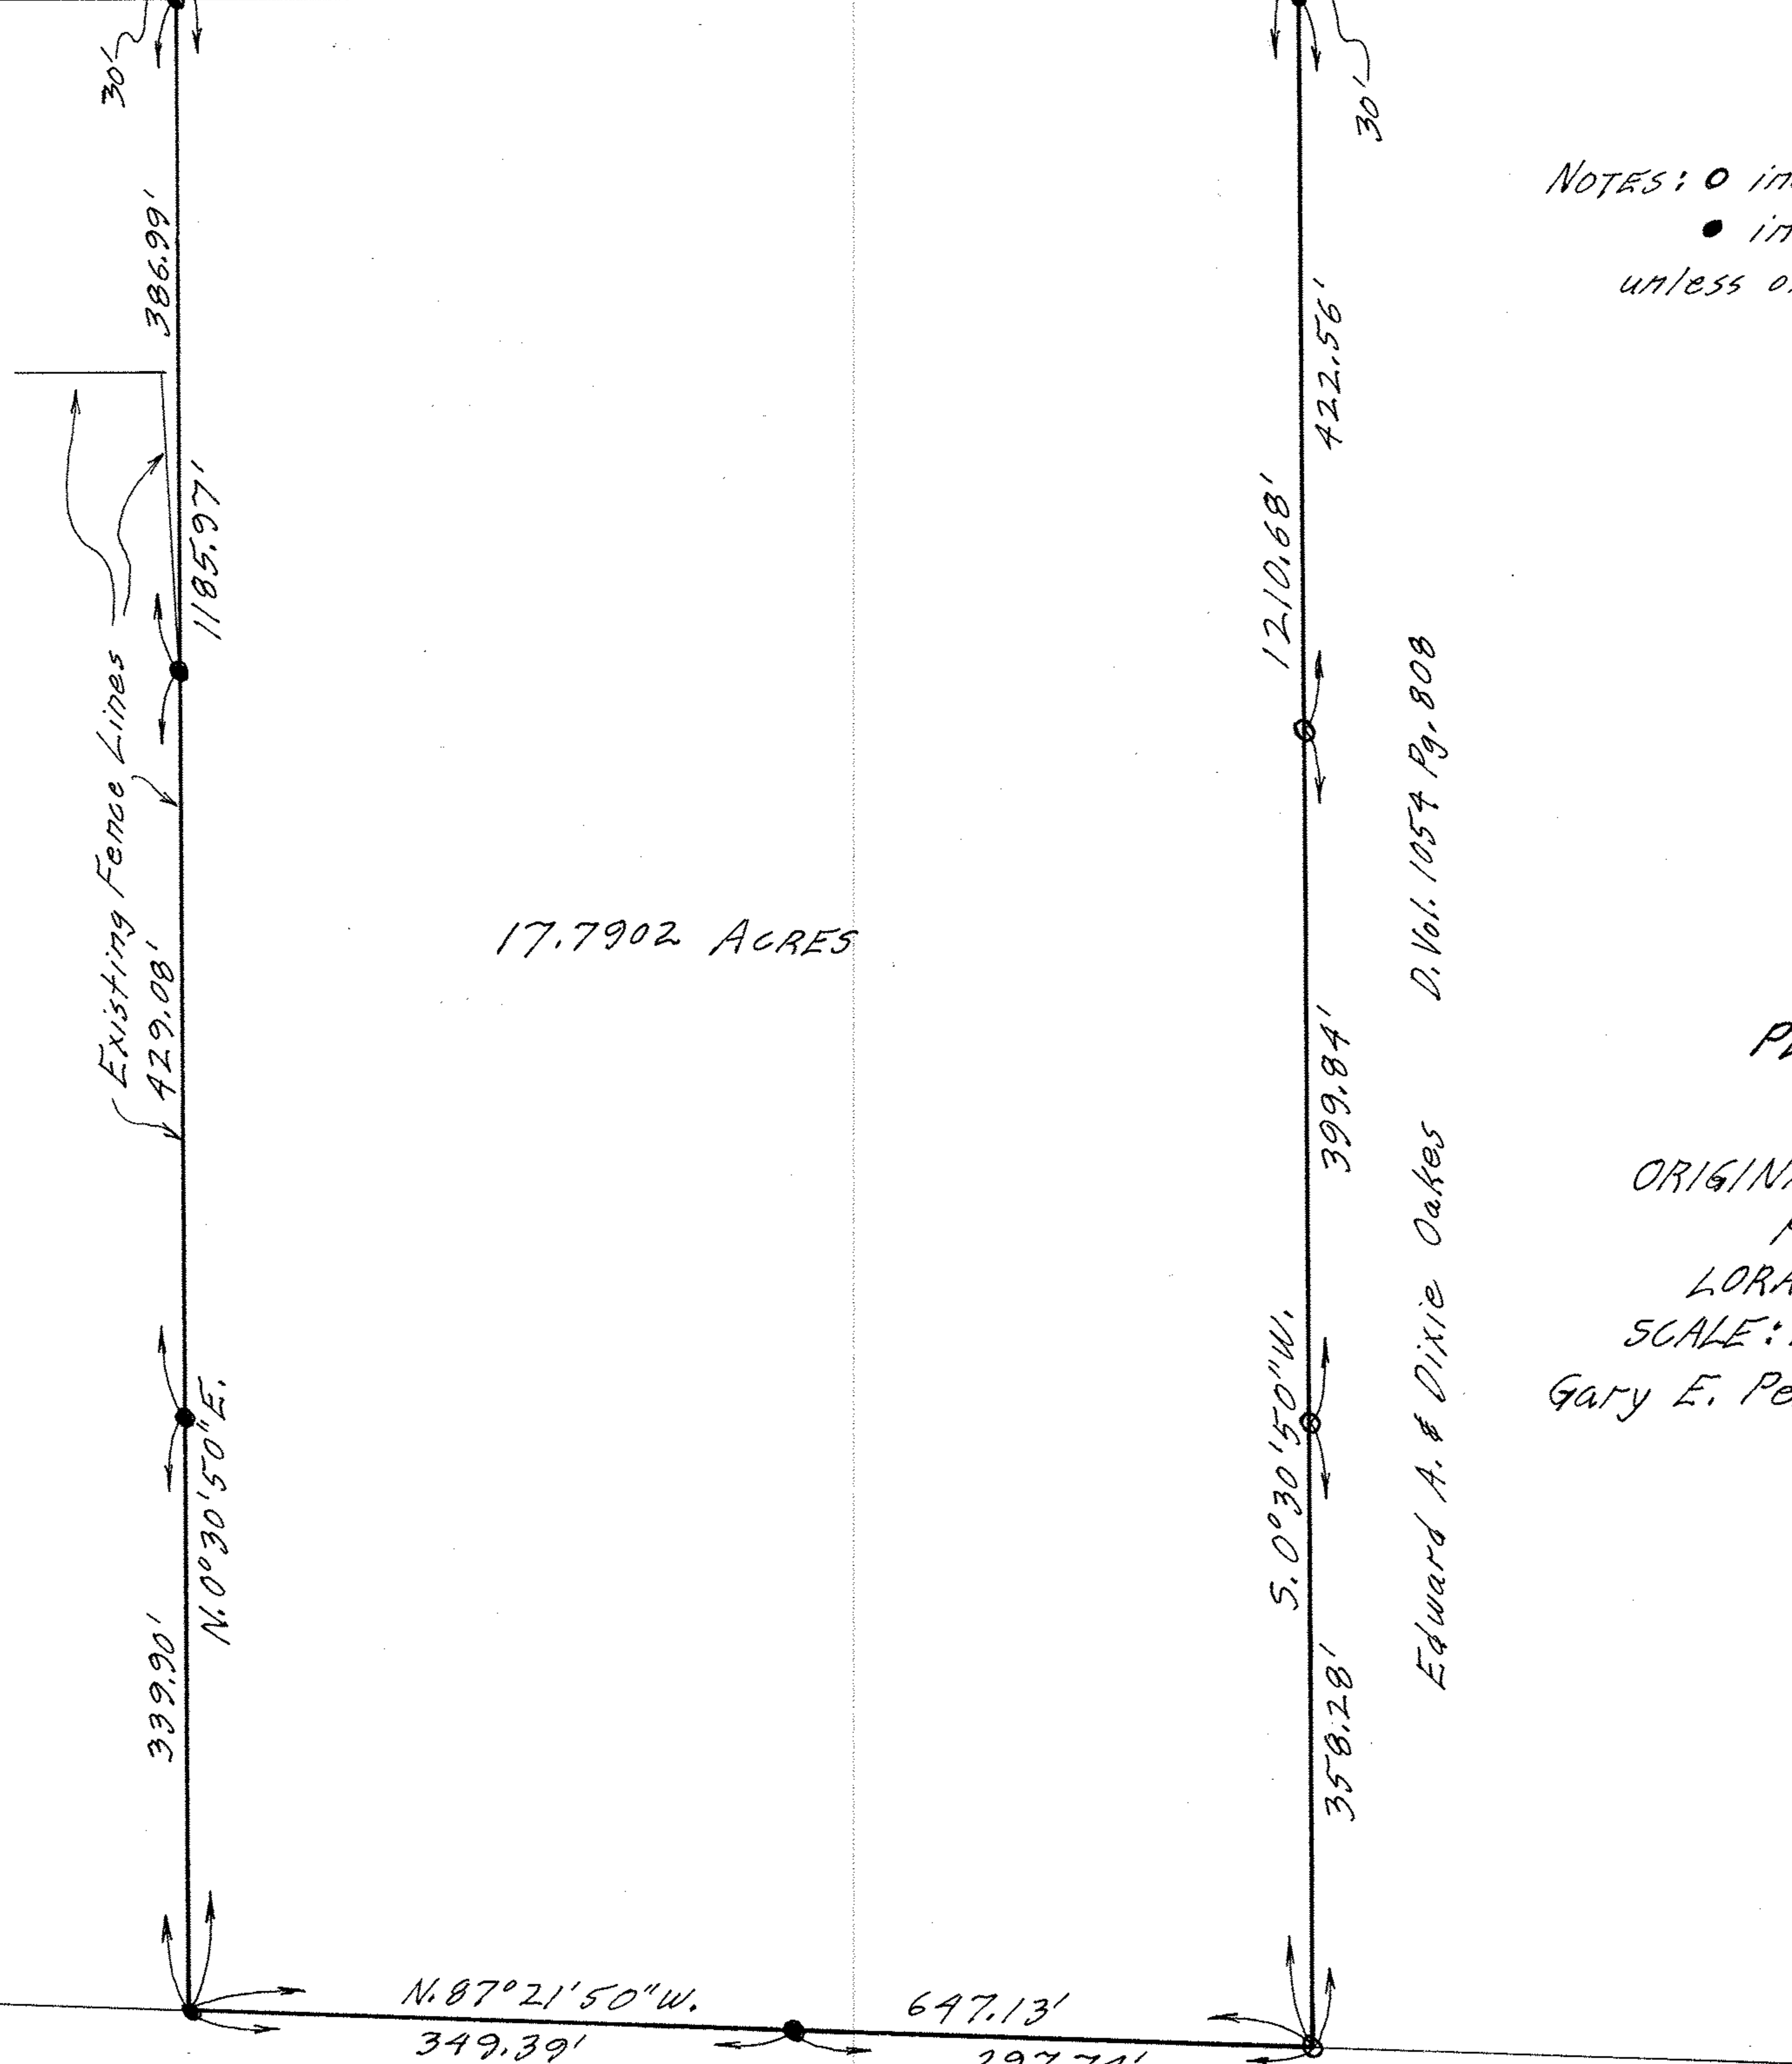


NICKLE PLATE-DIAGONAL ROAD 60'

PECK-WADSWORTH ROAD 60'


O.L. 117 SECTION 6  
O.L. 18 SECTION 5

I.P.F.d. in  
Mon. Box

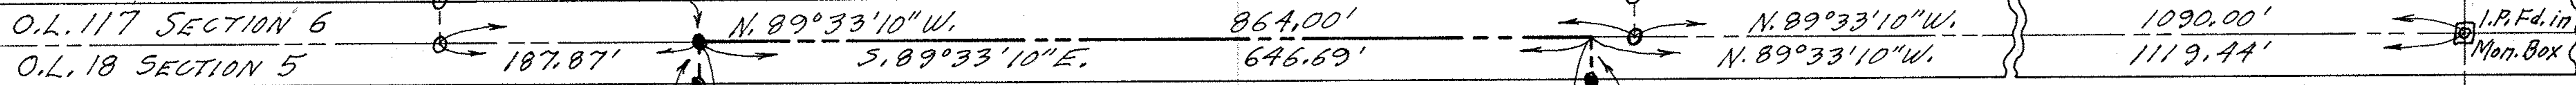

17.7902 ACRES

NOTES: ○ indicates iron pin found.  
● indicates iron pin set unless otherwise designated.

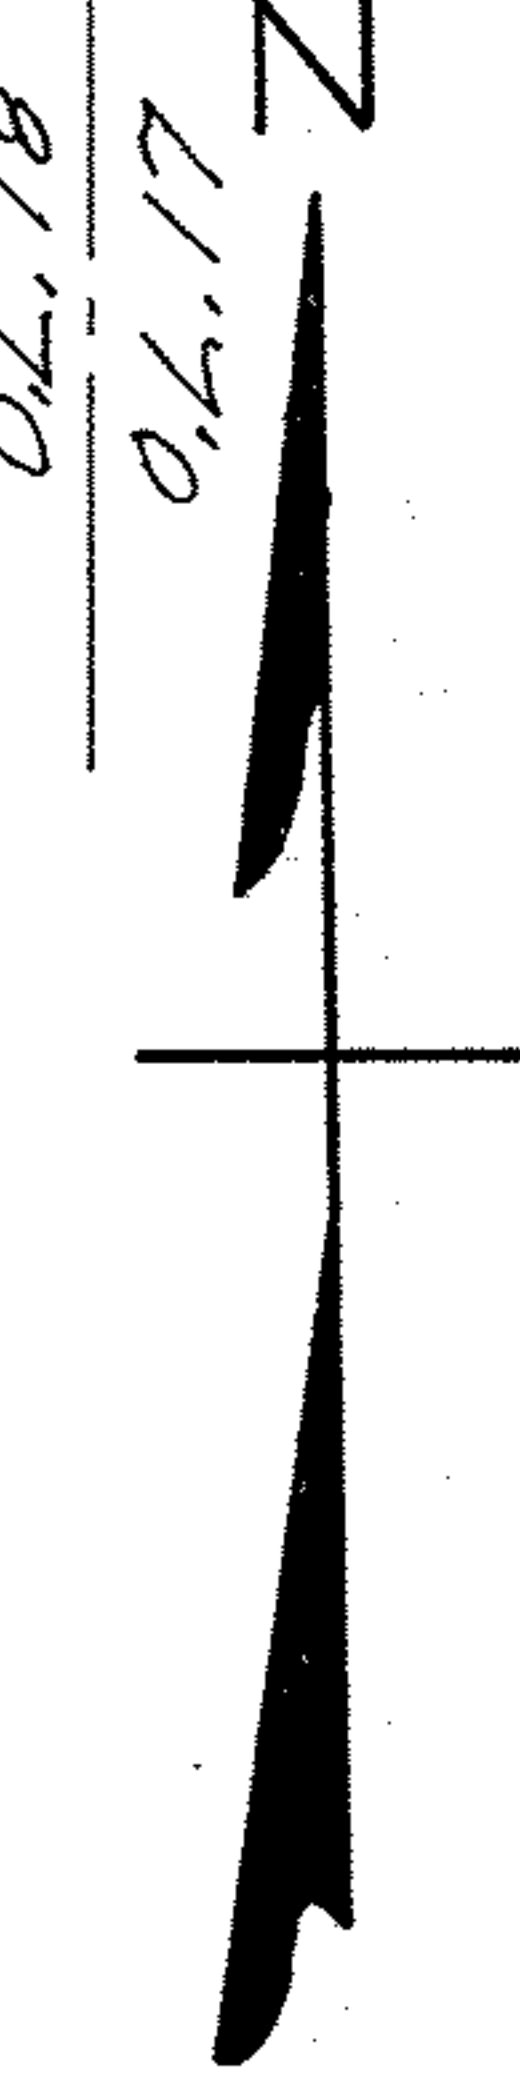

Edward A. & Dixie Oakes D. Vol. 1054 Pg. 808

PLAT OF SURVEY FOR  
THALIA M. SOOY  
ORIGINAL LOT 18 - SECTION NO. 5  
PENFIELD TOWNSHIP  
LORAIN COUNTY OHIO  
SCALE: 1"=100' FEBRUARY-1976  
Gary E. Penfound Reg. Surveyor No. 4457

George & Frances D. Bullis D. Vol. 230 Pg. 306 & D. Vol. 743 Pg. 422 Parcel No. 1

19-05-018-000-015  
19-A