
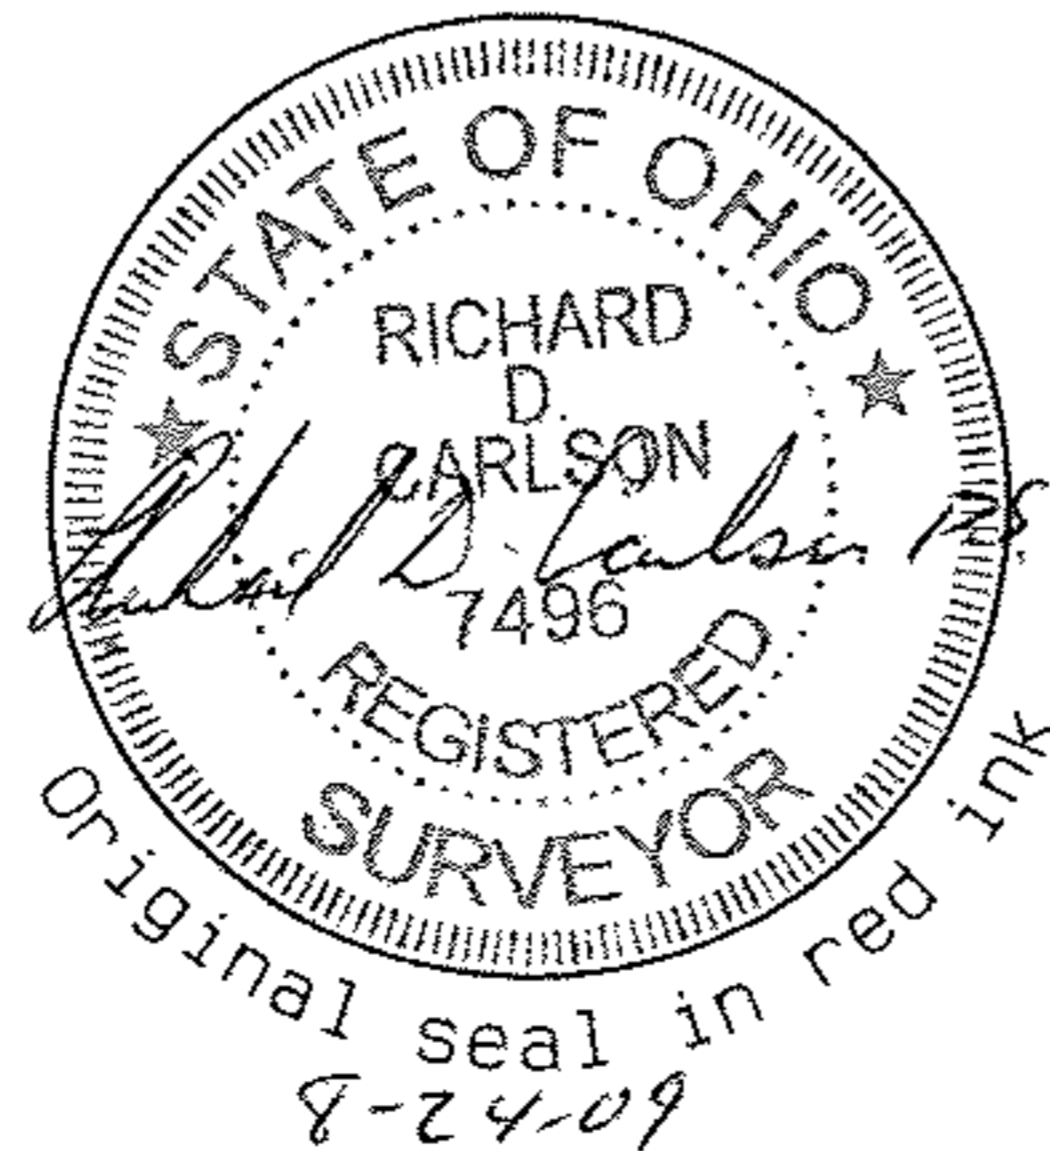


Rev. 8-24-09 add 243.62' dim.

-022
Sergio Alvarez, Jr.
Doc. 2005-0050276

-013
Sergio Alvarez, Jr.
Doc. 2005-0050276

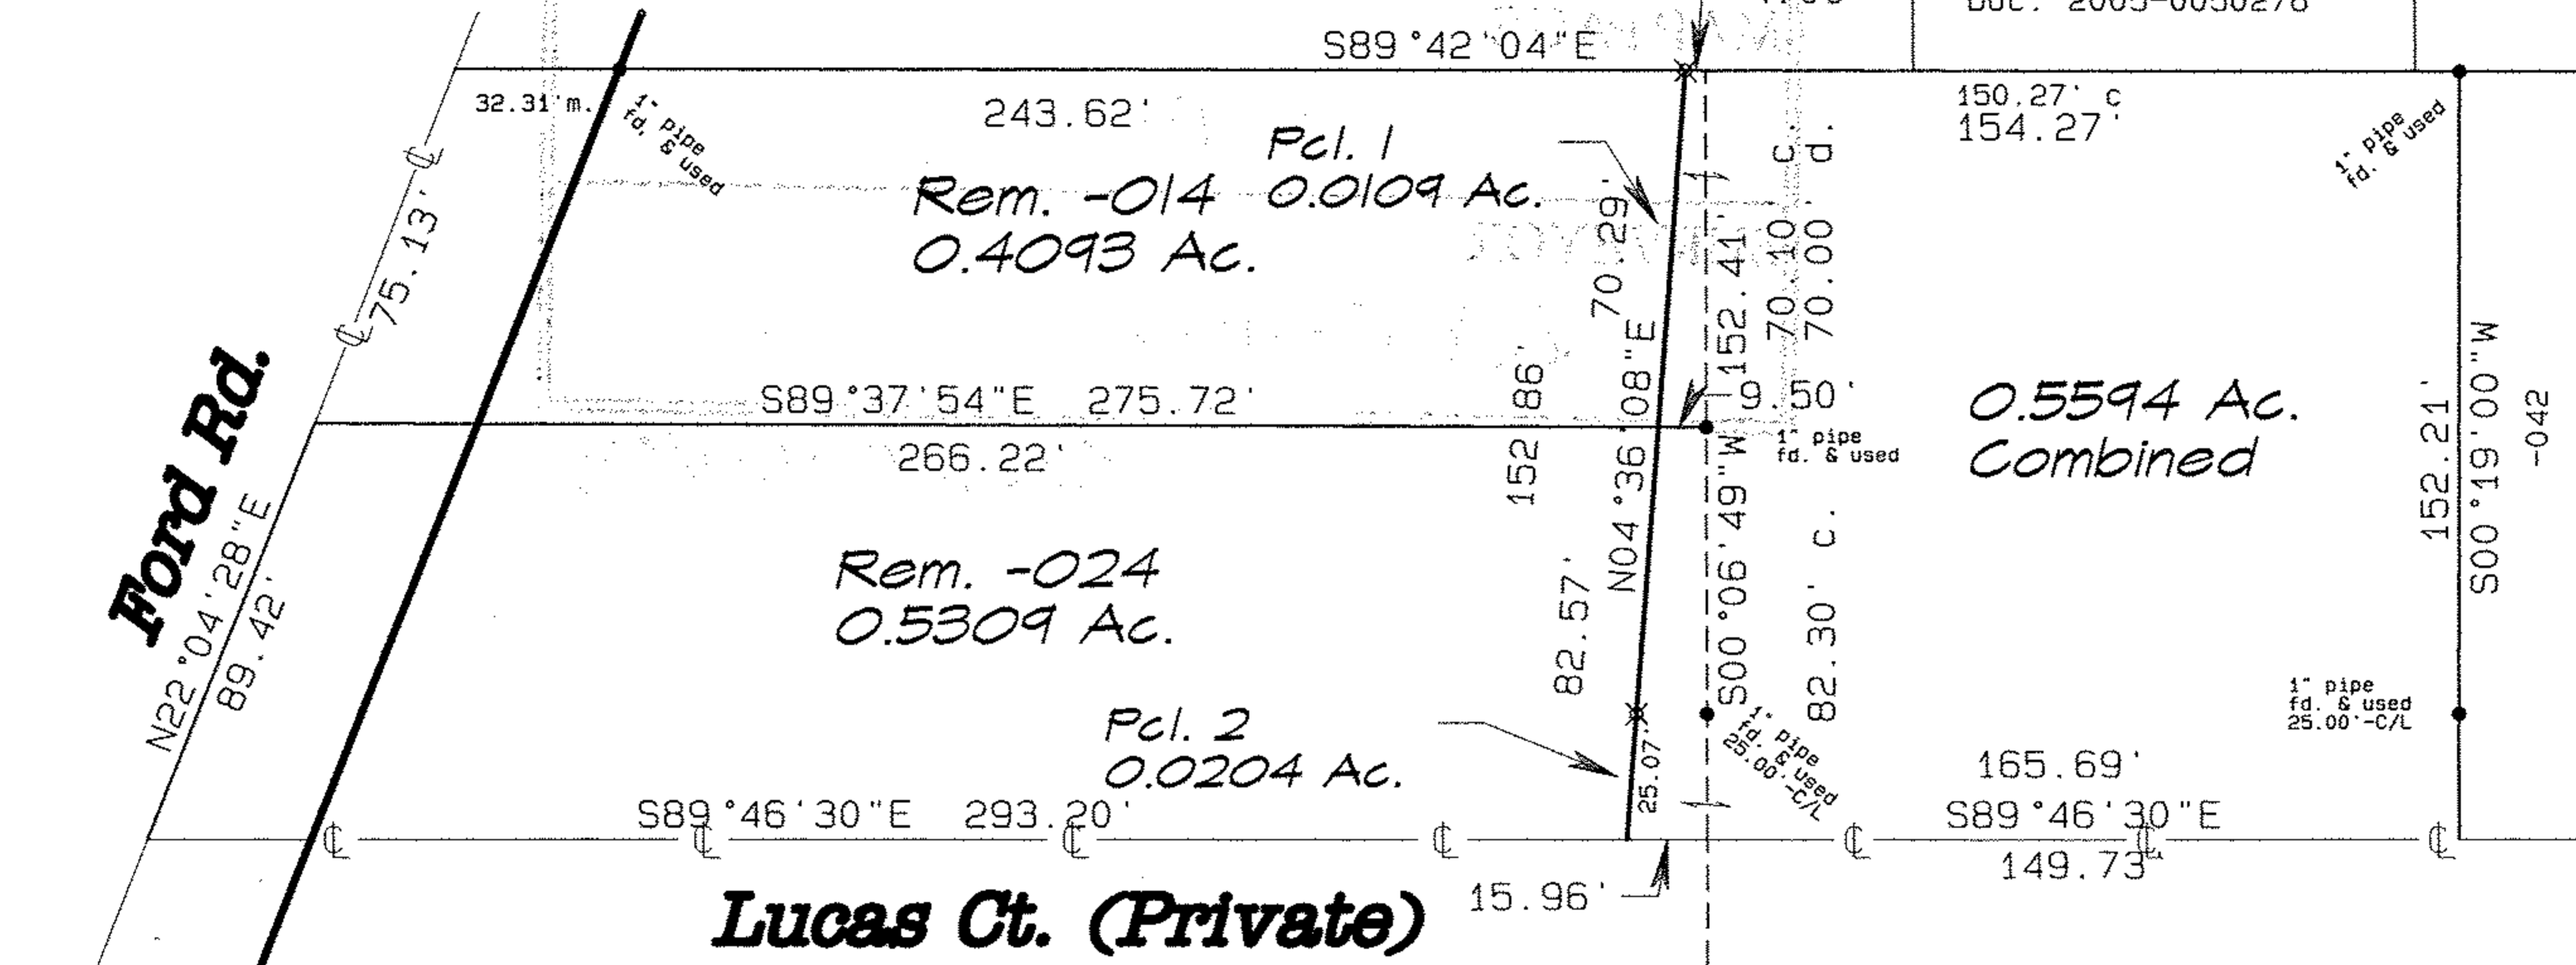

Plat of Survey

Luverne & Jean Witherell

City of Elyria Burrell & Day Tract

Elyria Twp.
Lorain Co.

8-26-08

O.L. 6
Ohio

Carlson Surveys

Job: 602-12

GRAPHIC SCALE

1"=50'

