

09-00-095-107-003 + 006
9-00-09-3

Iron Pin found

Iron Pin found

728.27 Record 728.40 Meas.

FOLLETTE STREET 40 FT

Cross in Concrete


106.14' Record
106.14' Meas.


33'

N

SOUTH PROFESSOR STREET 60 FT

SOUTH MAIN STREET 66 FT
Duesouth 1023.93' Record and Measured

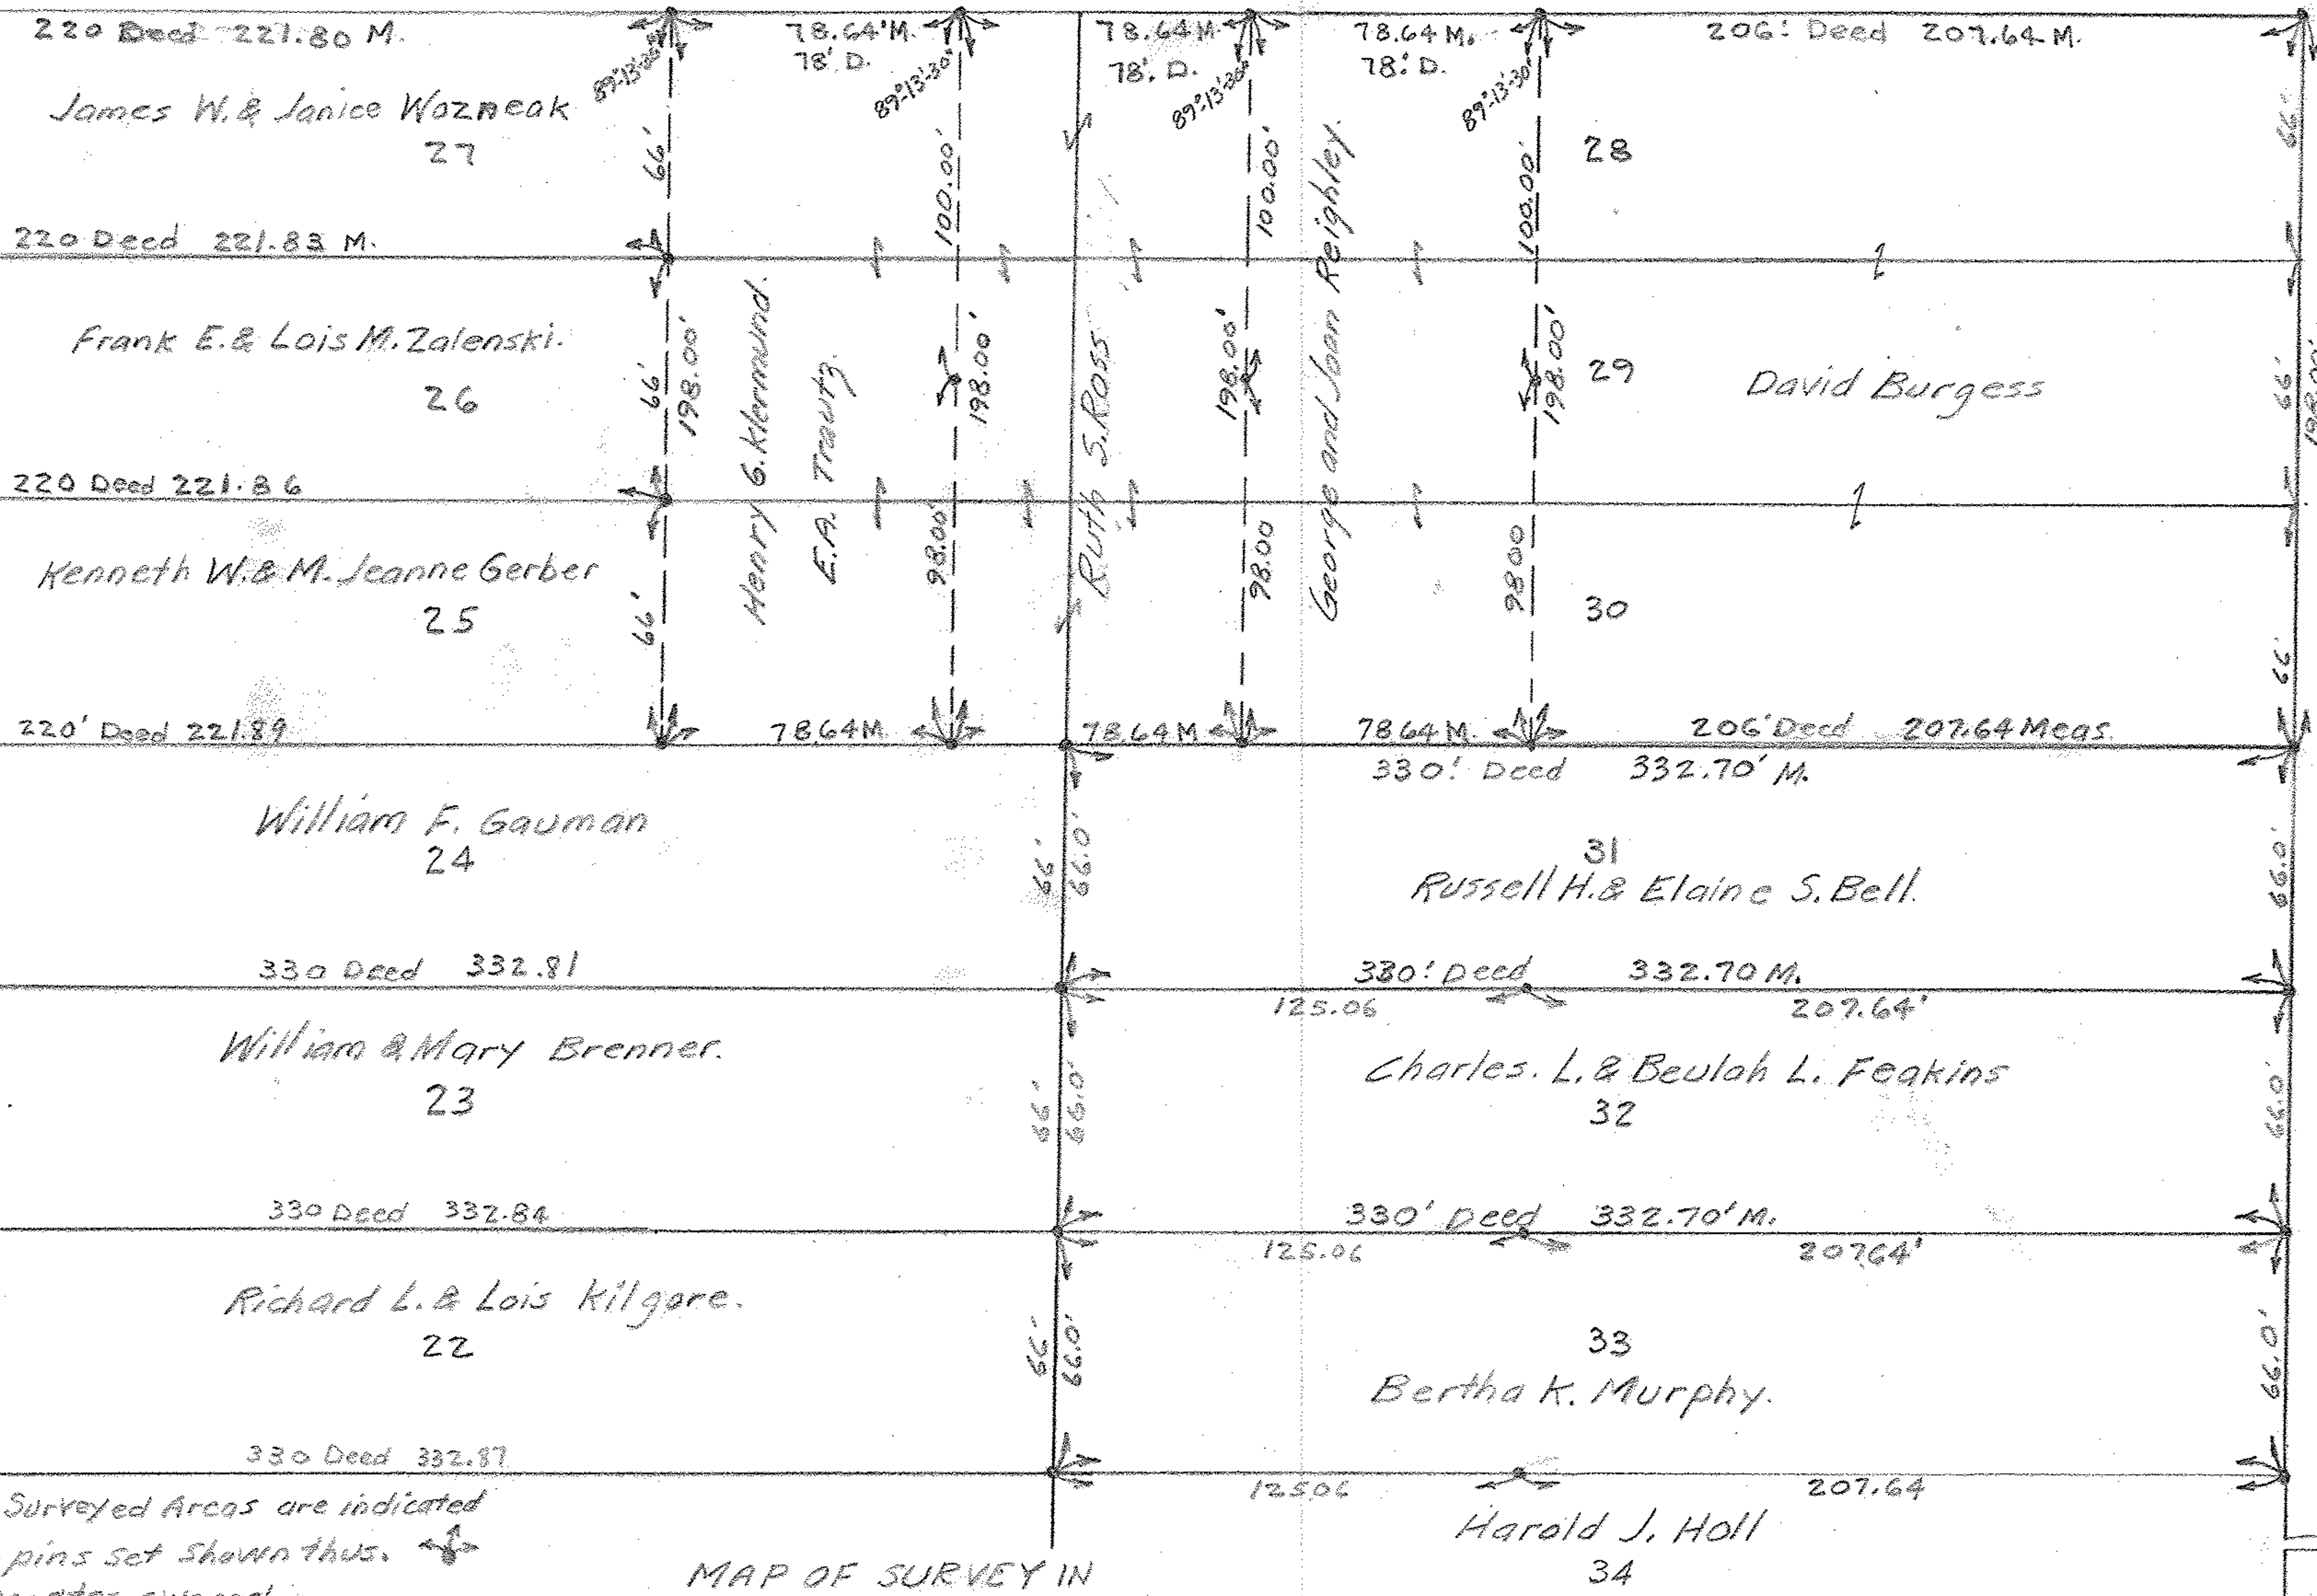

Note:- Surveyed Areas are indicated by Iron pins set Shown thus. 
VI = Denotes ownership.

MAP OF SURVEY IN
FOLLETTE FIRST ADDITION
VOLUME 2 PAGE 1 LORAIN CO. PLAT RECORD.
ORIGINAL LOT 95 RUSSIA TOWNSHIP,
OBERLIN VILLAGE LORAIN COUNTY OHIO
Scale 1" = 50' June 17-1952
G.E. Penfound Registered Surveyor

HAMILTON AVE 50'

HAMILTON AVE. 50'

Iron Pin found