

BASIS OF BEARINGS IS THE SOUTHERLY LINE OF ORIGINAL LOT NO. 6 (SOUTH 63°21'53" WEST). IRON PINS SET ARE 3/8" DIAMETER, 36" LONG WITH PLASTIC CAPS "T. SIMON, S-7775".

**0.5004 ACS.**  
 STEPHEN JAMES TO  
 HENRY BROWN  
 DT J PG 117  
 11/10/1836  
 (FOR BURIAL PURPOSES) R/W MON.  
 FD.

GREAT LAKES DEVELOPMENT, LTD.  
 DOC. #20000696886  
 7/24/2000

REMAINDER <sup>07</sup>  
 PARCEL NO. 01-00-006-000-045  
 59.0489 ACS.

MCDANIEL PROPERTY MANAGEMENT, LTD.  
 DOC. #2000087778  
 6/1/2000

LIBERTY AVE. (S. R. 6)

BAUMHART ROAD


PLAT OF SURVEY  
 FOR  
 BROWNHELM HISTORICAL  
 ASSOCIATION

APPROVED LORAIN CO. MAP DEPT
DATE 10/1/09
PAGE 1-C
BY D. Holland
#09-01833-X

BEING KNOWN AS PART OF ORIGINAL  
 BROWNHELM TOWNSHIP LOT NO. 6  
 CITY OF VERMILION COUNTY OF LORAIN  
 STATE OF OHIO

MAY, 2008 SCALE: 1" = 200'

DIMENSIONS SHOWN ON THIS PLAT ARE EXPRESSED IN FEET AND DECIMAL PARTS THEREOF. ALL BEARINGS ARE TO AN ASSUMED MERIDIAN AND ARE USED TO INDICATE ANGLES ONLY. PERMANENT MONUMENTS WERE FOUND OR SET AT ALL POINTS INDICATED HEREON, ALL OF WHICH I CERTIFY TO BE CORRECT.

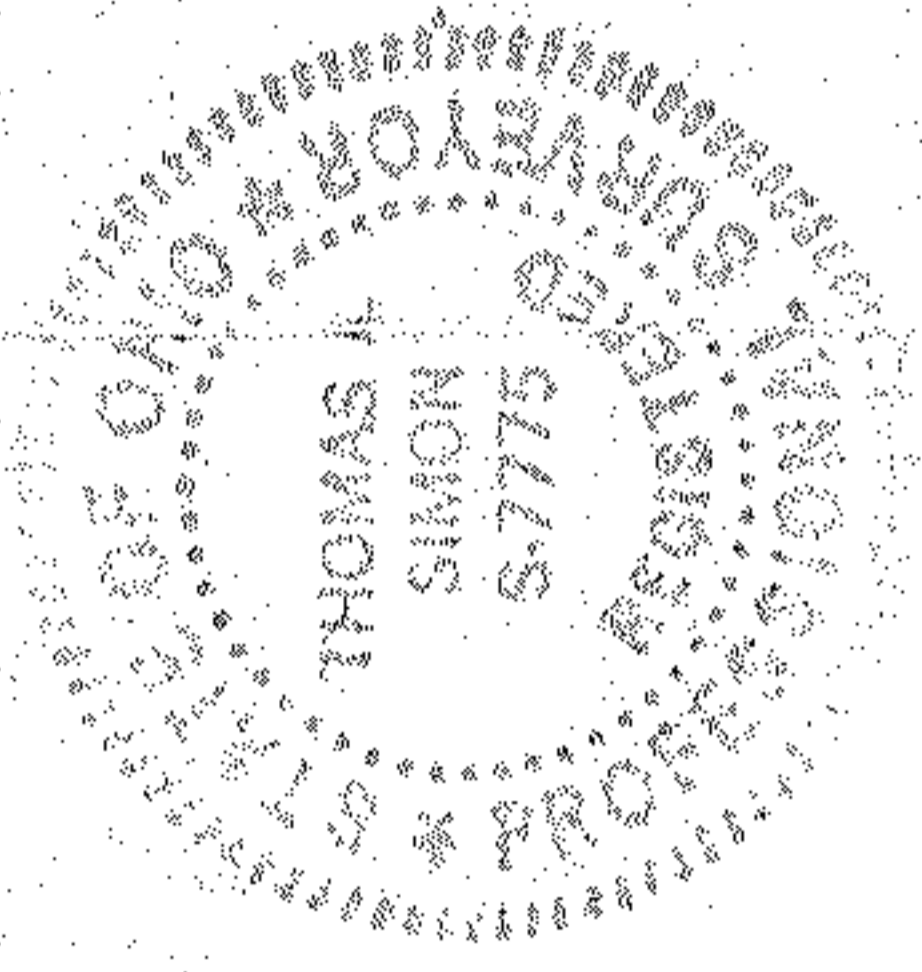

*Thomas A. Simon*  
 THOMAS A. SIMON  
 REG. PROFESSIONAL SURVEYOR  
 NO. 5-7775

THOMAS SIMON & ASSOCIATES, INC.  
 PROFESSIONAL LAND SURVEYORS  
 150 SOUTH OLIVE STREET  
 ELYRIA, OHIO 44035  
 (440) 327-2925  
 FAX 327-2964