


Plat of Survey
Ryan Allman

Eaton Twp. O.L. 3
 Lorain Co. Ohio


Carlson Surveys 9-9-09

Job: 1101-30R

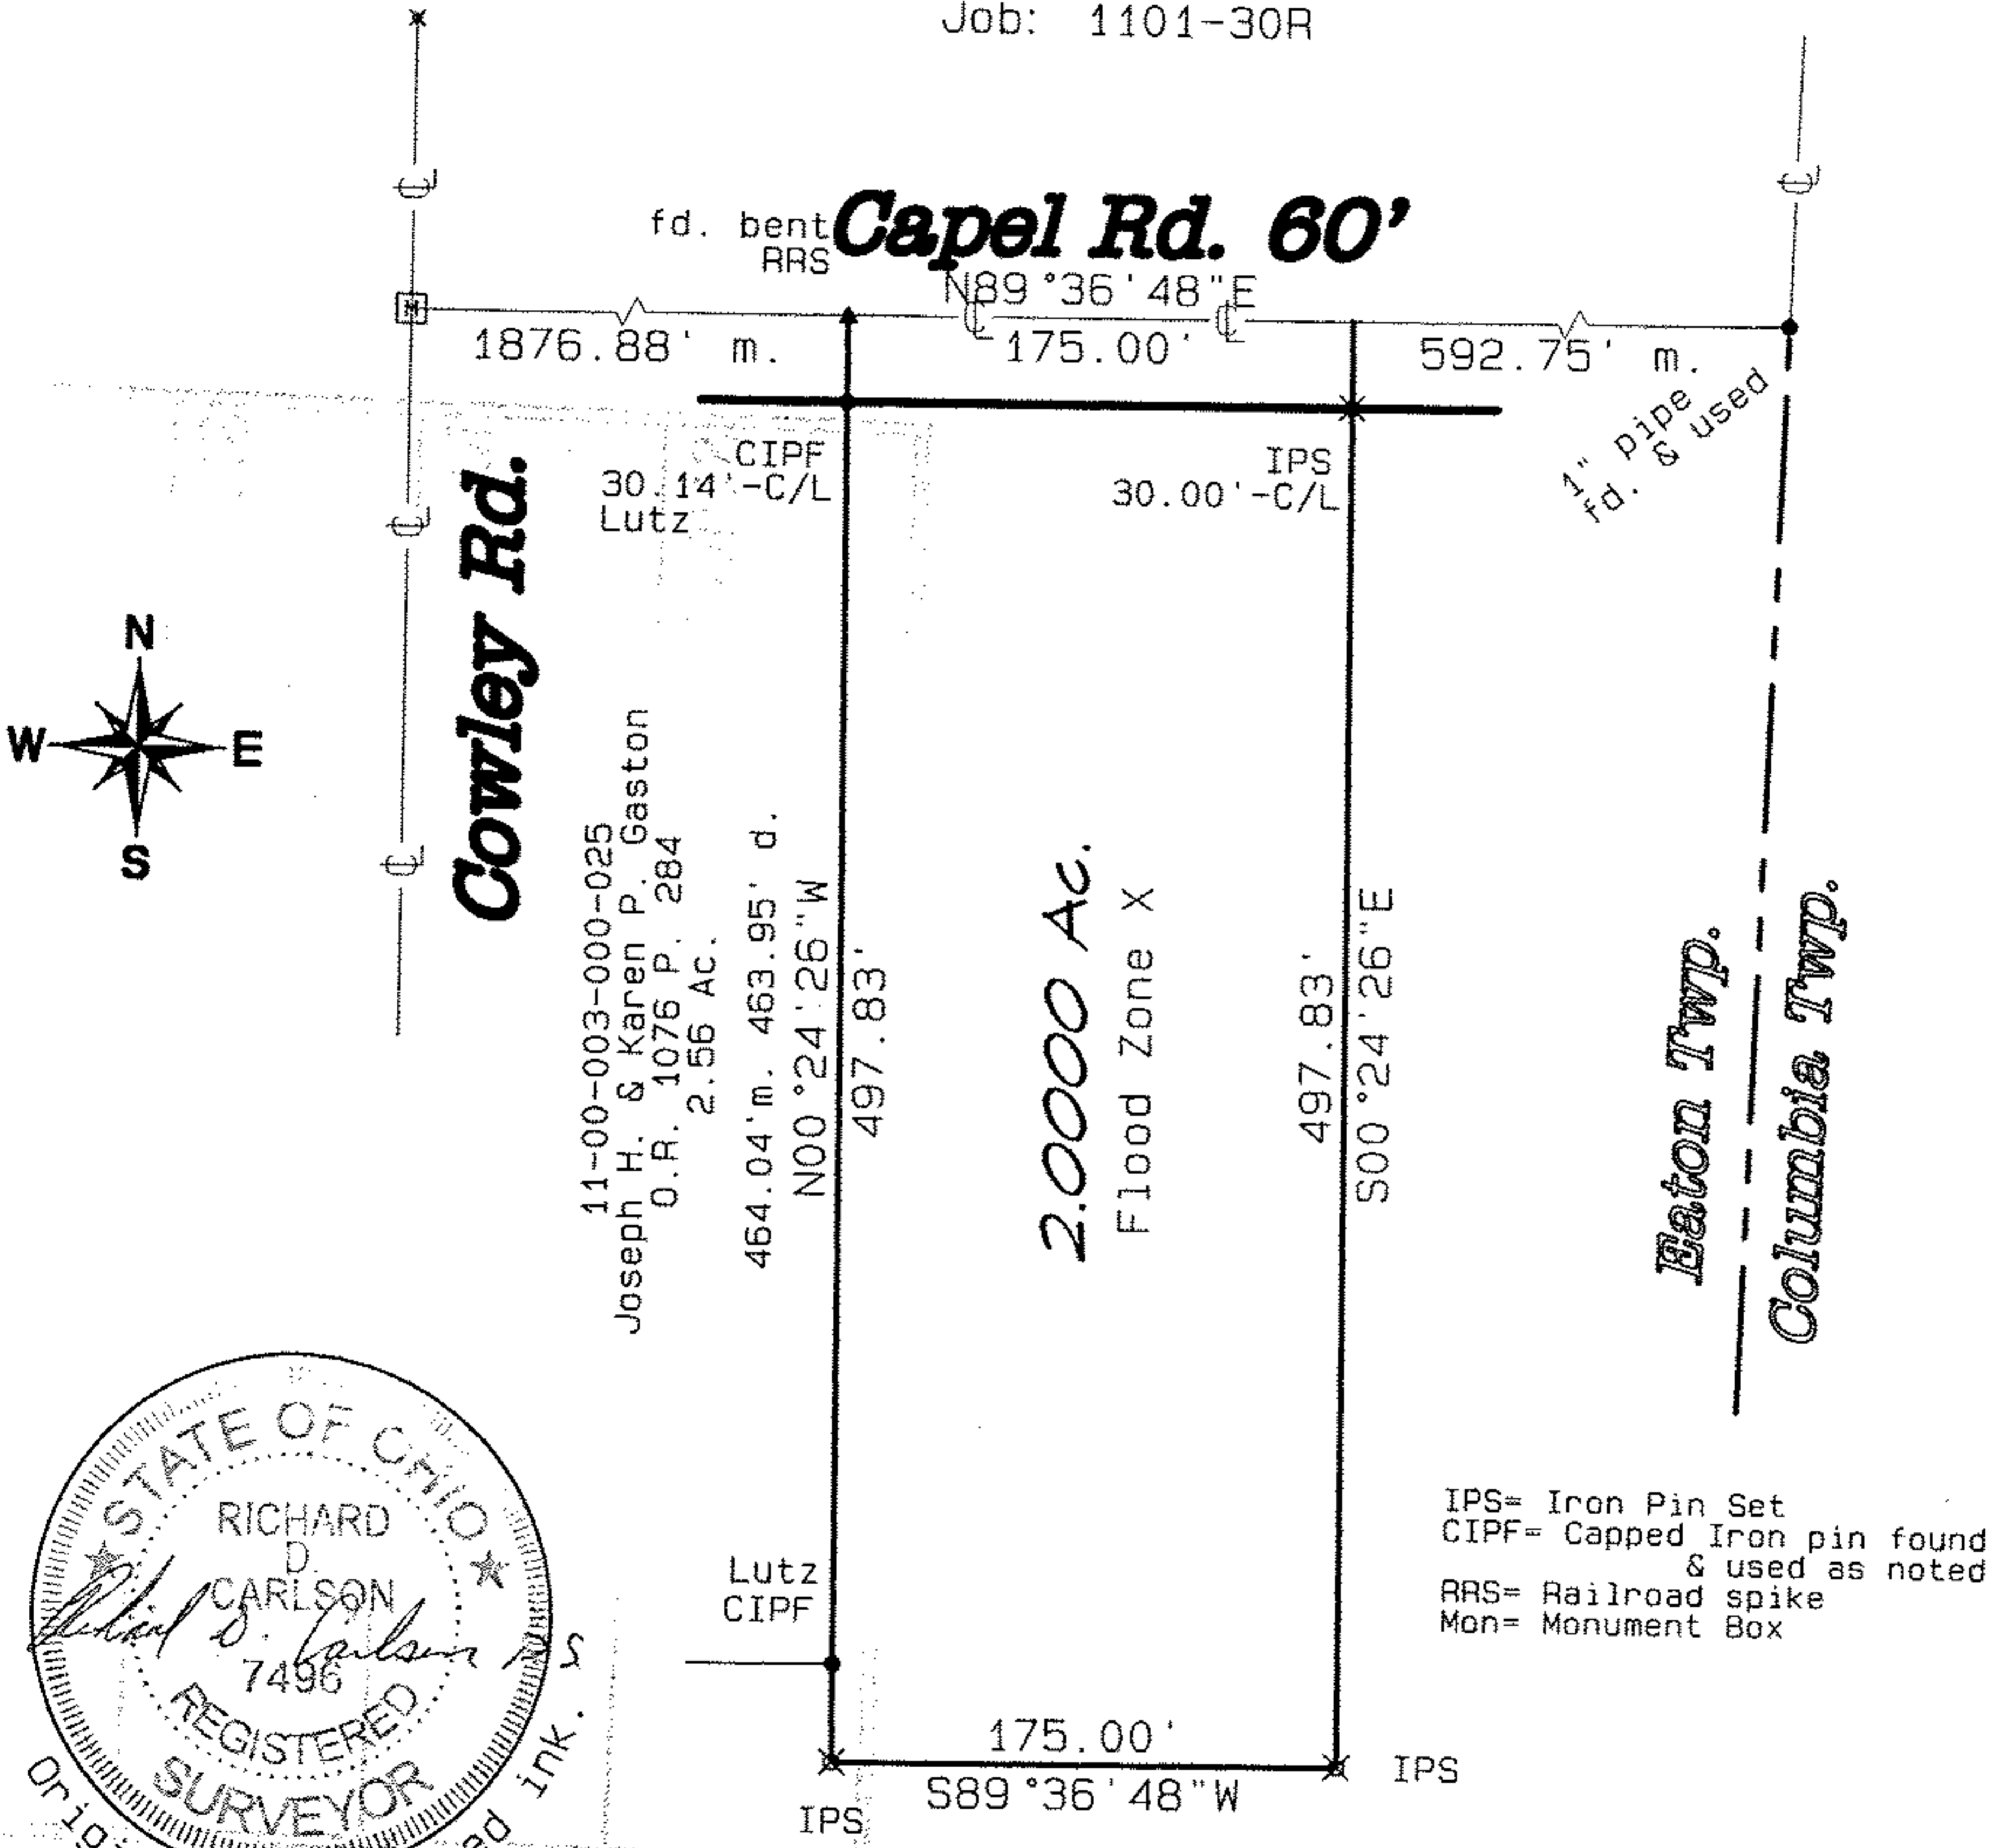

IPS= Iron Pin Set
 CIPF= Capped Iron pin found & used as noted
 RRS= Railroad spike
 Mon= Monument Box

Remainder 11-00-003-000-040
 Laura Bishop, Trustee 59.43 ac. By Auditor

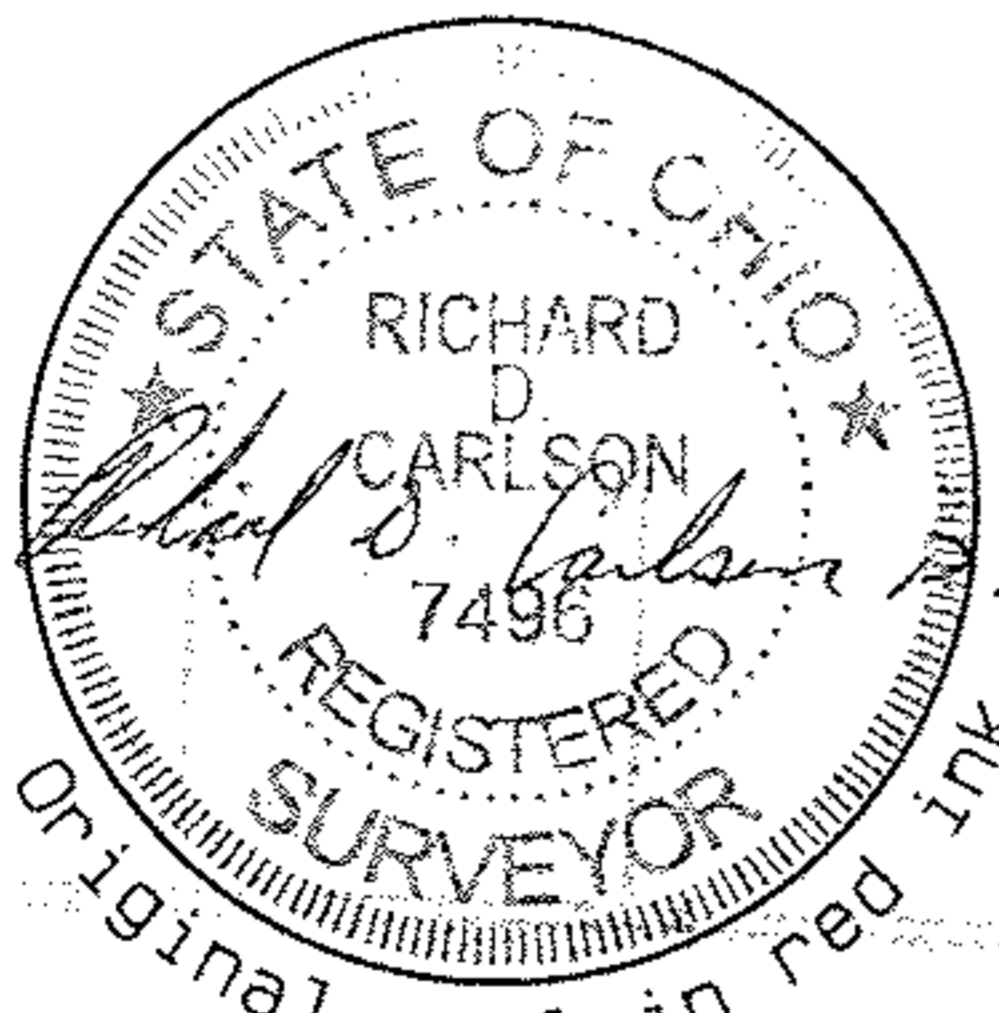

Original seal in red ink.
 9-16-09

GRAPHIC SCALE 1"=100'

