


NORTH CENTRAL DRIVE - 50'

LEGEND
 ● = IRON PIN FOUND
 ○ = IRON PIN SET

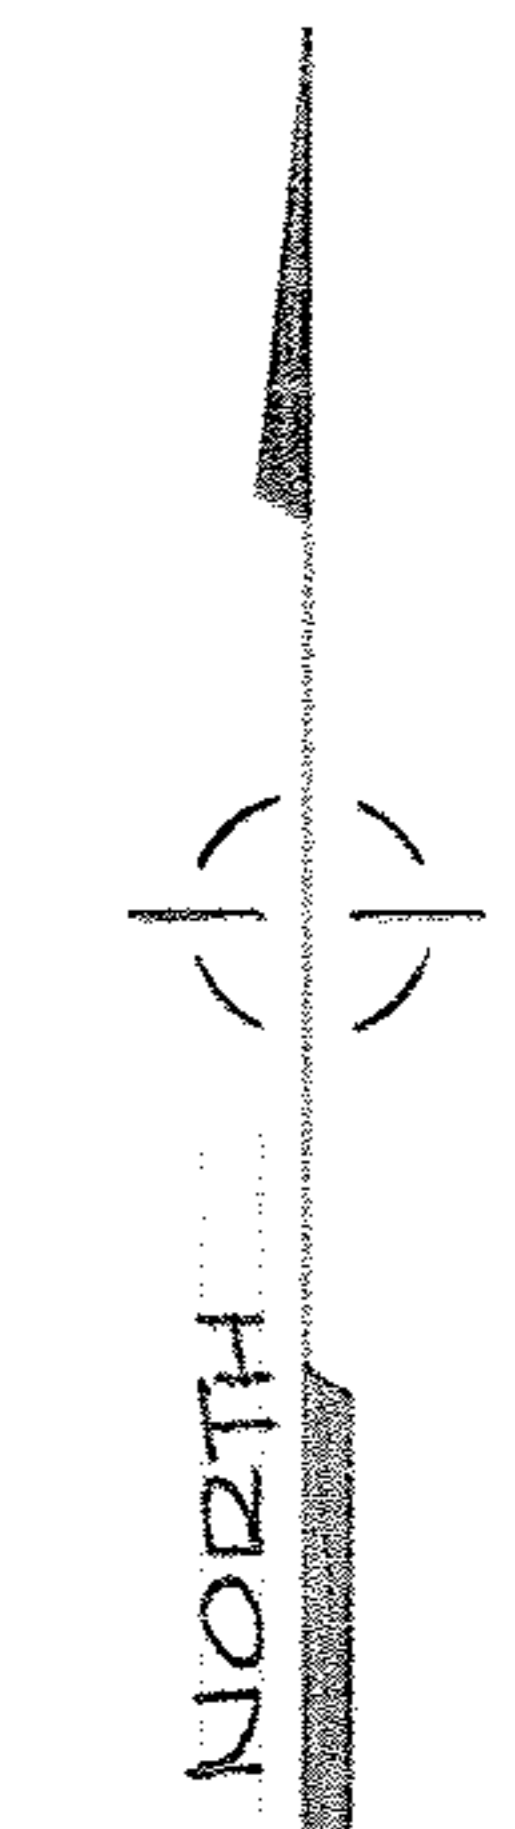

MAP of PROPERTY SURVEY & BUILDING LOCATION

SUBPLOT No. 2 in CENTRAL PARK SUBDIVISION - PLAT VOL. 70, PAGE 3
 PART of ORIGINAL BLACK RIVER TOWNSHIP LOT 6, TRACT 1
 CITY of LORAIN LORAIN COUNTY OHIO

02-01-006-159-026
 02-01-006-F

SCALE: 1"=10'

McGLINCHY and ASSOCIATES INC.
 PROFESSIONAL ENGINEER and SURVEYORS
 110 1/2 MIDDLE AVE. ELYRIA, OHIO
 JUNE, 1981 #816819

756007