

WEST 29TH ST. 60'



4" Gas Approx. Location

BROADWAY 80'

12" Water
15' Sanitary
15' Sewer

30" - 0.38% Grade
Curb connections to San. Sewer
Line 28th St. 321.7 to So. Line 28th St. 59.92
Line 28th St. 283.8 to So. Line 28th St. 59.87

60.33 Stone and Conc.
60.15
60.63

150.00'

150.00'

150.00'

150.00'


138.00'

138.00'

138.00'

138.00'

North Line East 30th Street

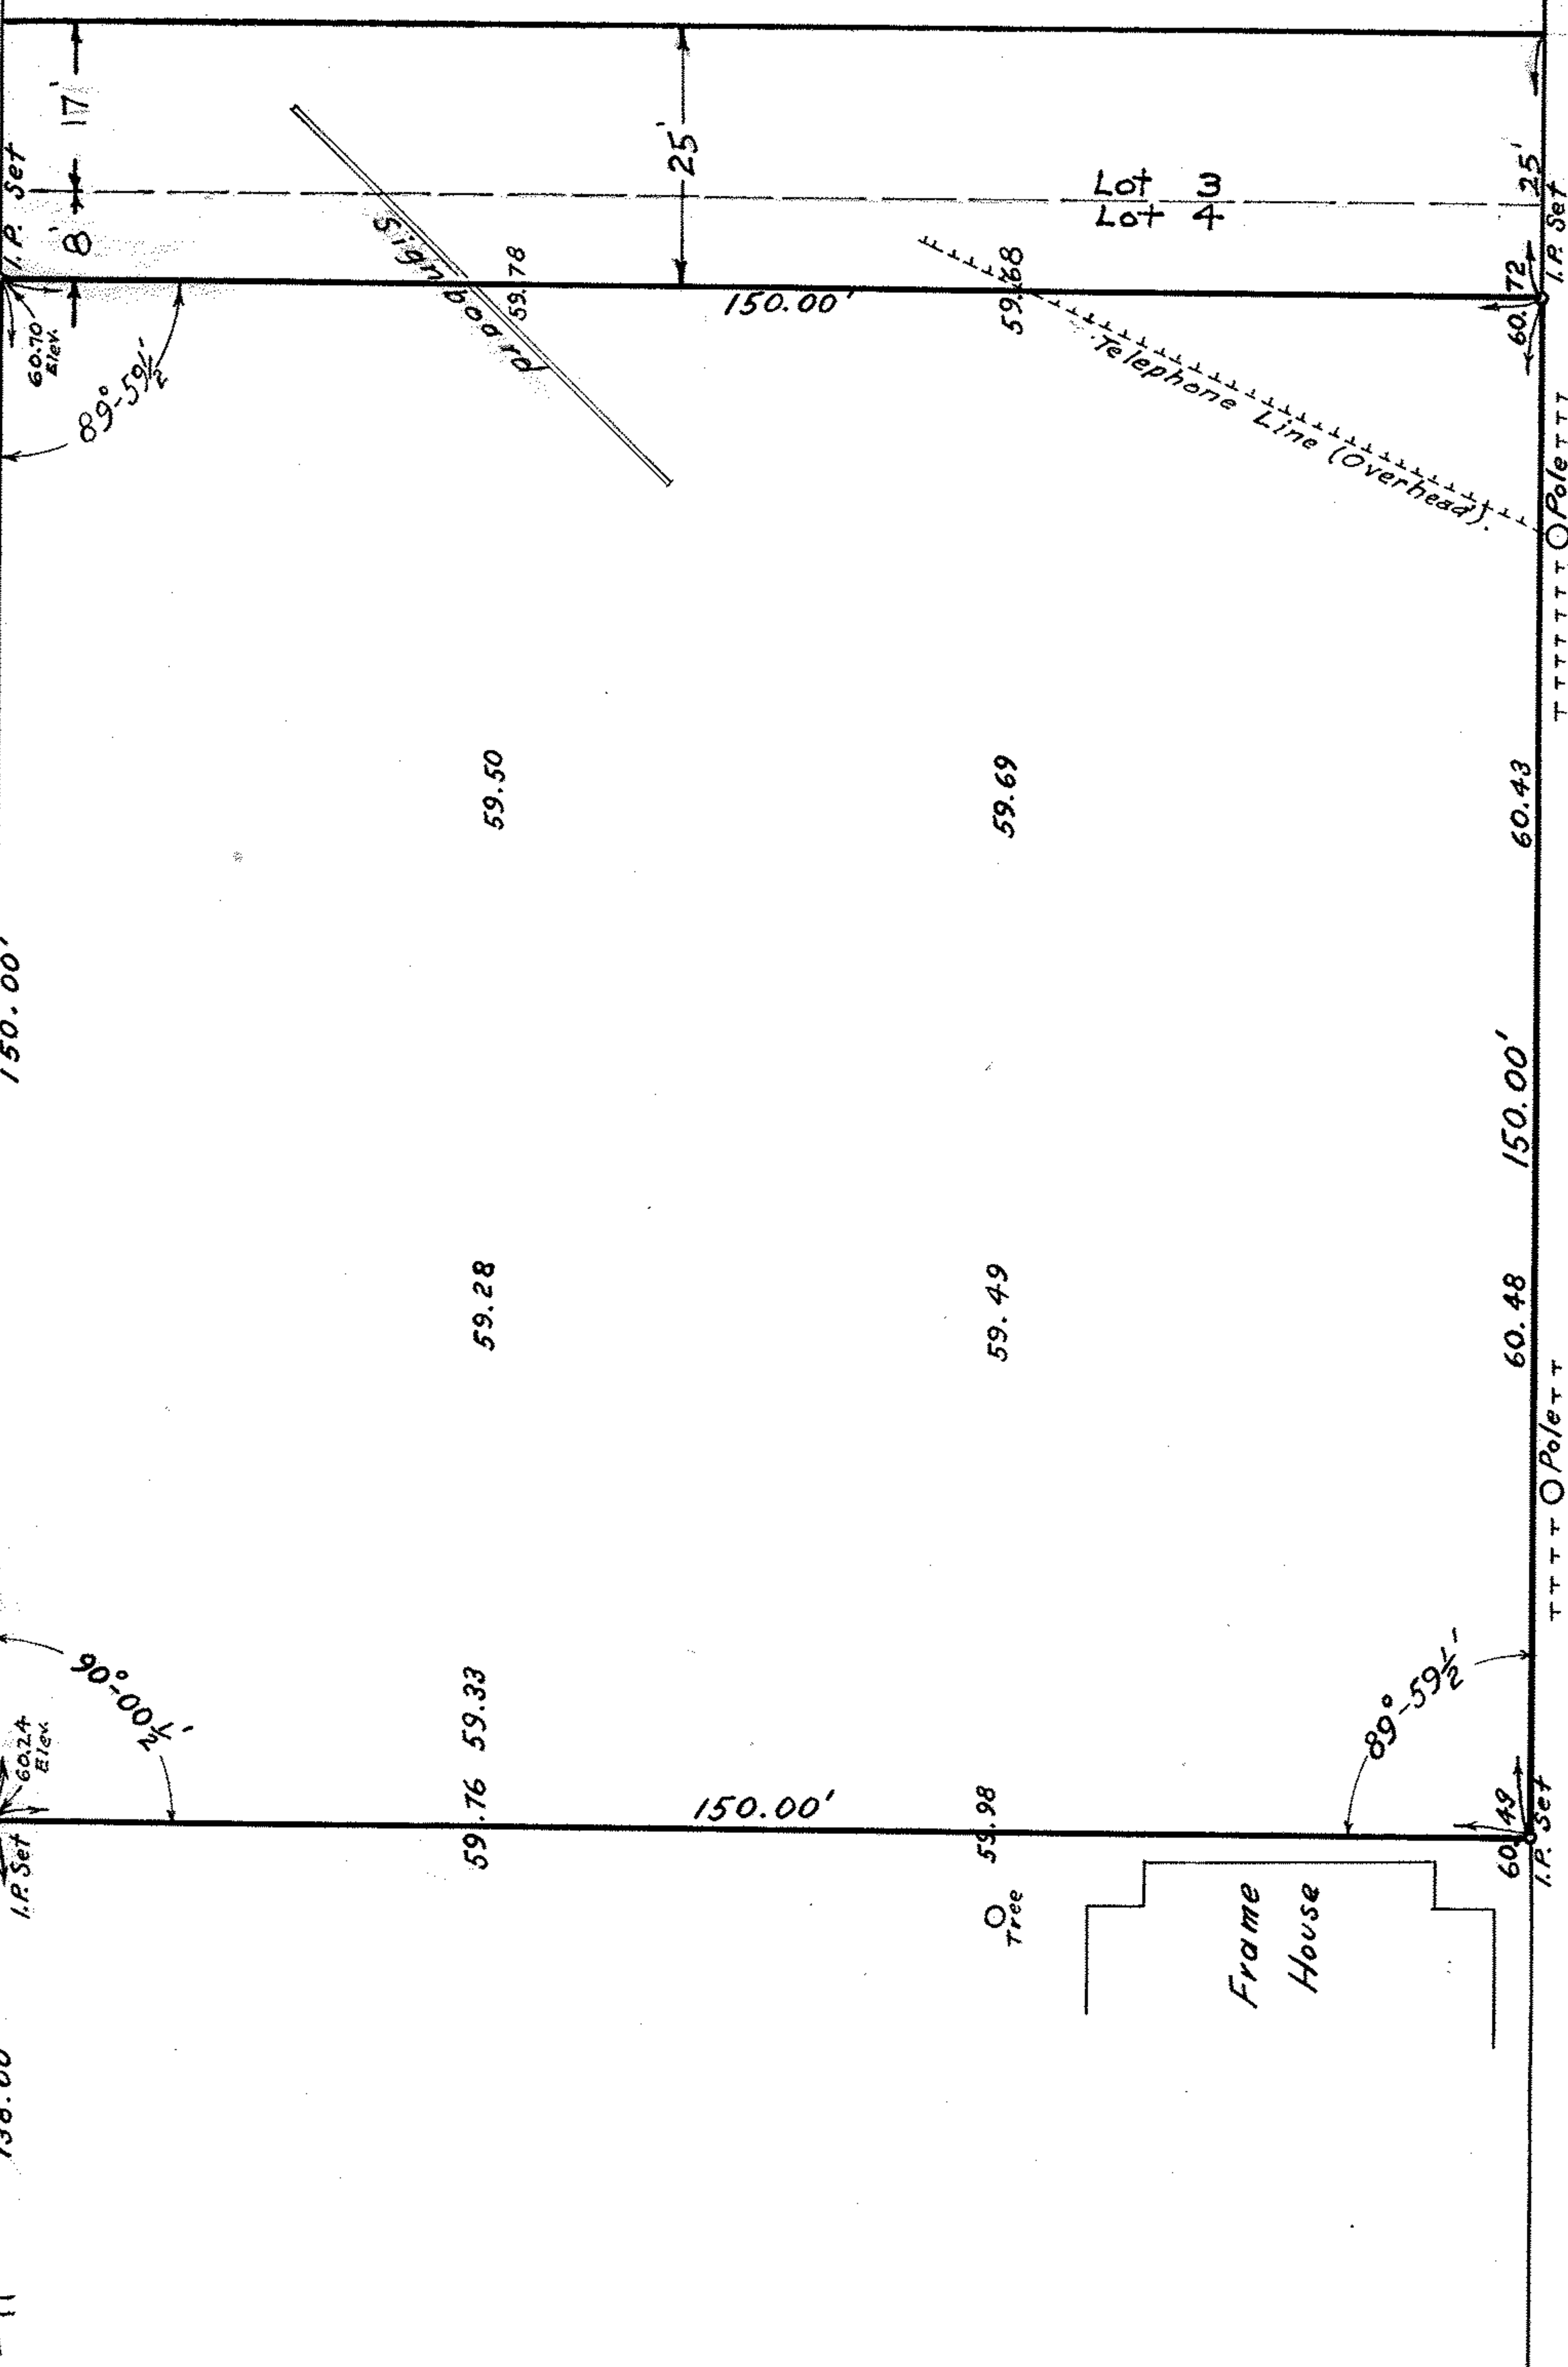

TTTTT Pole

Lot 3
Lot 4

60.72
I.P. Set

TTTTT Pole
Tel. Co. M.H. 60.38
Telephone in Conduit

60.61

ALLEY 15'

60.63

TTTTT Pole

60.58

60.48

60.43

TTTTT Pole

60.43

60.38

TTTTT Pole

Note: For telephone, gas, or electric service see the respective companies.

MAP OF SURVEY OF ALL OF LOTS 5 AND 6 AND PARTS OF LOTS 4 AND 7 IN BONSOR BROTHERS ADDITION IN CITY OF LORAIN SHOWING THE LOCATION OF SEWER, WATER, AND GAS LINES, AND ELEVATIONS. MADE FOR THE SLOVAK SYNDICATE COMPANY

LORAIN, OHIO JAN. 13, 1950
SCALE 1" = 20'
J. B. NICHOLS - REGISTERED SURVEYOR

Revised: 12/9-55

To show addition of southerly 17' of Lot 3 and the northerly 8' of Lot 4, Bonsor Bros. Addition