

19-01-060-000-011
19-H 012

R.L. & D.M. WOLF
1164/233

19-01-060-000-011
T.M. DC. 19-H

- Set 3/4" x 30" rebars with aluminum caps
- Recovered steel pins
- ▷ Recovered 3/4" rebars with aluminum caps

RESEARCH DATA


Deeds: 580/231 86/104 1164/233
0741/0086 562/650
1111/366

NOTE: This tract to go to adjoiner.


M. BRASSE
1111/366



Boundary Survey
for
Imre Torok
in
Lot 60
Tract 1
Range 17W, Township 3N
Penfield Township
Lorain County
Ohio
September 27, 1995
Revised: November 20, 1995
Scale: 1"= 300'

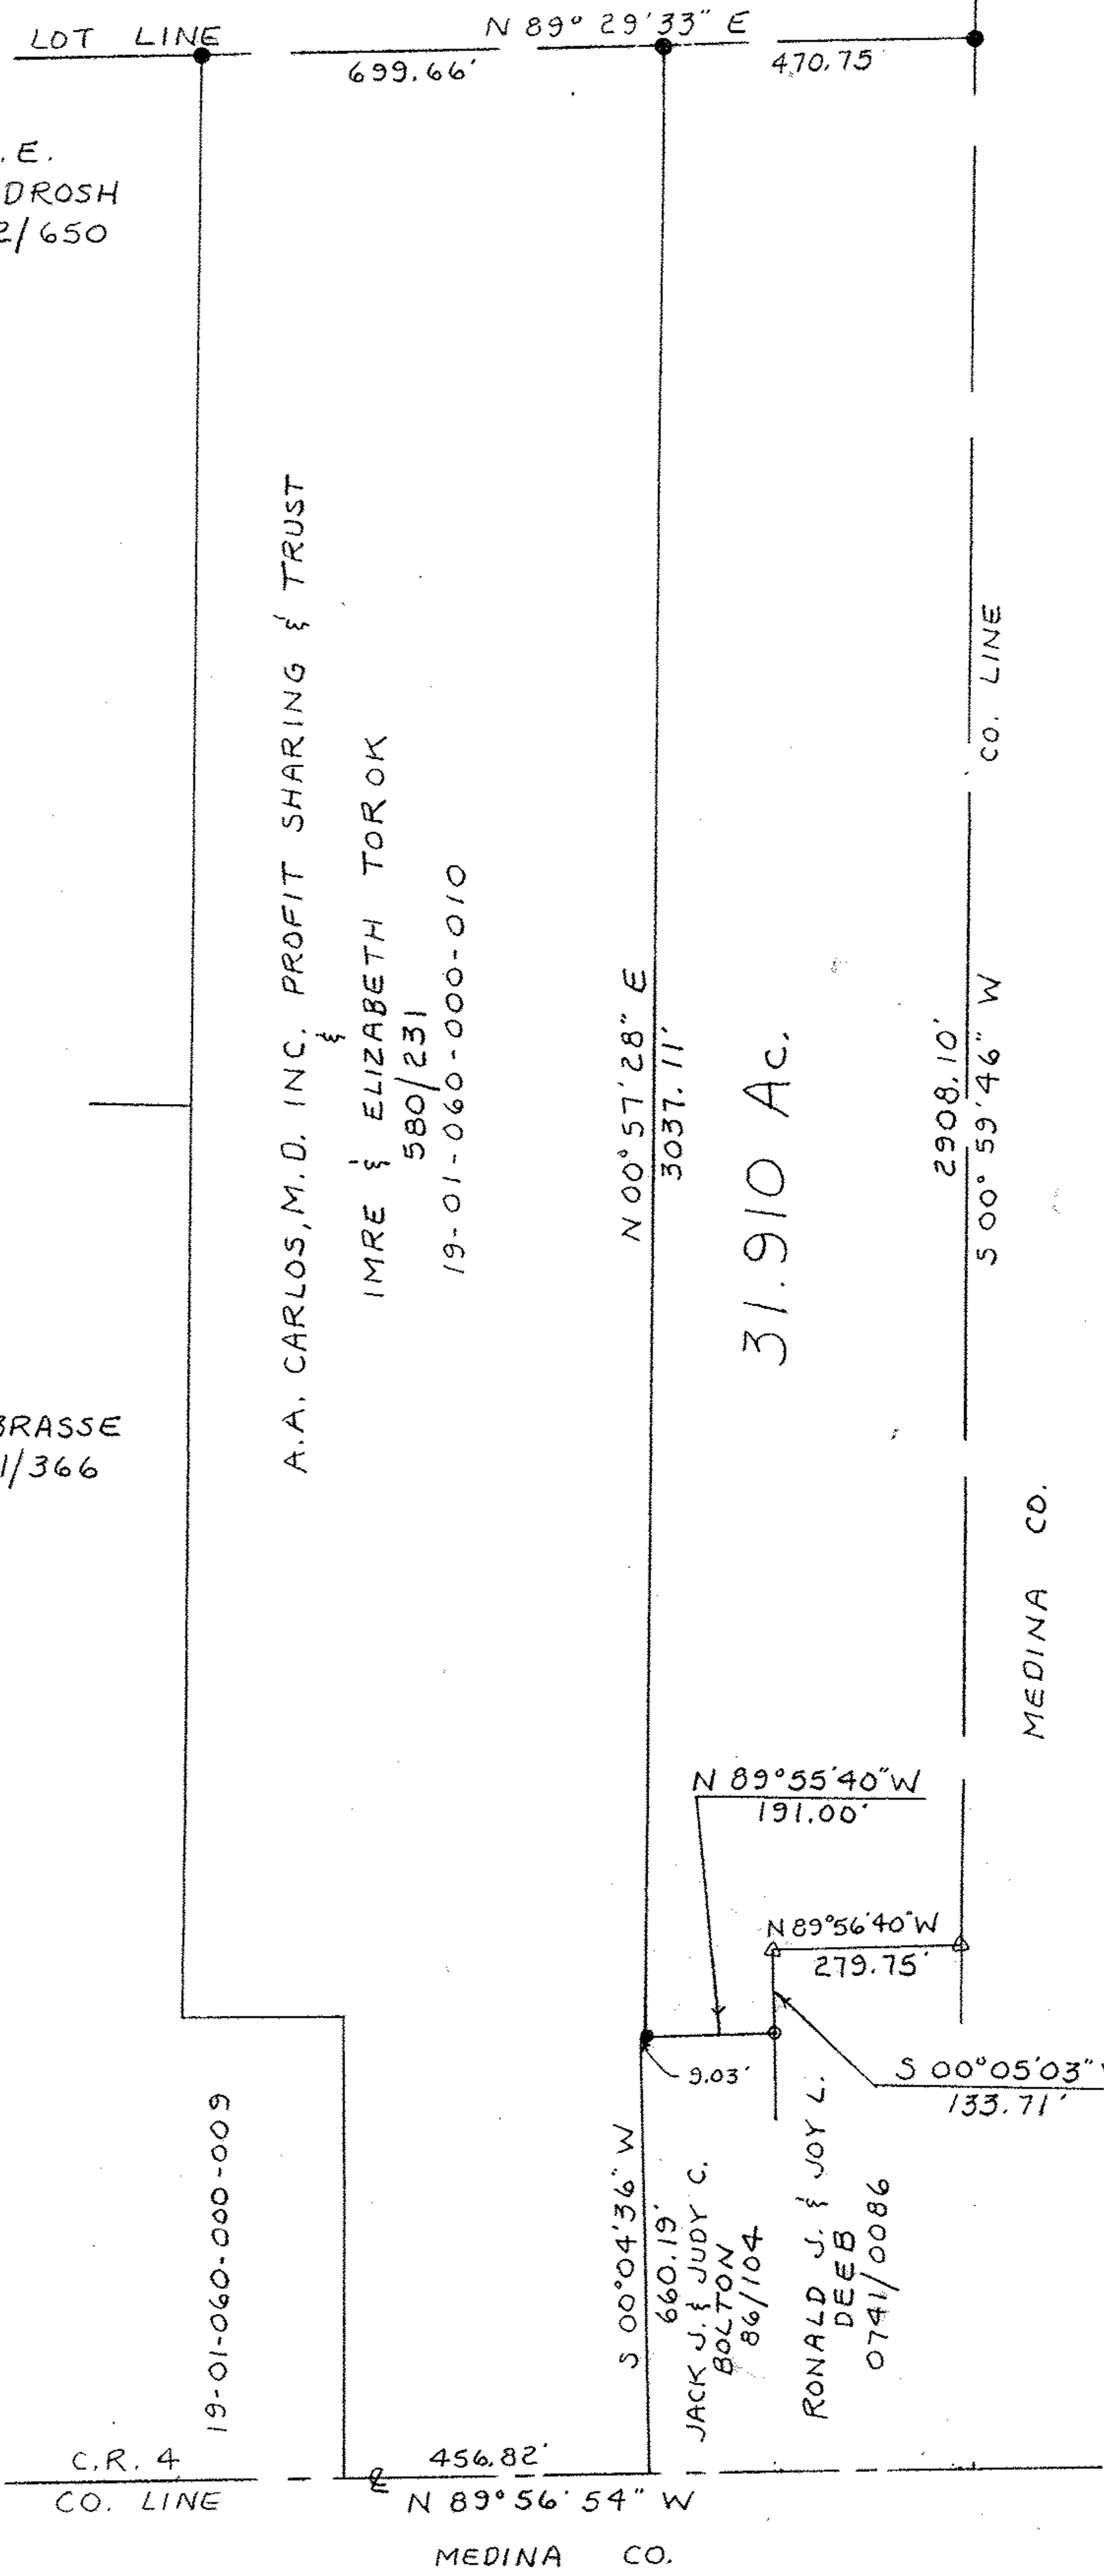

NORTH BASED ON DEED 86/104

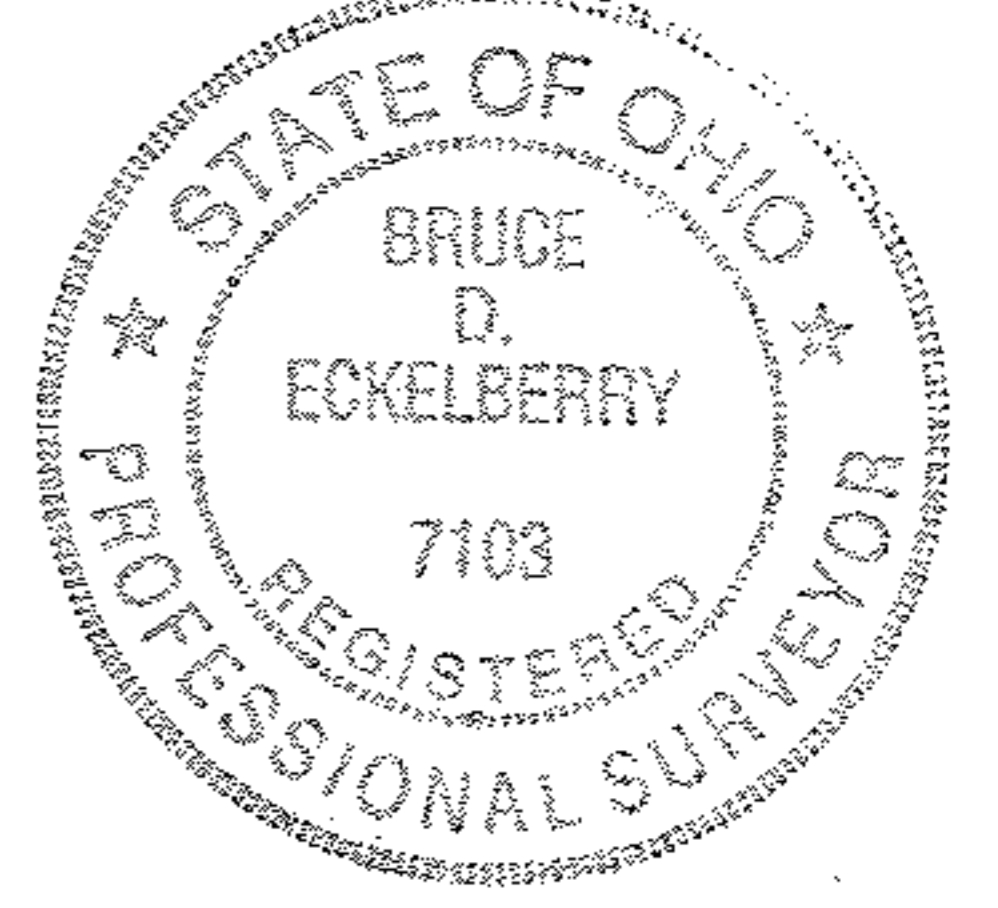

Prepared By
AMERICAN PRECISION SURVEYING
450 S. 4th St. (614) 622-2783
COSHOCKTON, OHIO 43812

Bruce D Eckelberry
Registered Professional Surveyor No. 7103

W/SH