


29/2/94

M.B. w/ I.P. USED IN AUG. 1973 NO LONGER
IN PLACE. F.K. Spk FOUND 0.35' S. OF E

WEBSTER ROAD 60'

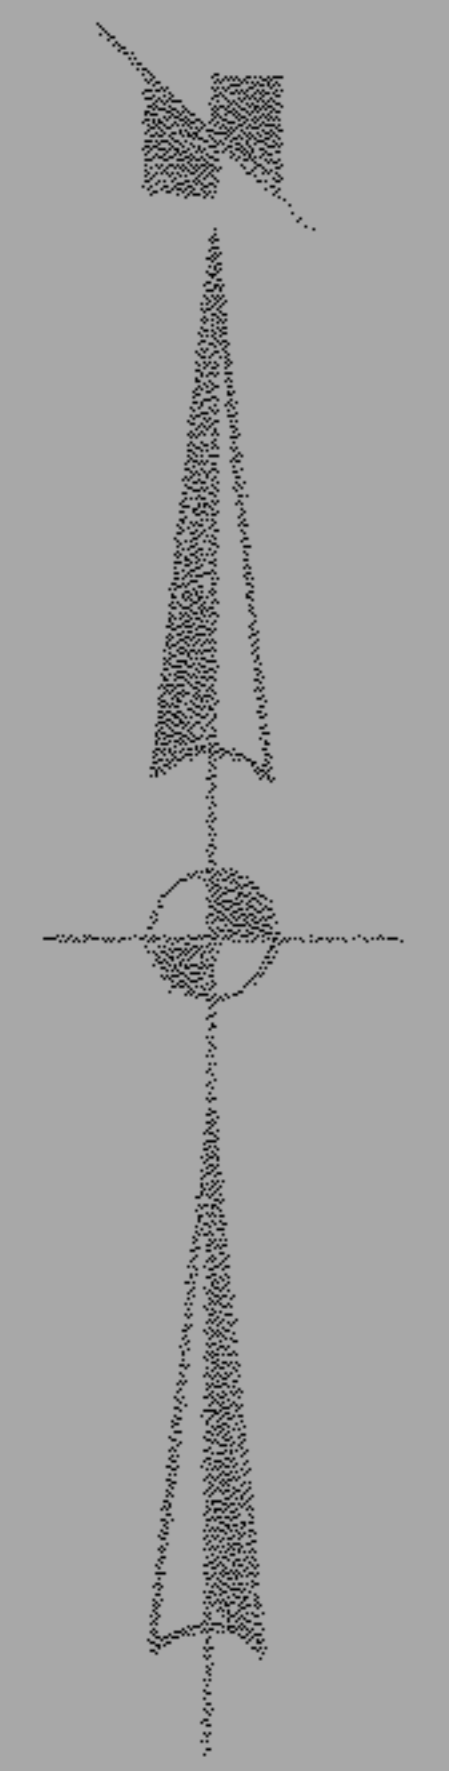

O.L. 111

N. 0° 51' 30" W. 1247.15' E

O.L. 110

N. 0° 51' 30" W. 1244.23' E

N. 0° 51' 30" W. 1242.06' E

N. 0° 51' 30" W. 1239.89' E

N. 0° 51' 30" W. 1237.25' E

① 9.7160 Ac.

② 7.1345 Ac.

③ 7.1220 Ac.

④ 8.5300 Ac.

I.P. Bd. Bent
Re-Set 30.00' E

339.76

N. 88° 44' 00" E.
250.00

1139.76'
250.00

300.00

1460.06' m.

I.P. Bd. 0.80' E.
29.70' E

I.P. Set

I.P. Set

I.P. Set

339.79

I.P. Set 250.025'
S. 88° 14' 09" W.

I.P. Set 250.025'
1140.32'

300.03'

I.P. Bd. & Used

1" Square I.P. Bd. Used

MICHAEL A. & LORI J. PISANELLI
O.R.V. 831 P. 129

SURVEY FOR
TAMMY L. QUILLEN
PART OF O.L. 110 SEC. 6 TOWNSHIP OF PENFIELD
COUNTY OF LORAIN STATE OF OHIO
SCALE 1" = 100' AUGUST, 1994

LAUNDON • SIMON • CAHL & ASSOC.
ENGINEERS SURVEYORS
94-2625 FB. 233 P. 35-36

