



William & Rita Woodford

2.69 Ac.


0.90 Ac.

John & Frances Tomaszewski

Gladys D. Williams

Steve F. & Theresa Bosmeny

Survey of 0.90 Ac. Parcel  
For C.A. Tomski  
Of the John & Frances Tomaszewski Farm  
In Part of Original Carlisle Section No. 8  
Lorain County Ohio  
Scale 1" = 100' February 16, 1959  
J.H. Getz Reg. Engineer and Surveyor

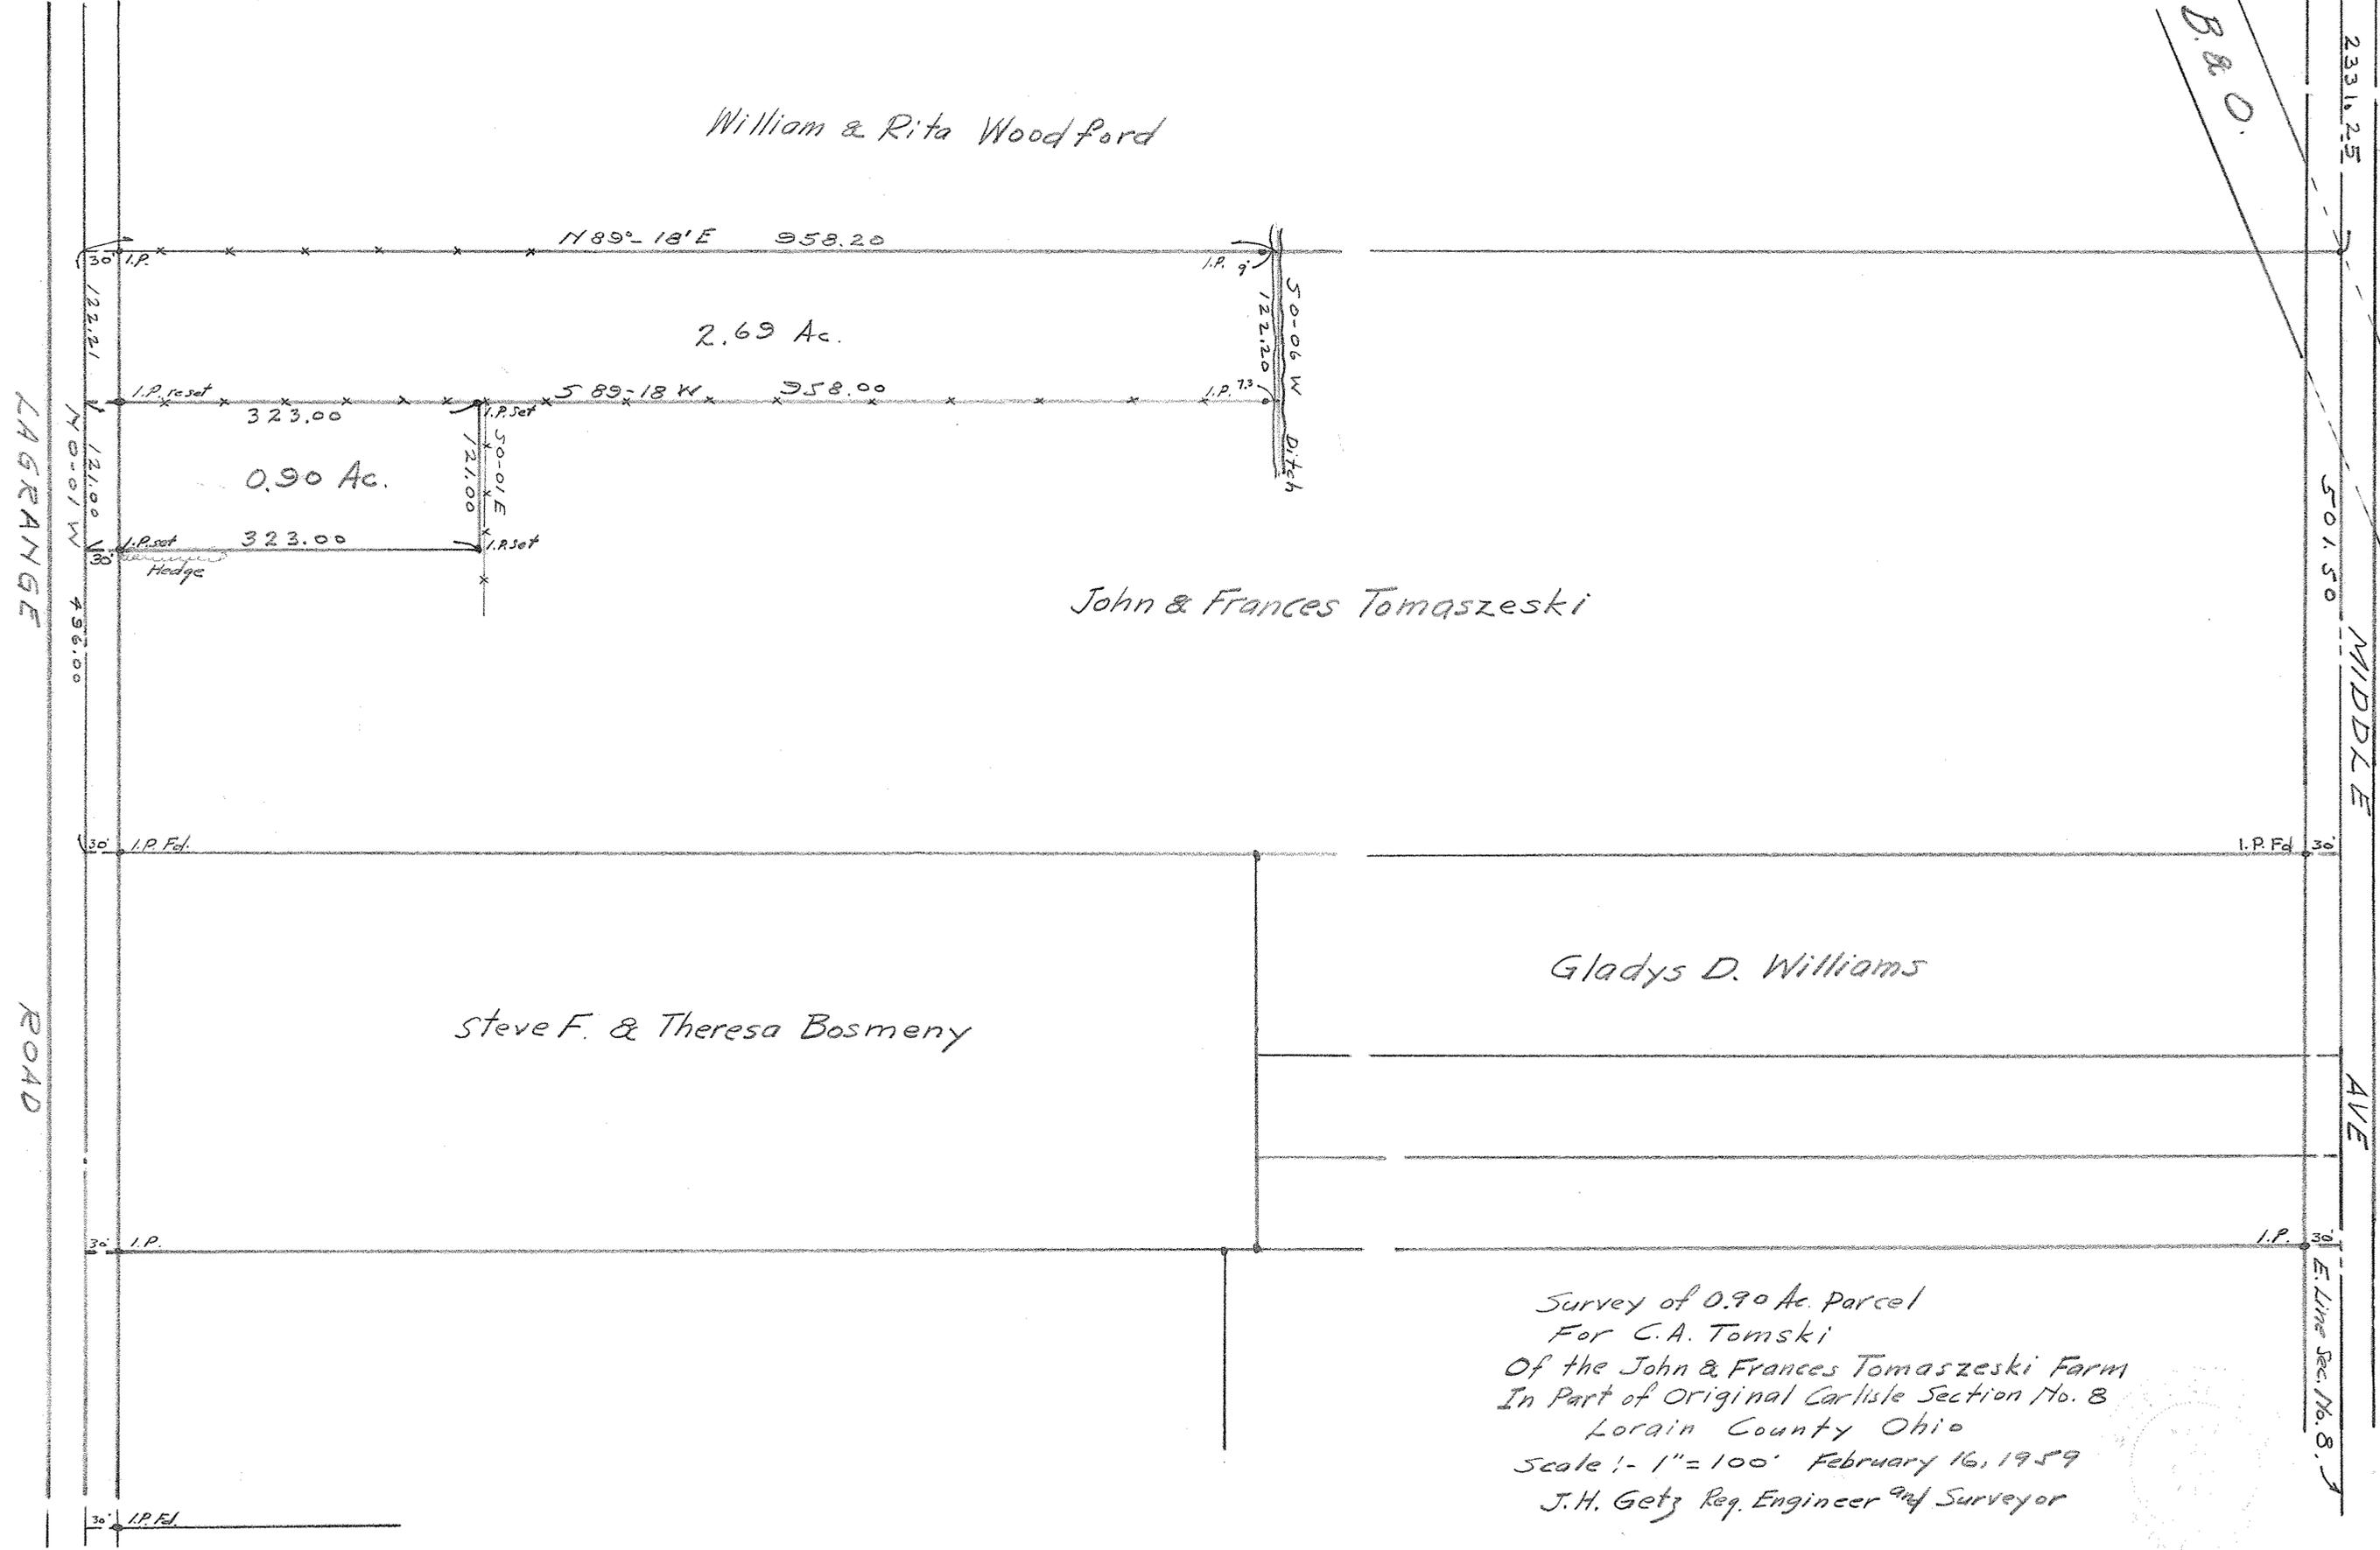

LAGRANGE ROAD

ROAD

MIDDLE AVE

P.R.

B.R.O.

2331.25

501.50

E. Line Sec No. 8

30' I.P.

I.P. reset

I.P. set Hedge

30' I.P. Fe.

30' I.P.

30' I.P. Fe.

I.P. set

I.P. set

I.P. 9'

I.P. 7.5'

I.P. Fe.

I.P.

30'

122.21

121.00

498.00

323.00

323.00

589-18 W

323.00

1189-18 E

958.20

958.00

50-06 W

122.20

121.00

30'

30'

30'

2331.25

501.50

E. Line Sec No. 8