


# Sheffield Lake Village

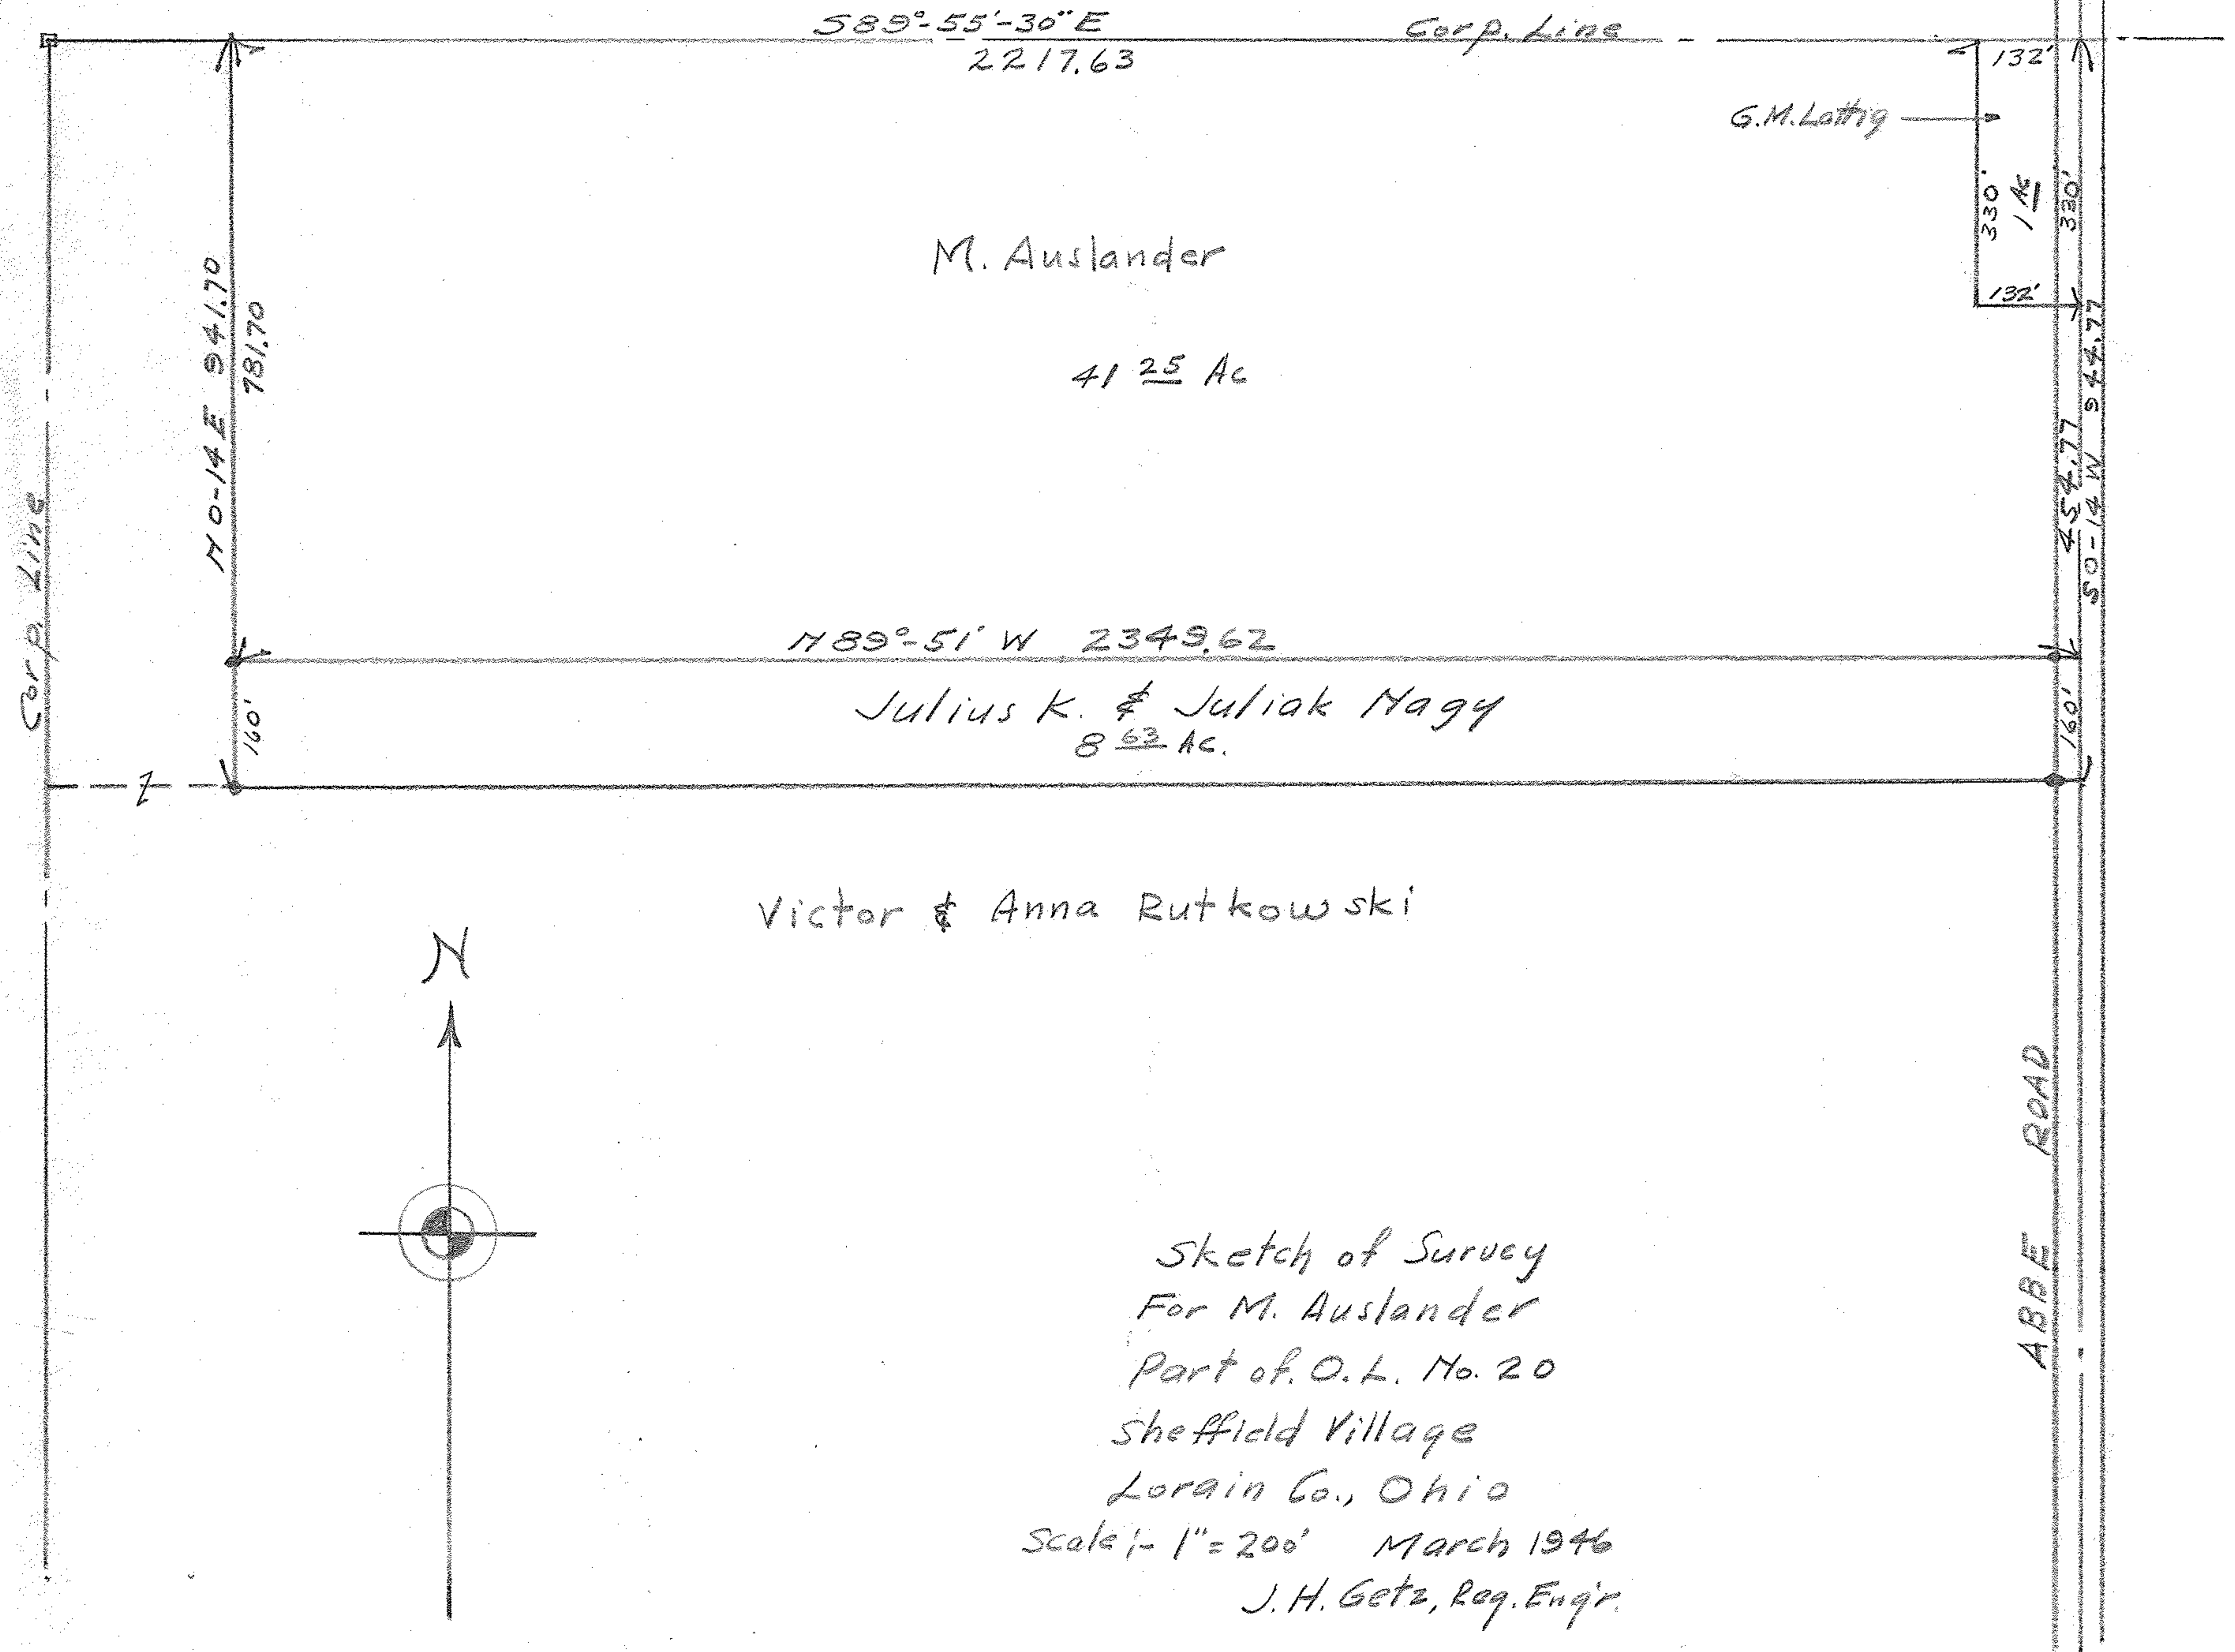

M. Auslander

41 25 Ac

1789°-51' W 2349.62

Julius K. & Juliak Nagy  
8 63 Ac.

Victor & Anna Rutkowski

Sketch of Survey  
For M. Auslander  
Part of O.L. No. 20  
Sheffield Village  
Lorain Co., Ohio  
Scale 1" = 200' March 1946  
J. H. Getz, Reg. Eng'r.