


04-00-013-000-004
04-00-013-8

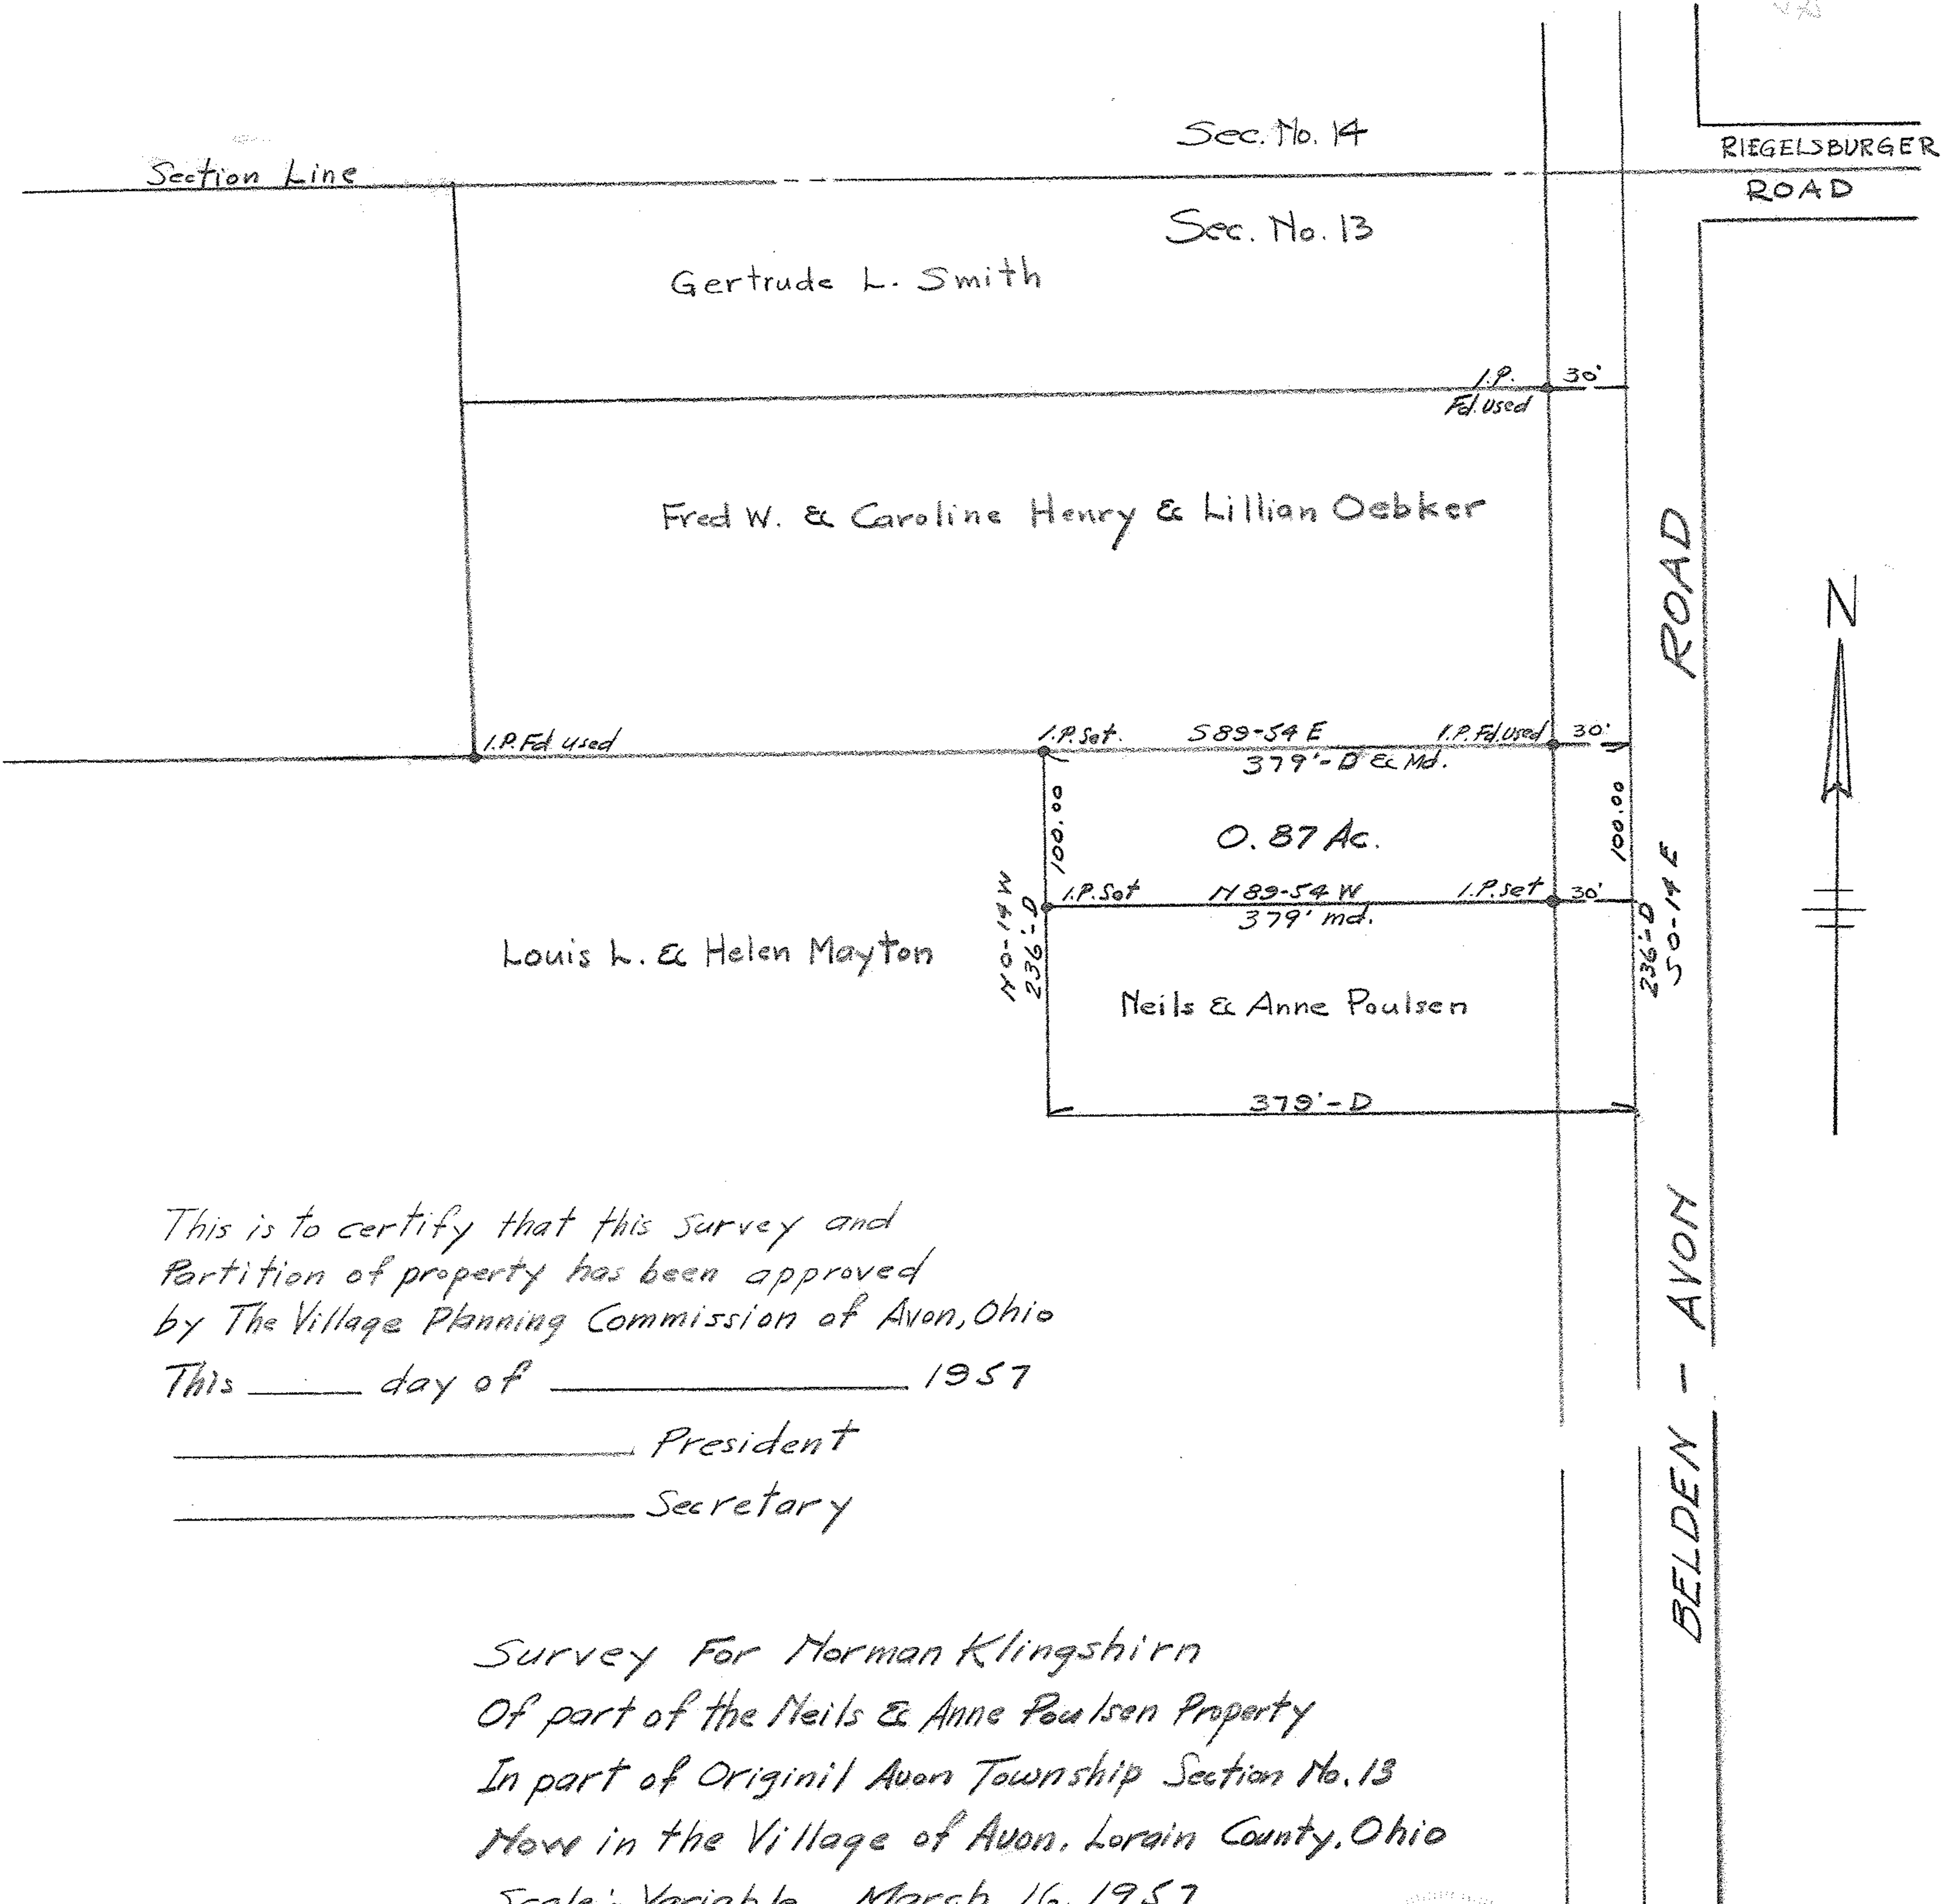

This is to certify that this survey and
Partition of property has been approved
by The Village Planning Commission of Avon, Ohio

This _____ day of _____ 1957

President

Secretary

Survey For Norman Klingshirn
Of part of the Neils & Anne Poulsen Property
In part of Original Avon Township Section No. 13
Now in the Village of Avon, Lorain County, Ohio
Scale:- Variable March 16, 1957
J. H. Getz, Reg. Engineer & Surveyor



13