


BLOCK Y

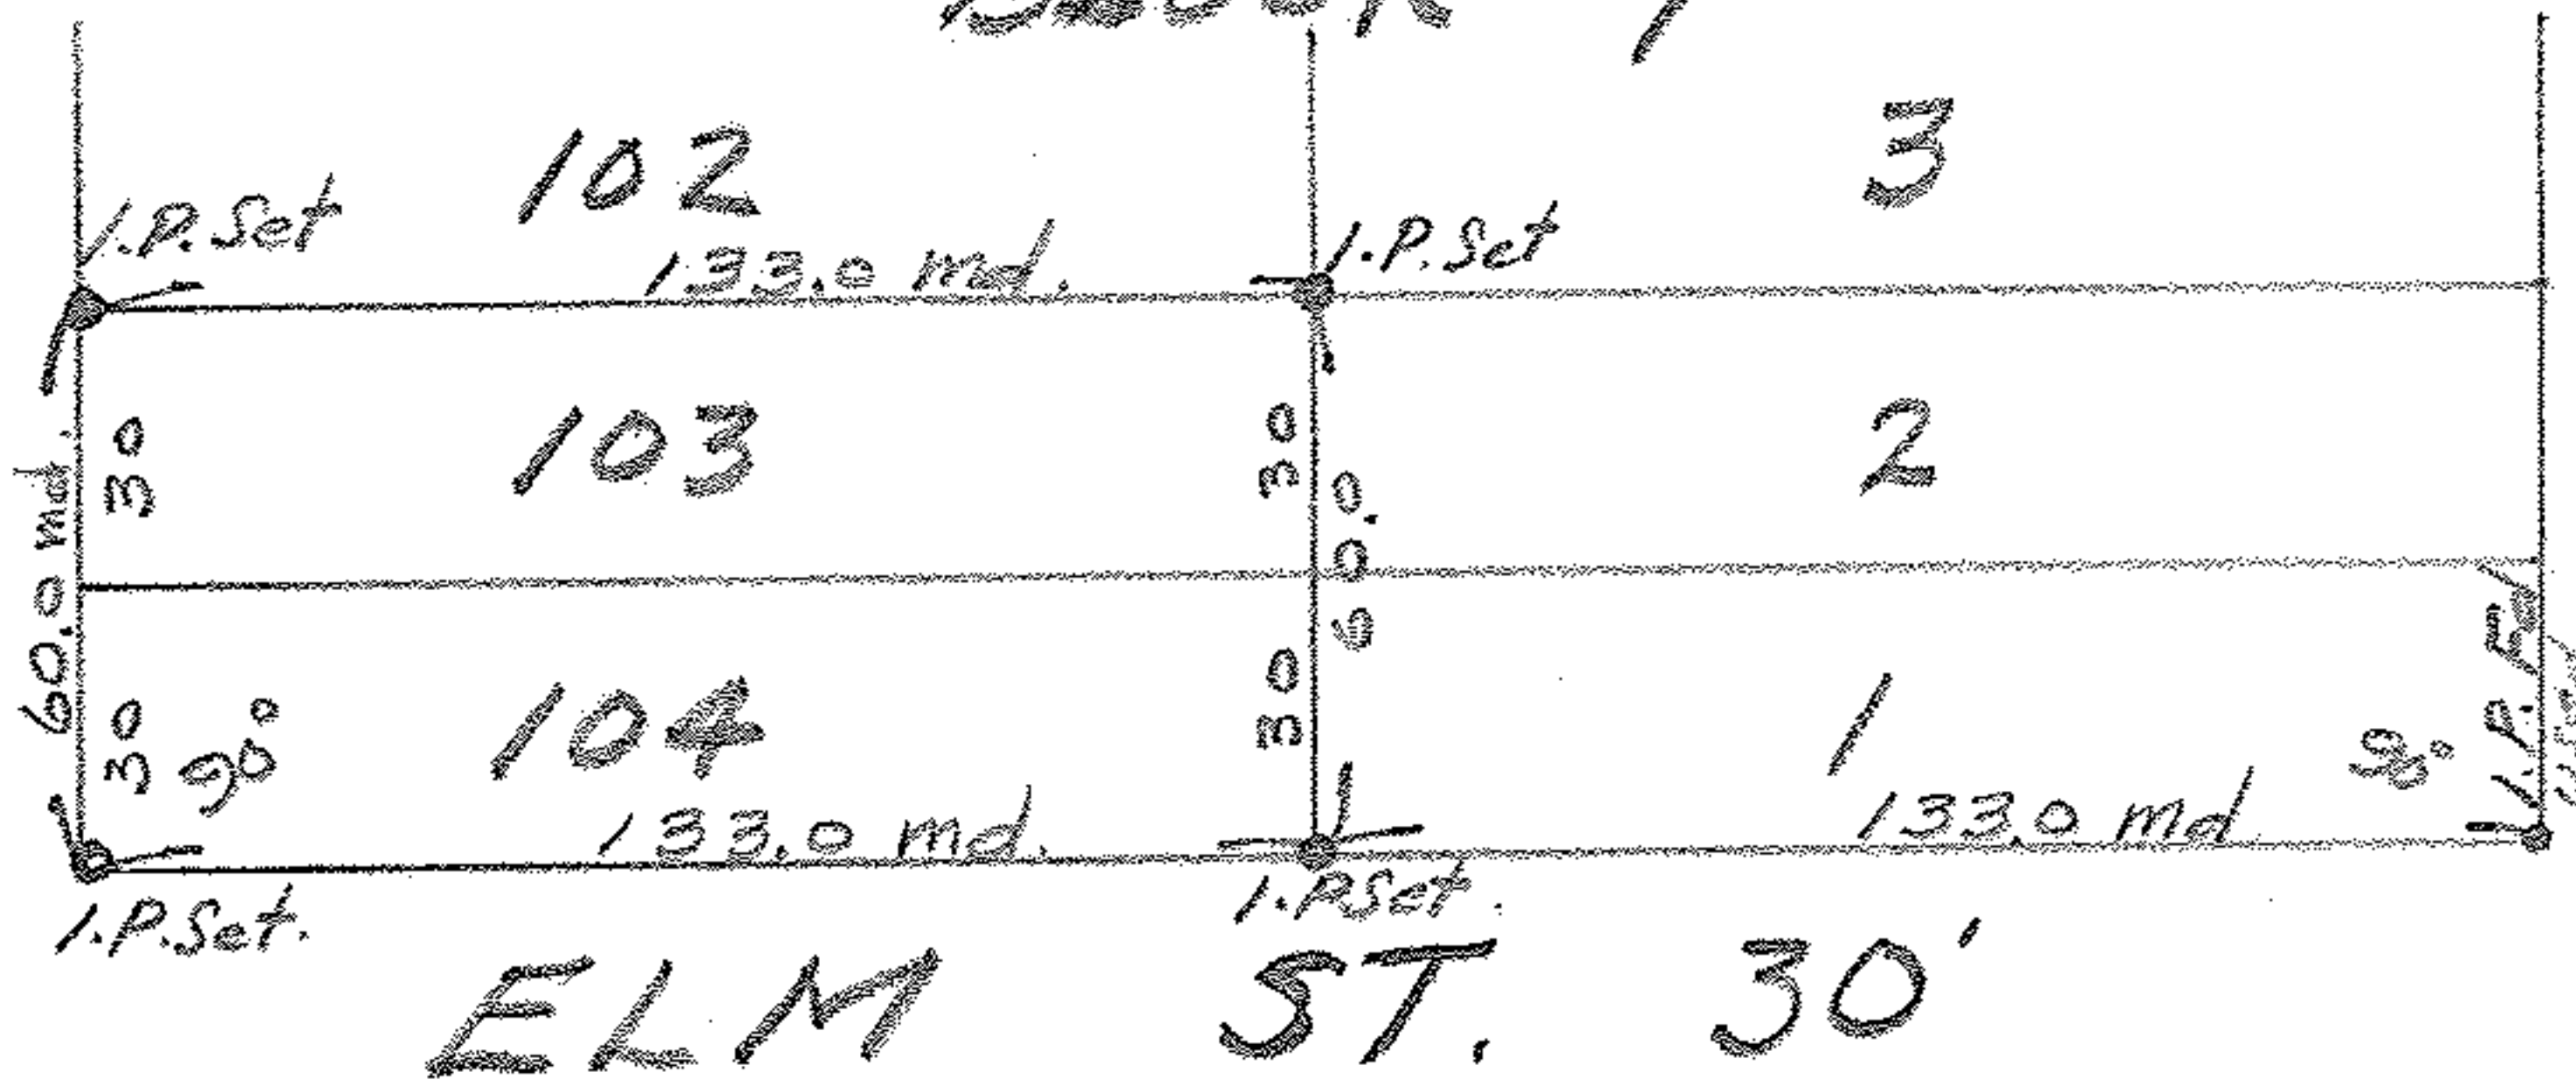

ELM ST. 30'

40'

AVE

OLIVE



BLOCK S

BRANCH ST. 30'

90° Md. I.P. Set

600.00 Rec. & md. I.P. Set

WALLACE BLVD. 40'

SURVEY FOR WALTER NEUMAN
 Sublots No. 103 and 104 in Block Y
 Cleveland Road Homesite Allotment
 Ridgeville Township, Lorain County, Ohio
 Scale: 1" = 50'
 November 1st 1950
 J. H. Getz Reg. Surveyor

0117