


07-00-009-115-039
016
015
07-00-009-A

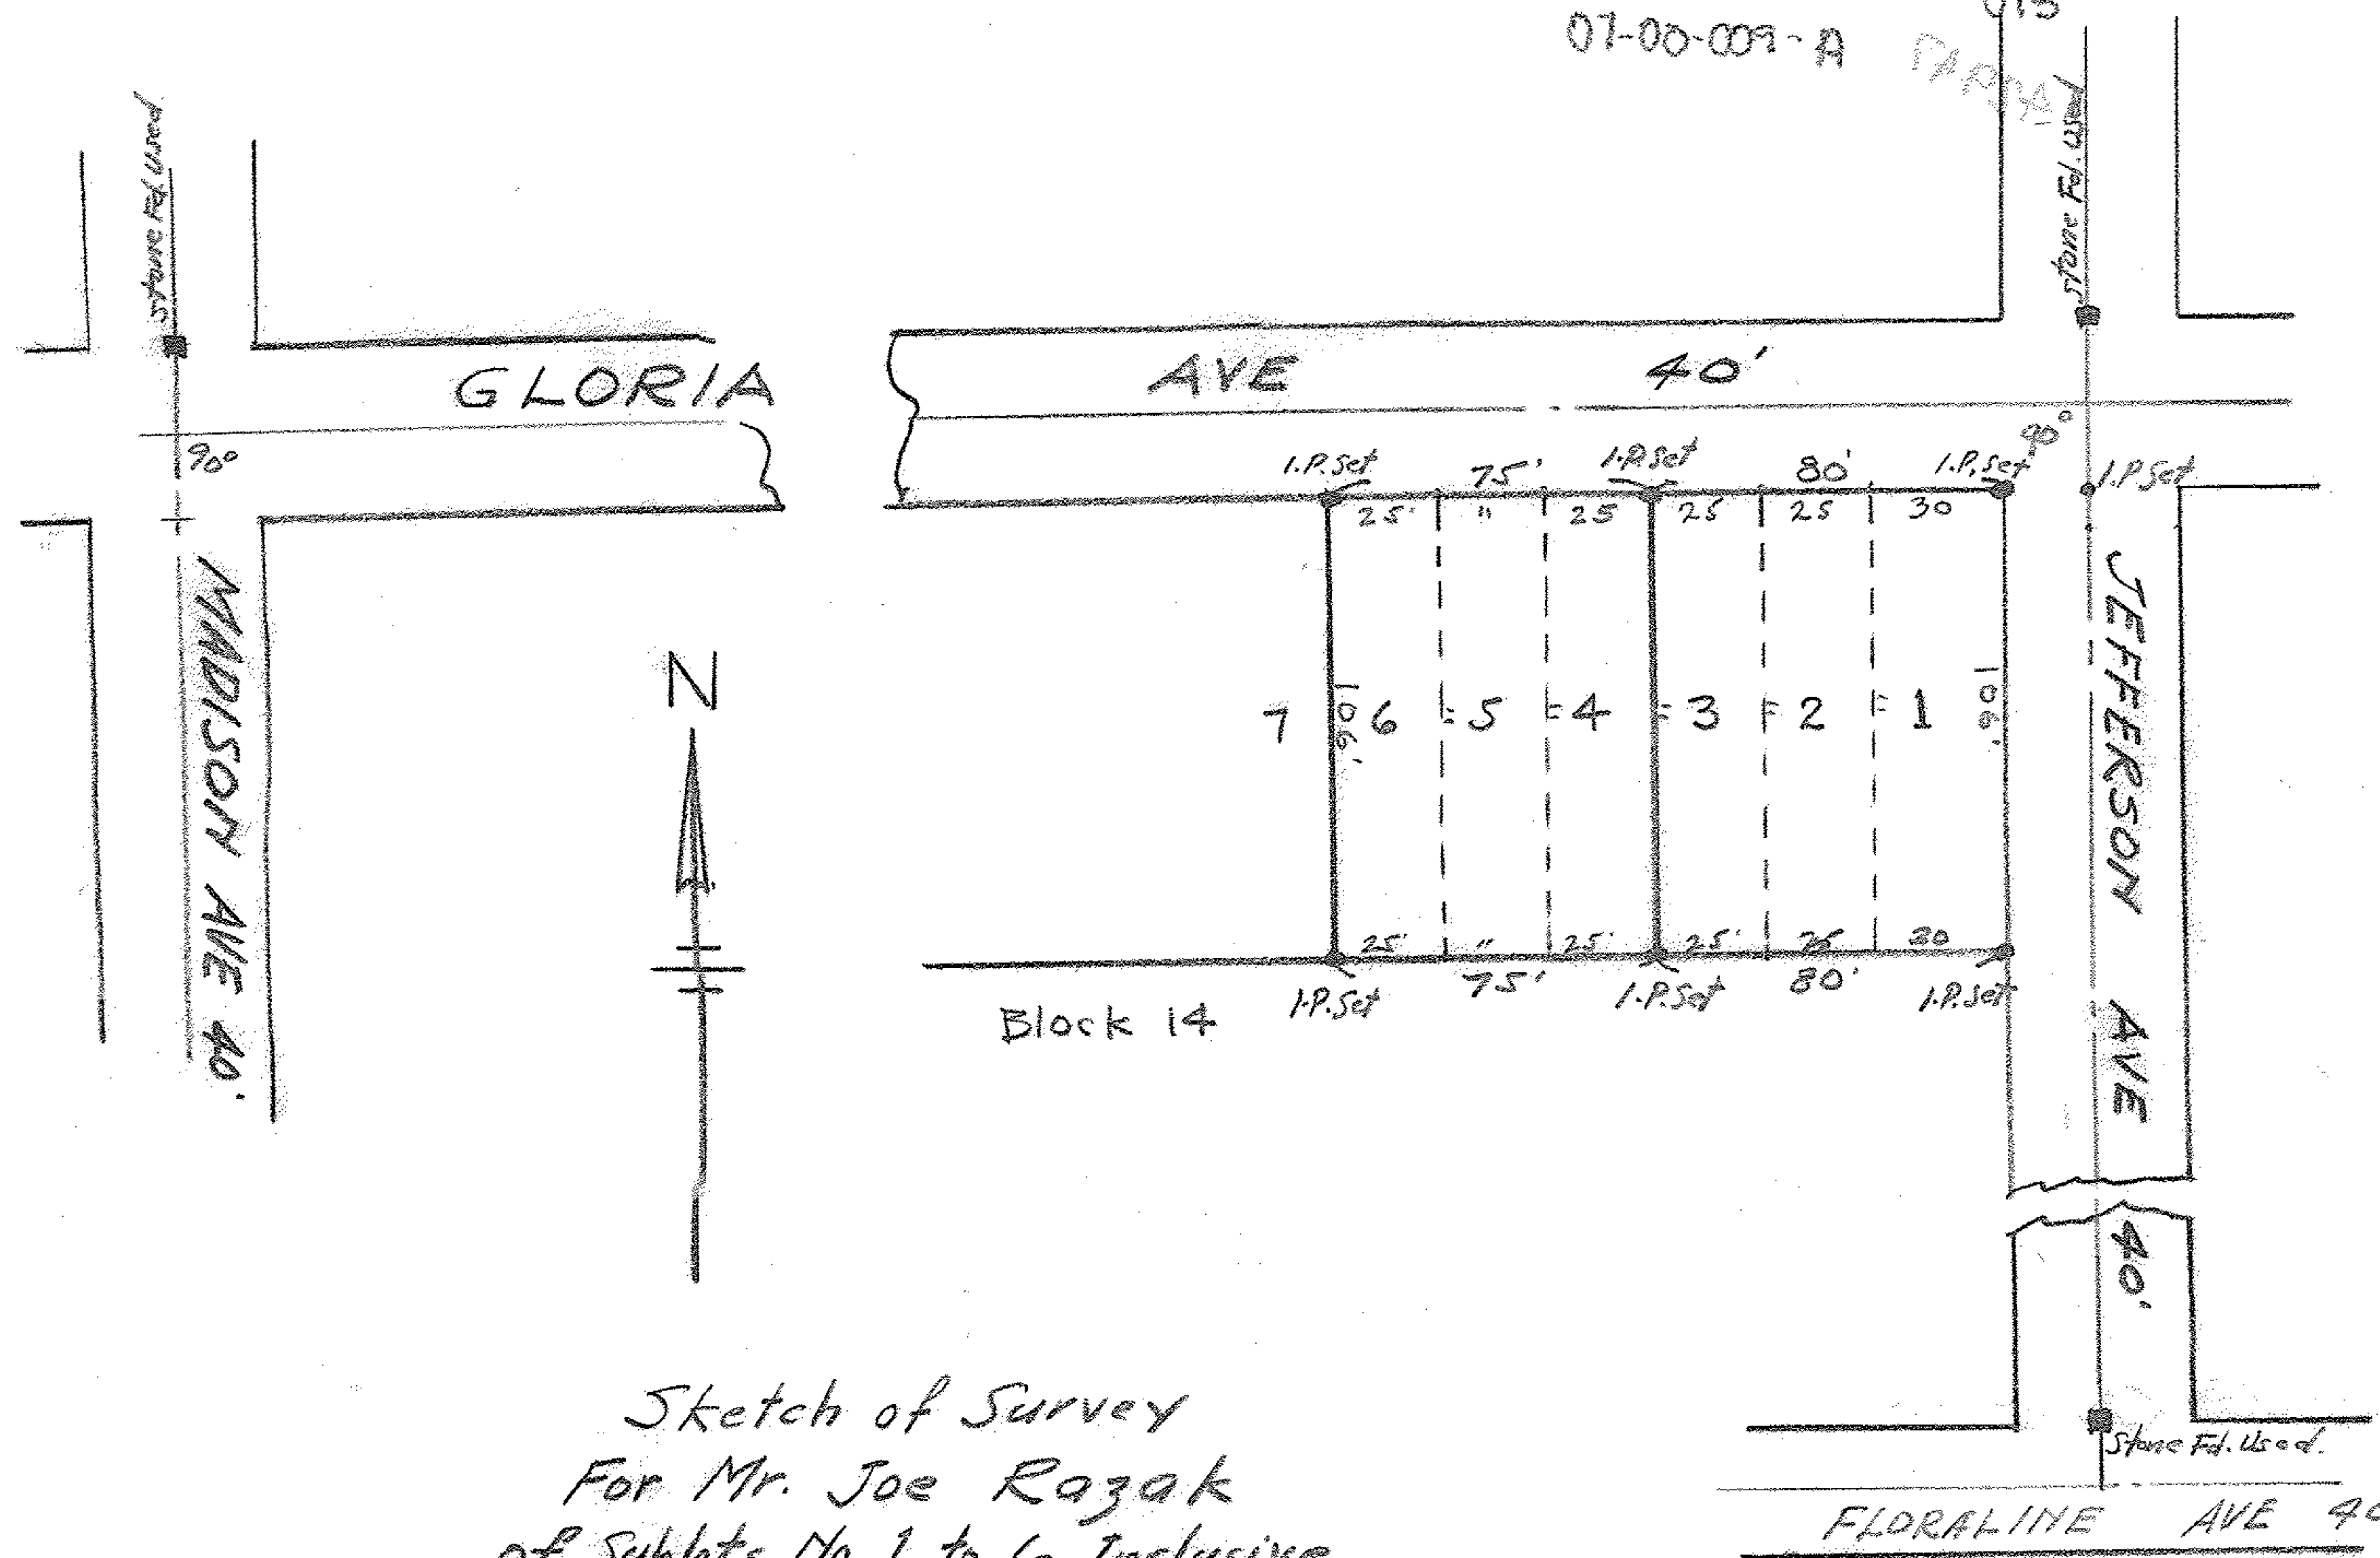

Sketch of Survey
 For Mr. Joe Razak
 of Sublots No. 1 to 6 Inclusive
 In Block 14 of the Addition to
 Ridgerville Heights Subdivision No. 2
 Ridgerville Township, Lorain County Ohio
 Scale: - 1" = 50' March 26, 1958
 J. H. Getz Reg. Engineer and Surveyor

