
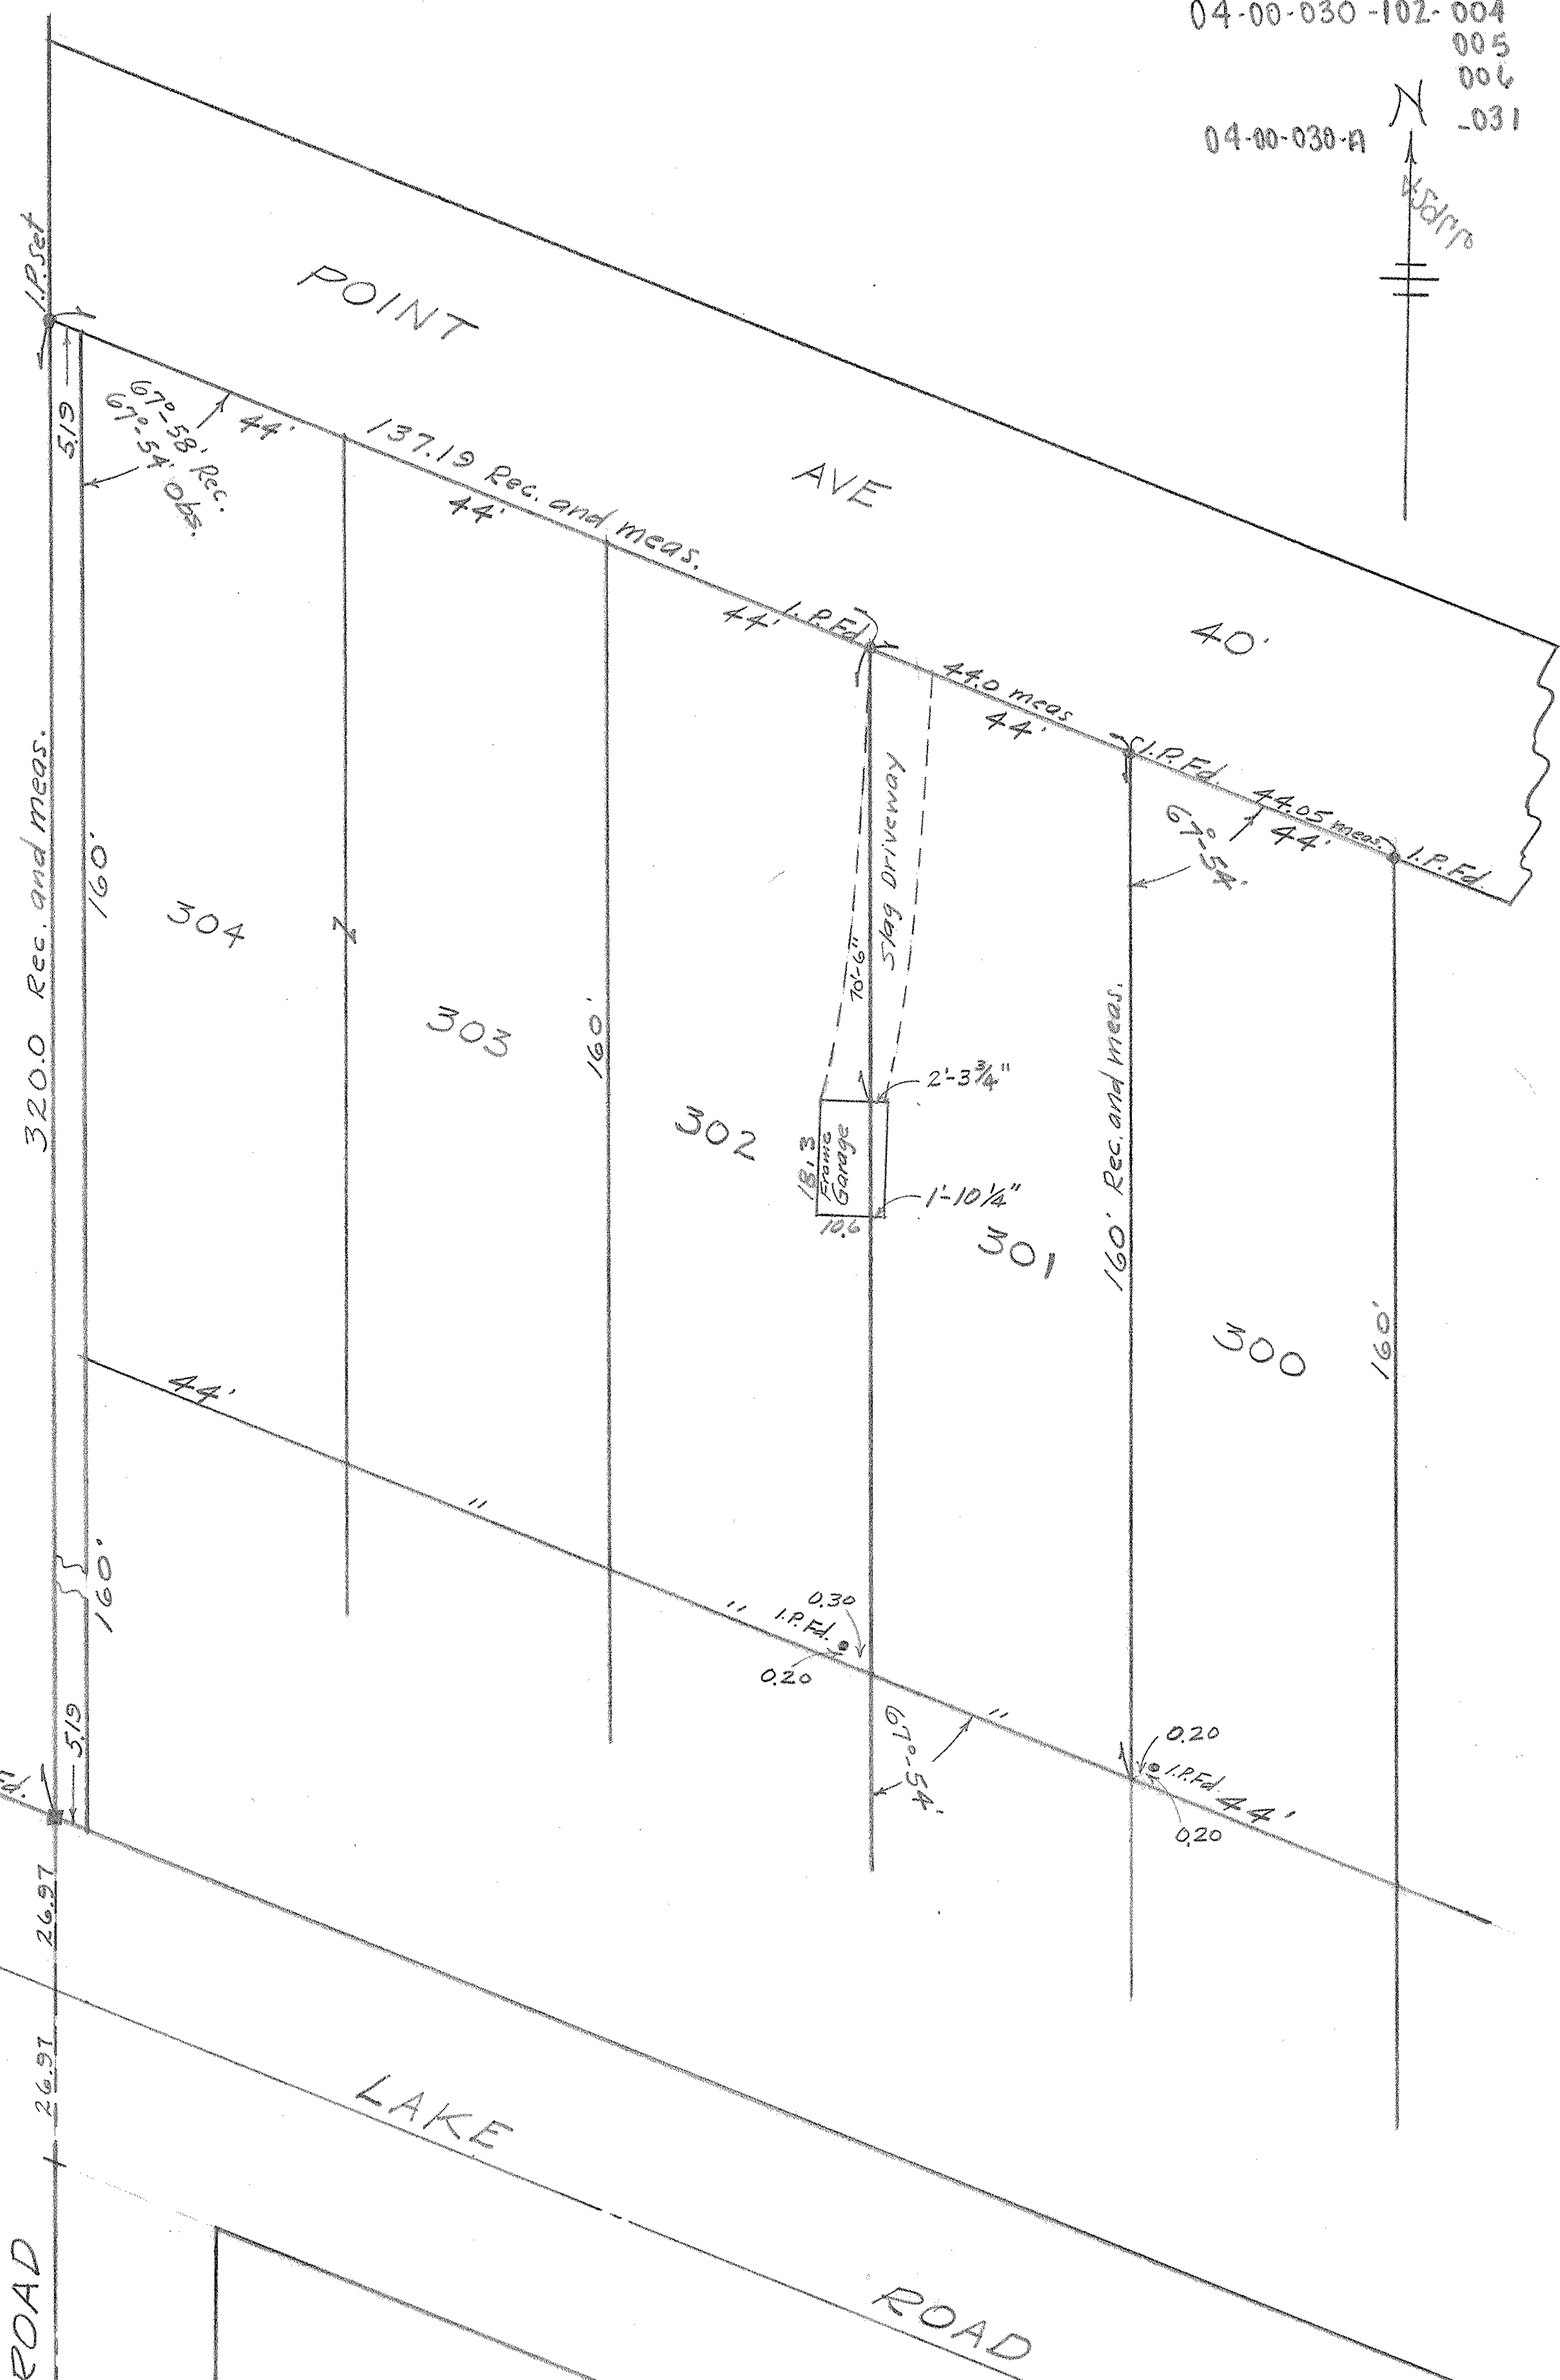


04-00-030-102-004  
005  
006  
031  
04-00-030-A

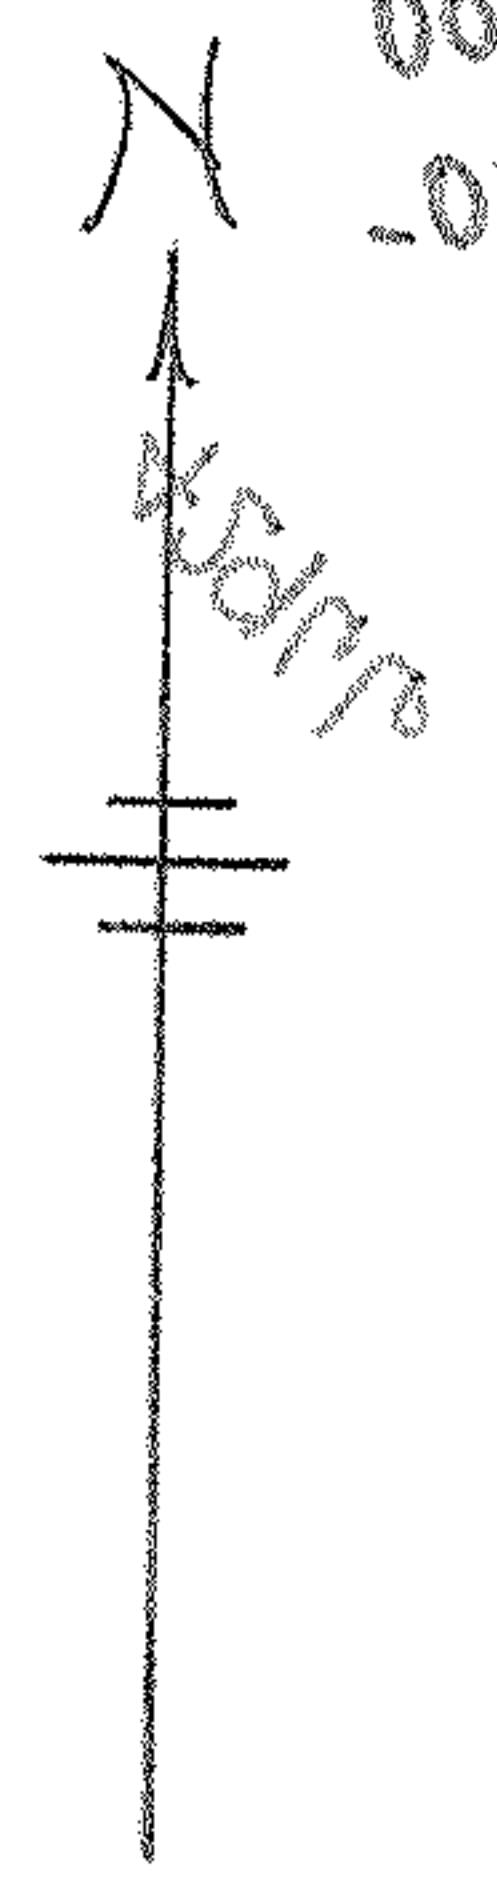

LEAR ROAD

Lot and Garage Location Survey  
For Harry Green  
Of Sublot No. 301 in Eagle Point Allot.  
As recorded in Vol. 8 Page 20 of Lorain Co. Rec. Plats.  
Being a part of Original Avon Twp. Sec. No. 30  
Now in the Village of Avon Lake  
Lorain County Ohio  
Scale: 1" = 20' June 1951 J.H. Getz, Reg. Engr. & Surveyor