


AFPSA

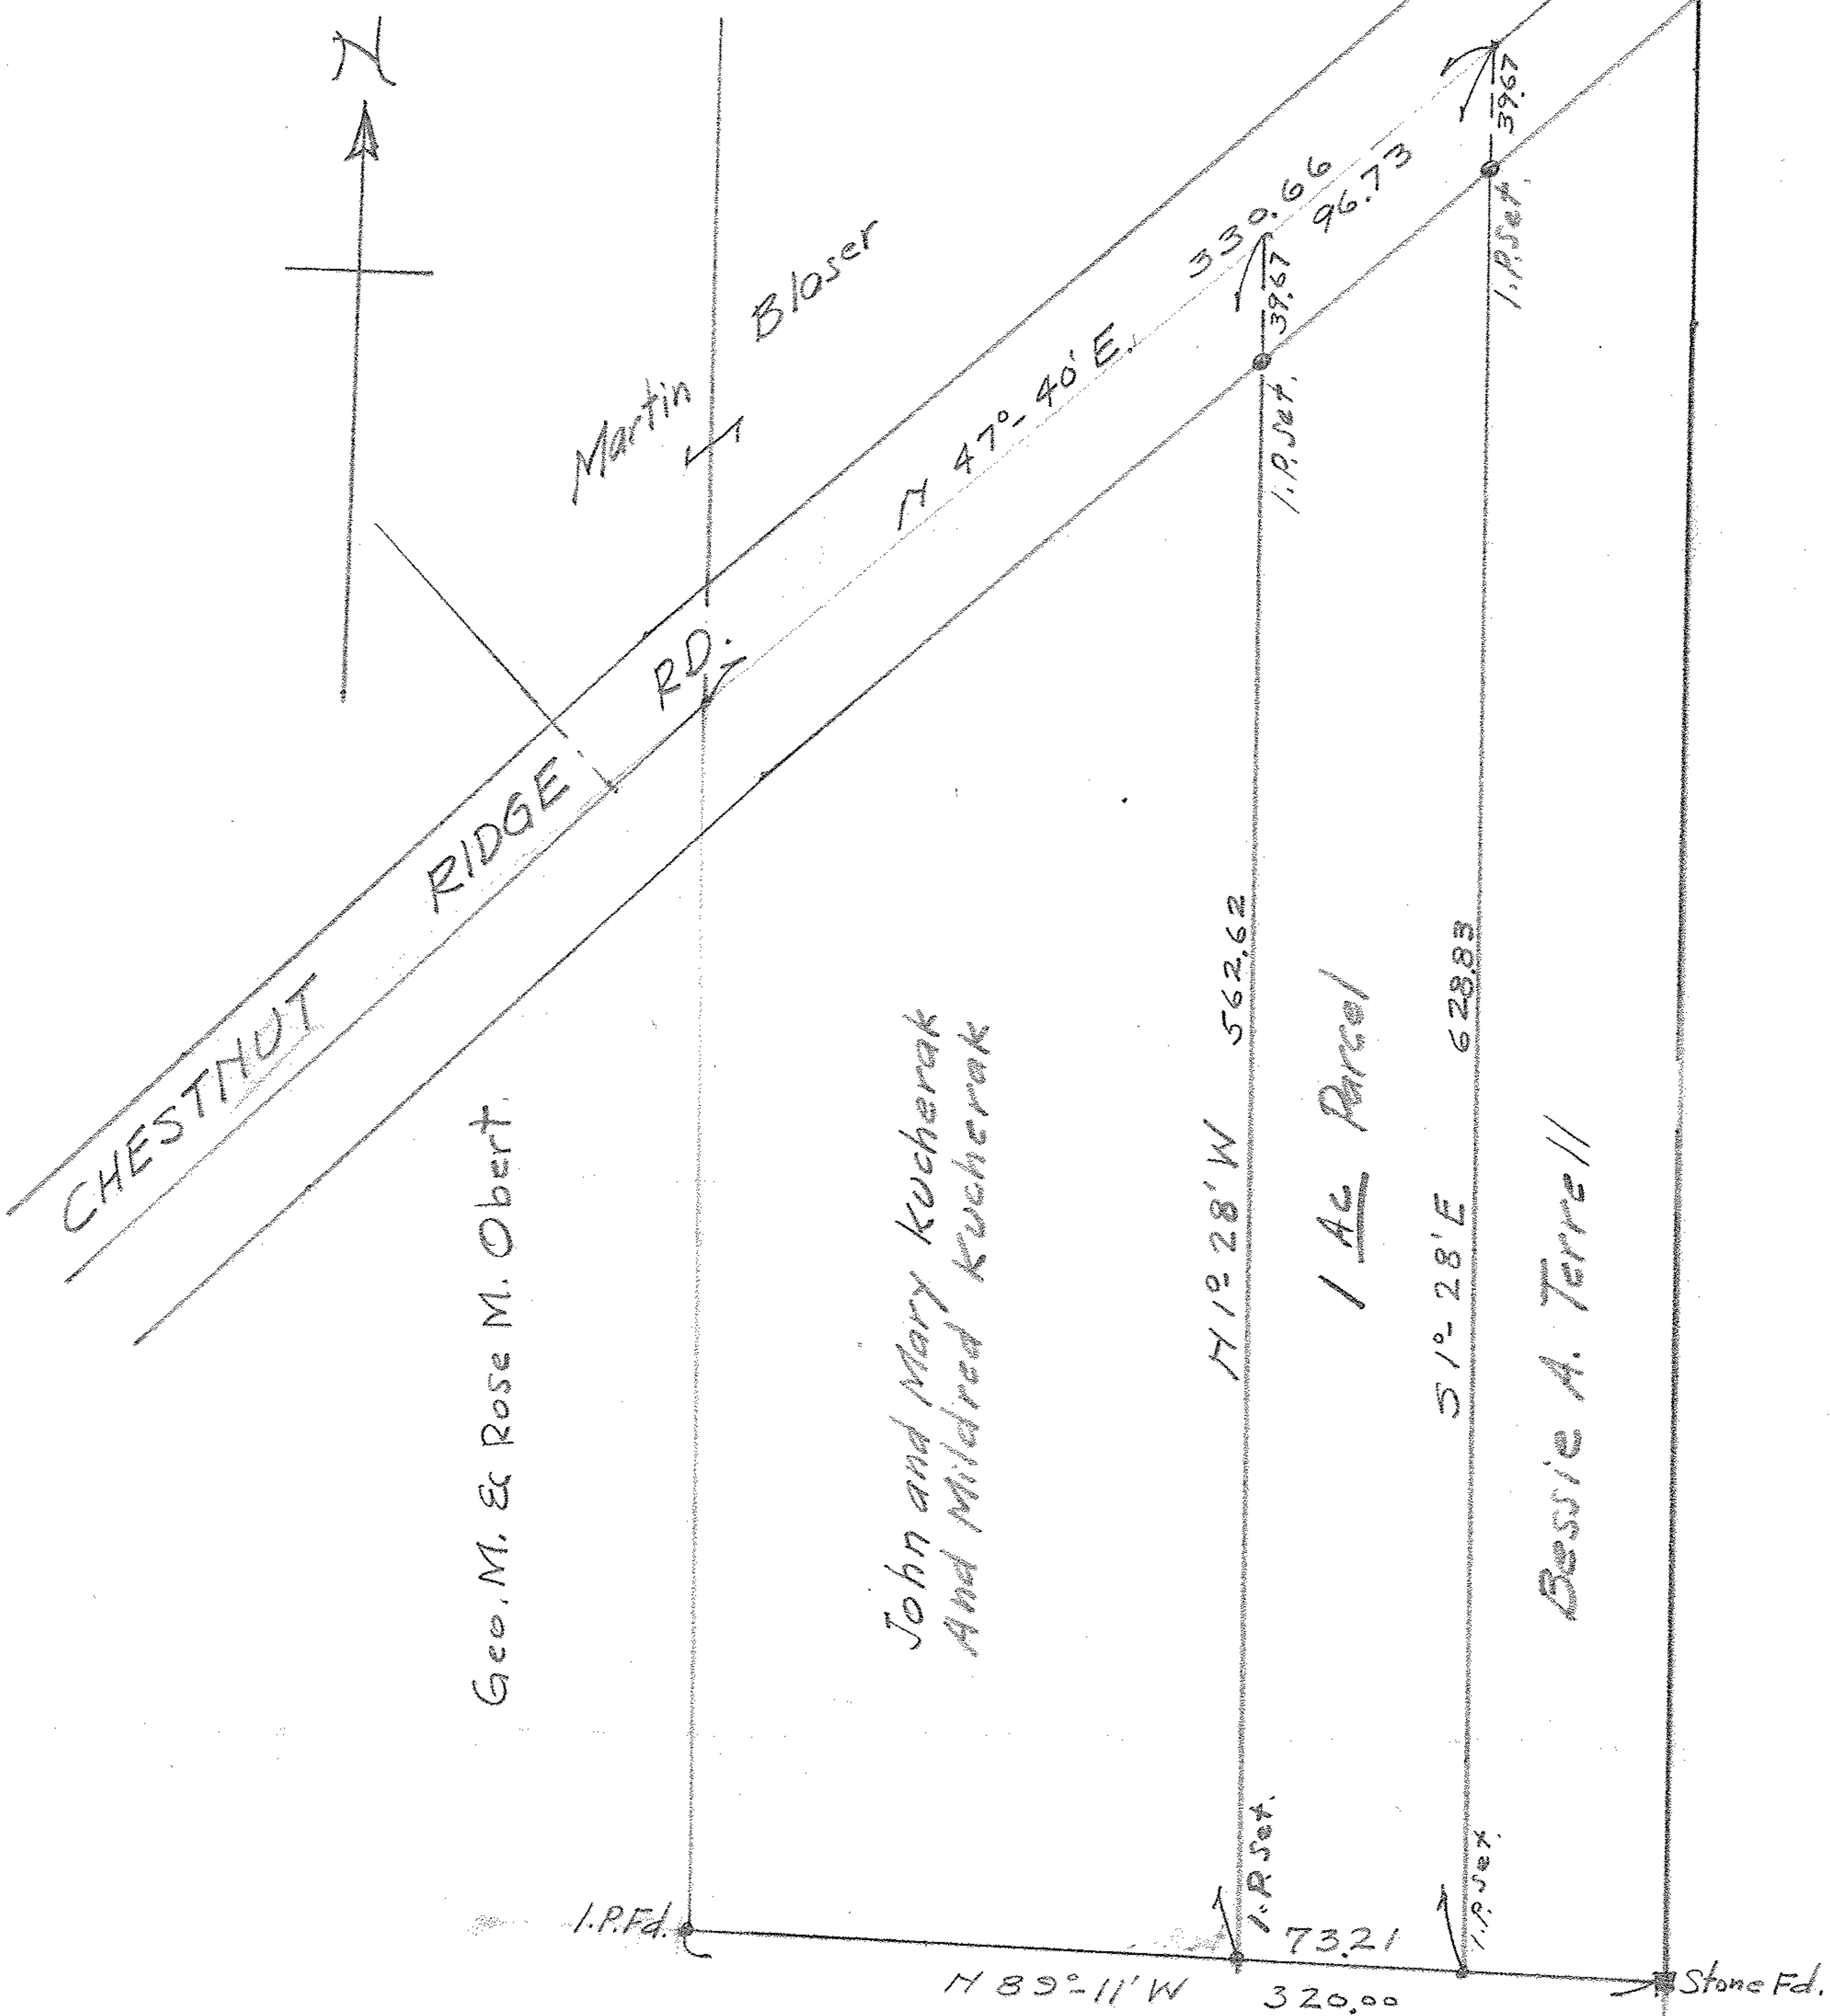

Survey & staking of 1 Ac. Parcel  
 For Alex Robishaw  
 Being a part of Original Ridgville Twp. Lot No. 4  
 Lorain County Ohio Scale: 1" = 60' Date April 23, 1949  
 J.H. Getz Reg. Surveyor