



04-00-030-141-158
159
04-00-030-C 160

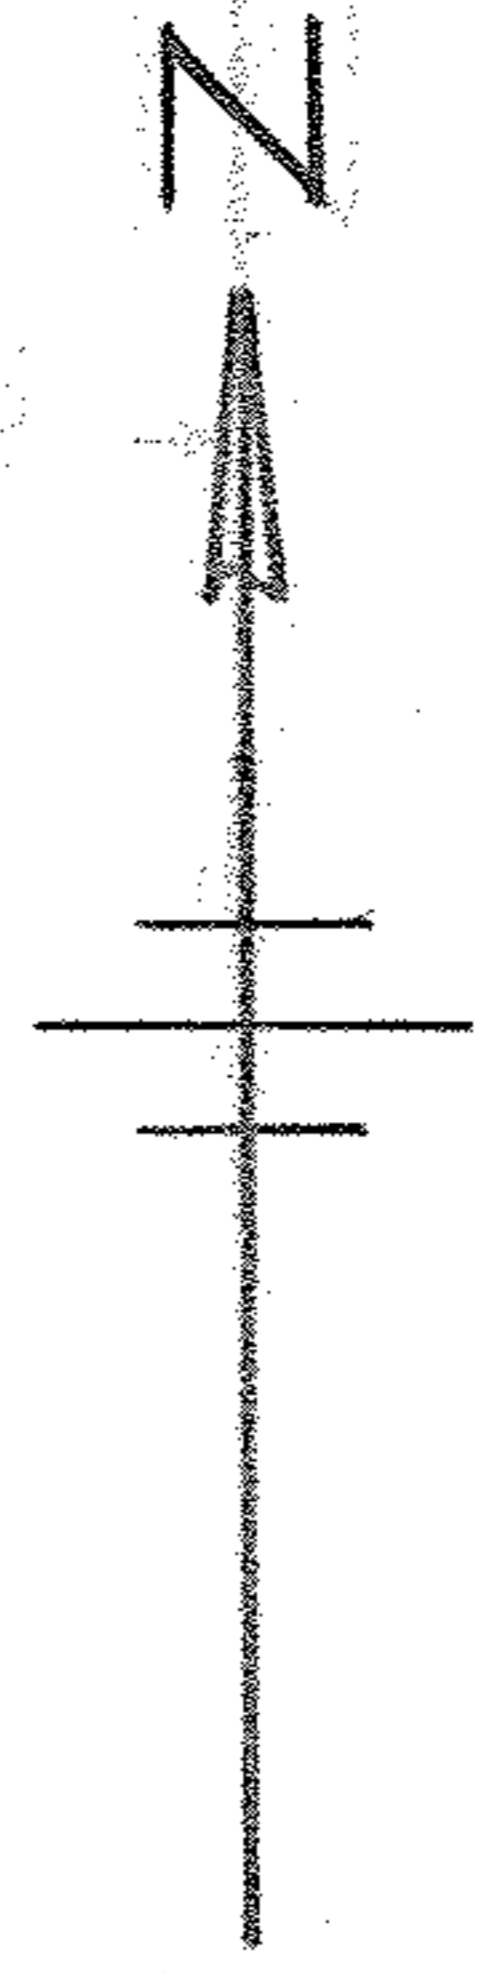

Eagle Point Allt.

Andover Beach Subdivision.

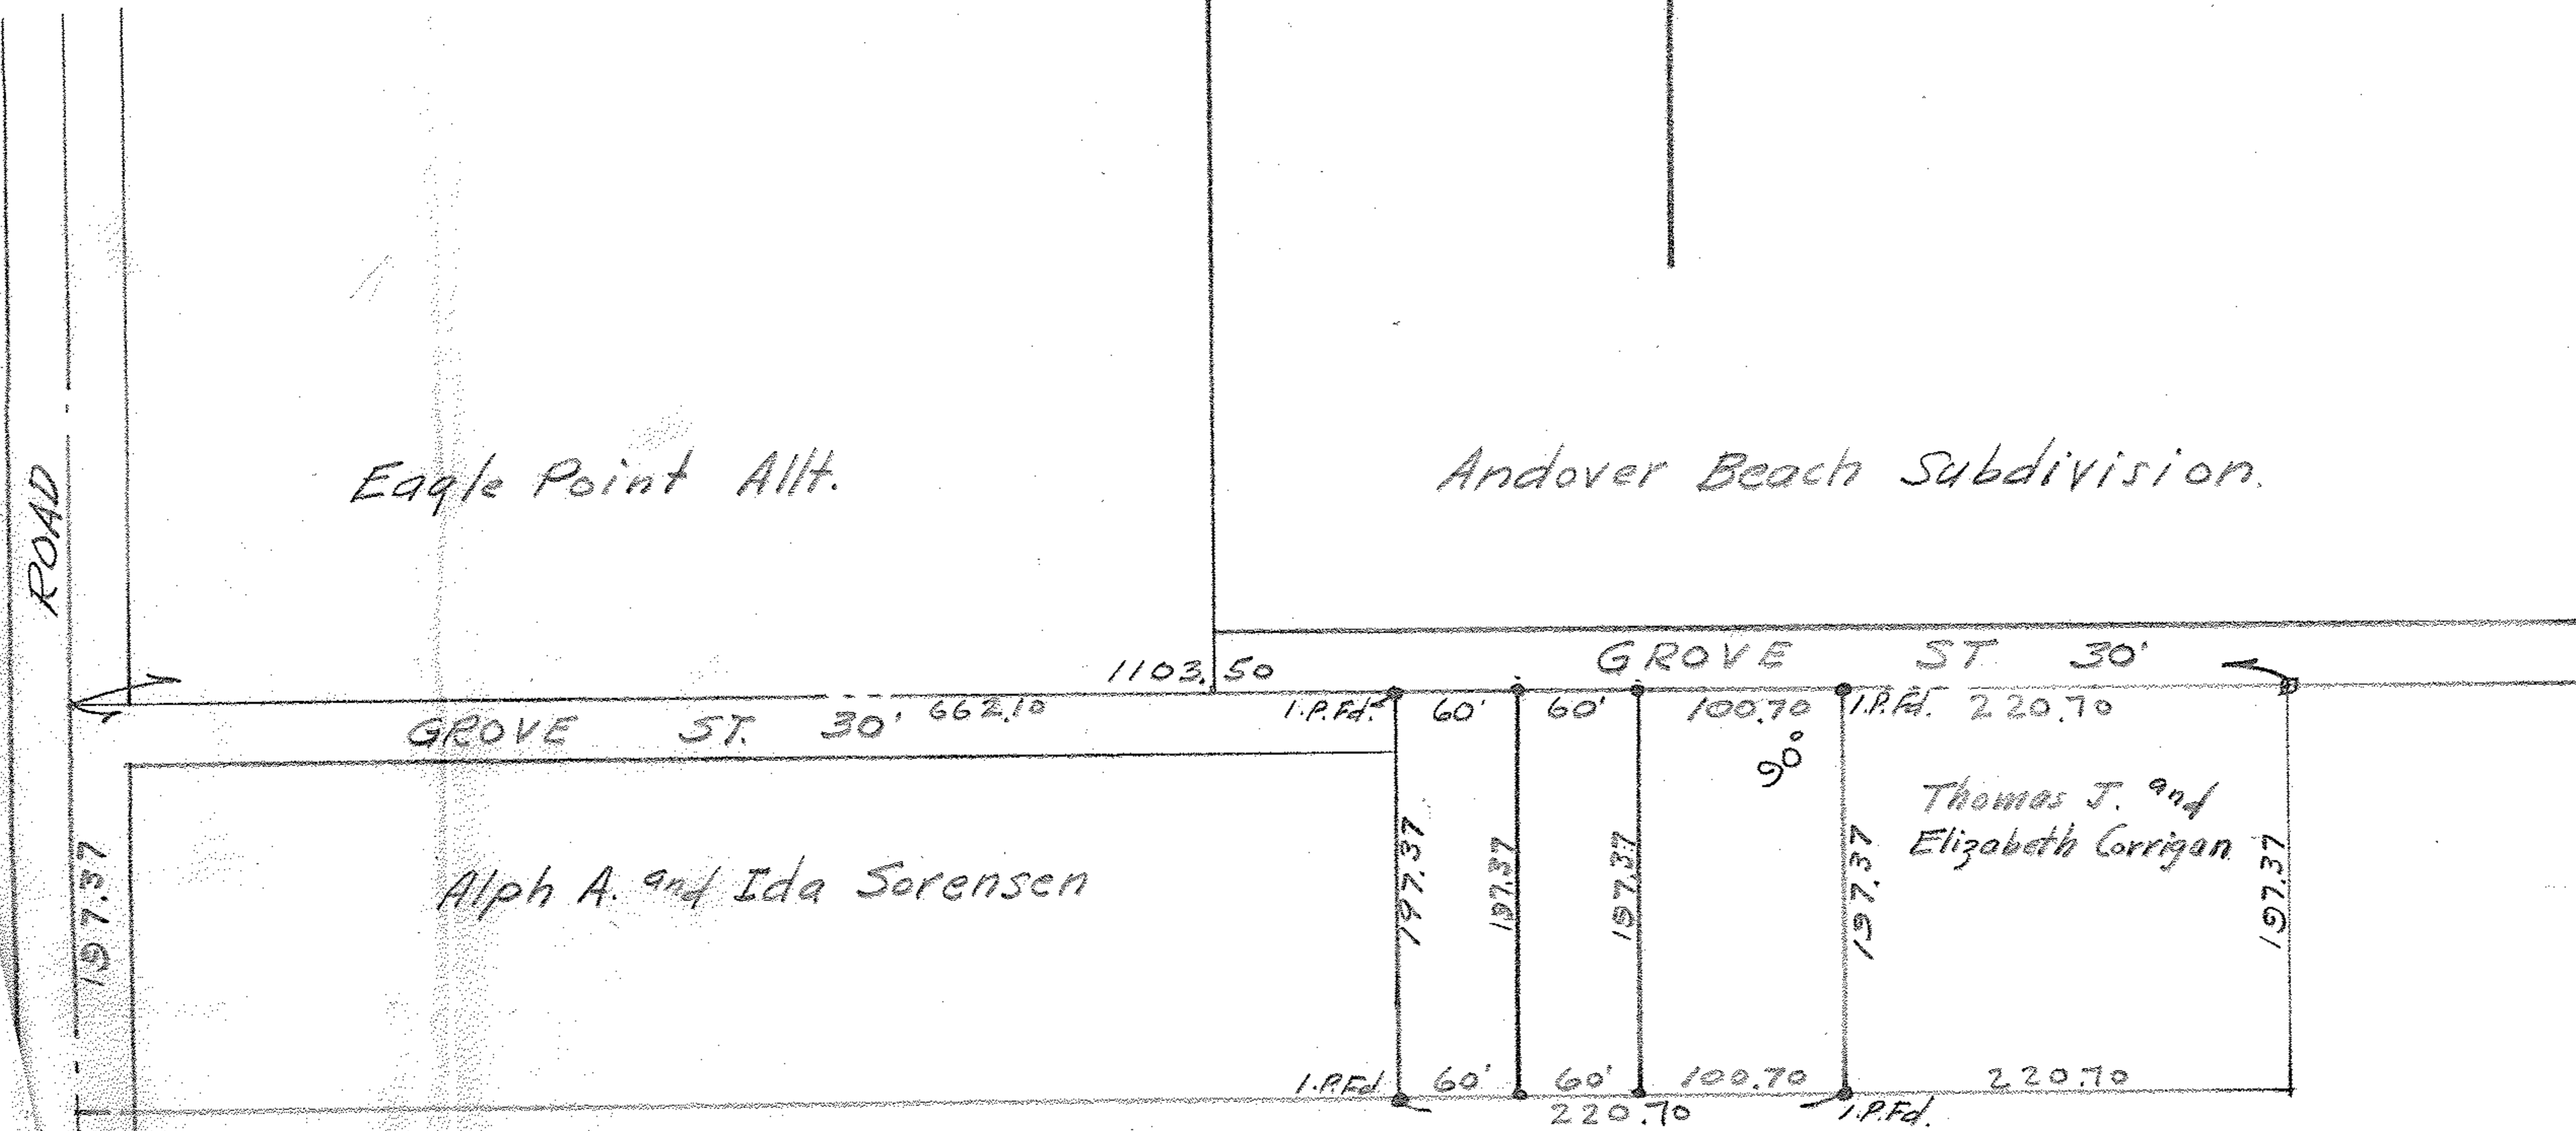

Survey For Andrew Wegasky
 Part of Original Avon Township Section No. 30
 Avon Lake Village, Lorain County, Ohio
 Scale: 1" = 100' Oct. 20, 1952 J.H. Getz, Reg. Engr. & Surveyor