


43000

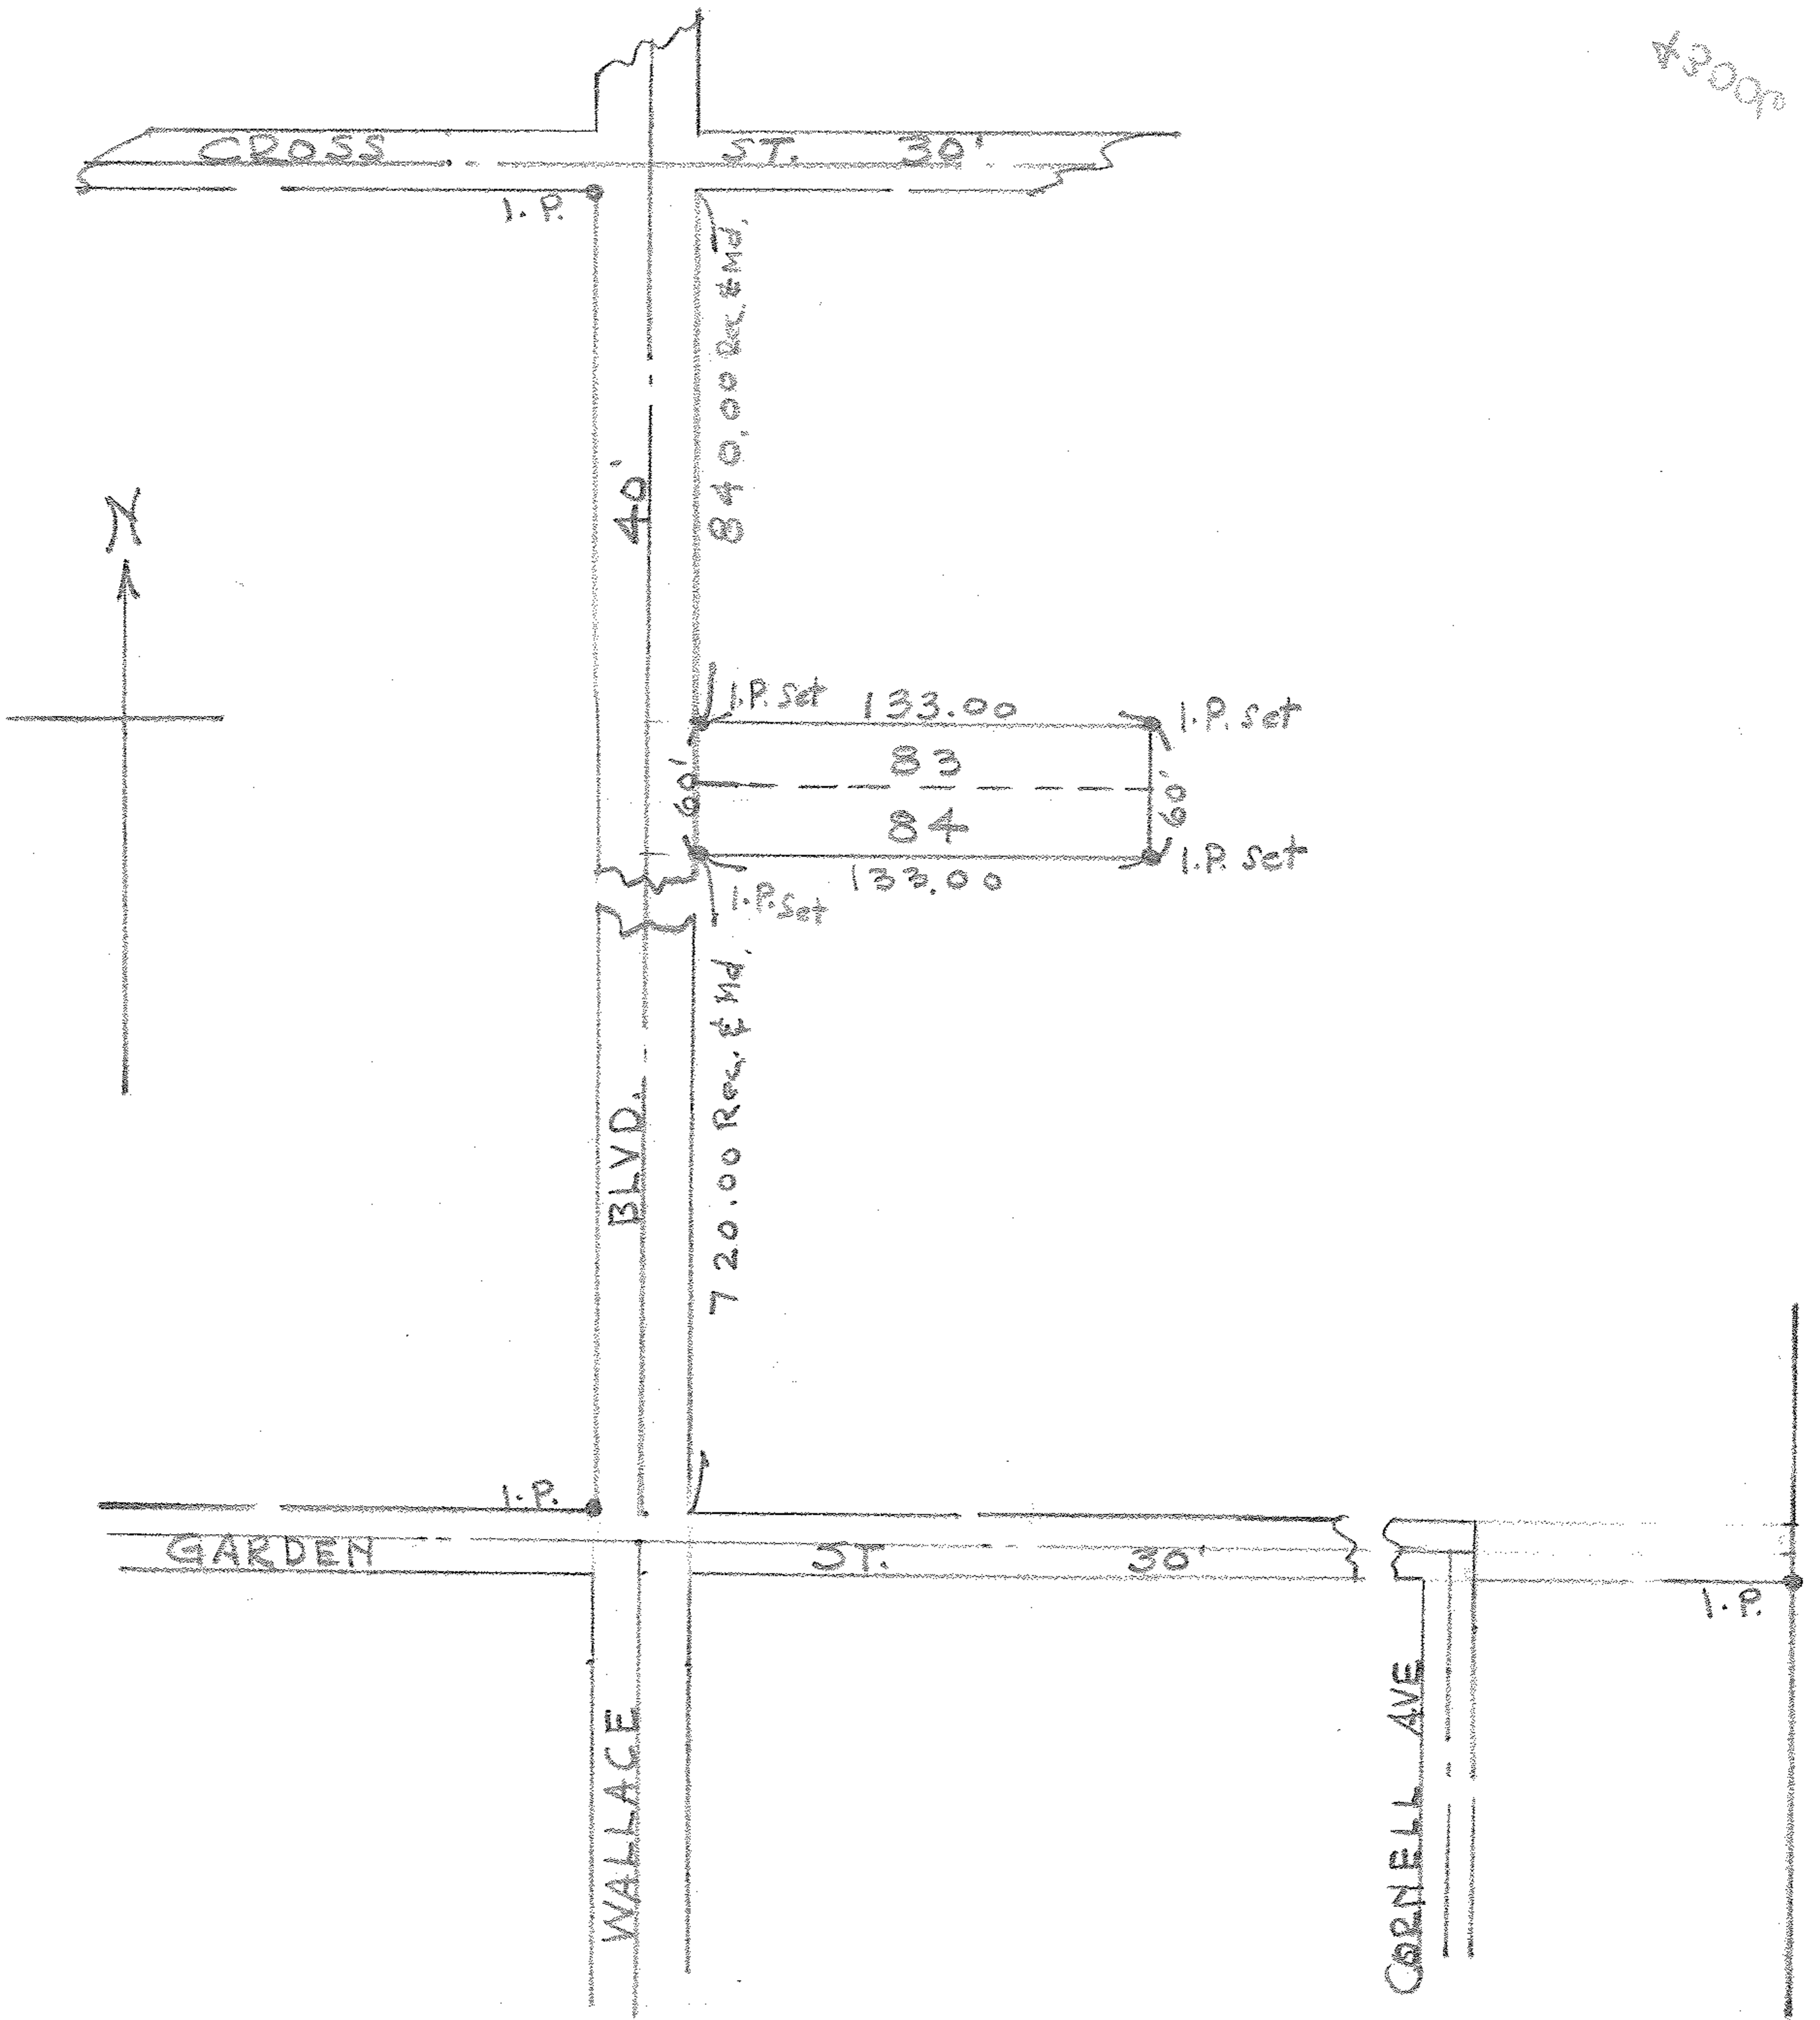

Survey of Sublots 83 & 84 Block F OF  
 Cleveland Road Homesite Allotment  
 Ridgville Twp. Lorain Co. Ohio  
 For Paul Gravila Jr.  
 May 1947 J.H. Getz, Reg. Surveyor