

07-00-016-102-006

thru

07-00-016-B

-009

220ft

CROSS ST.


20' I.P. Used

40'

20' I.P. Used

BLOCK "D"

AVE

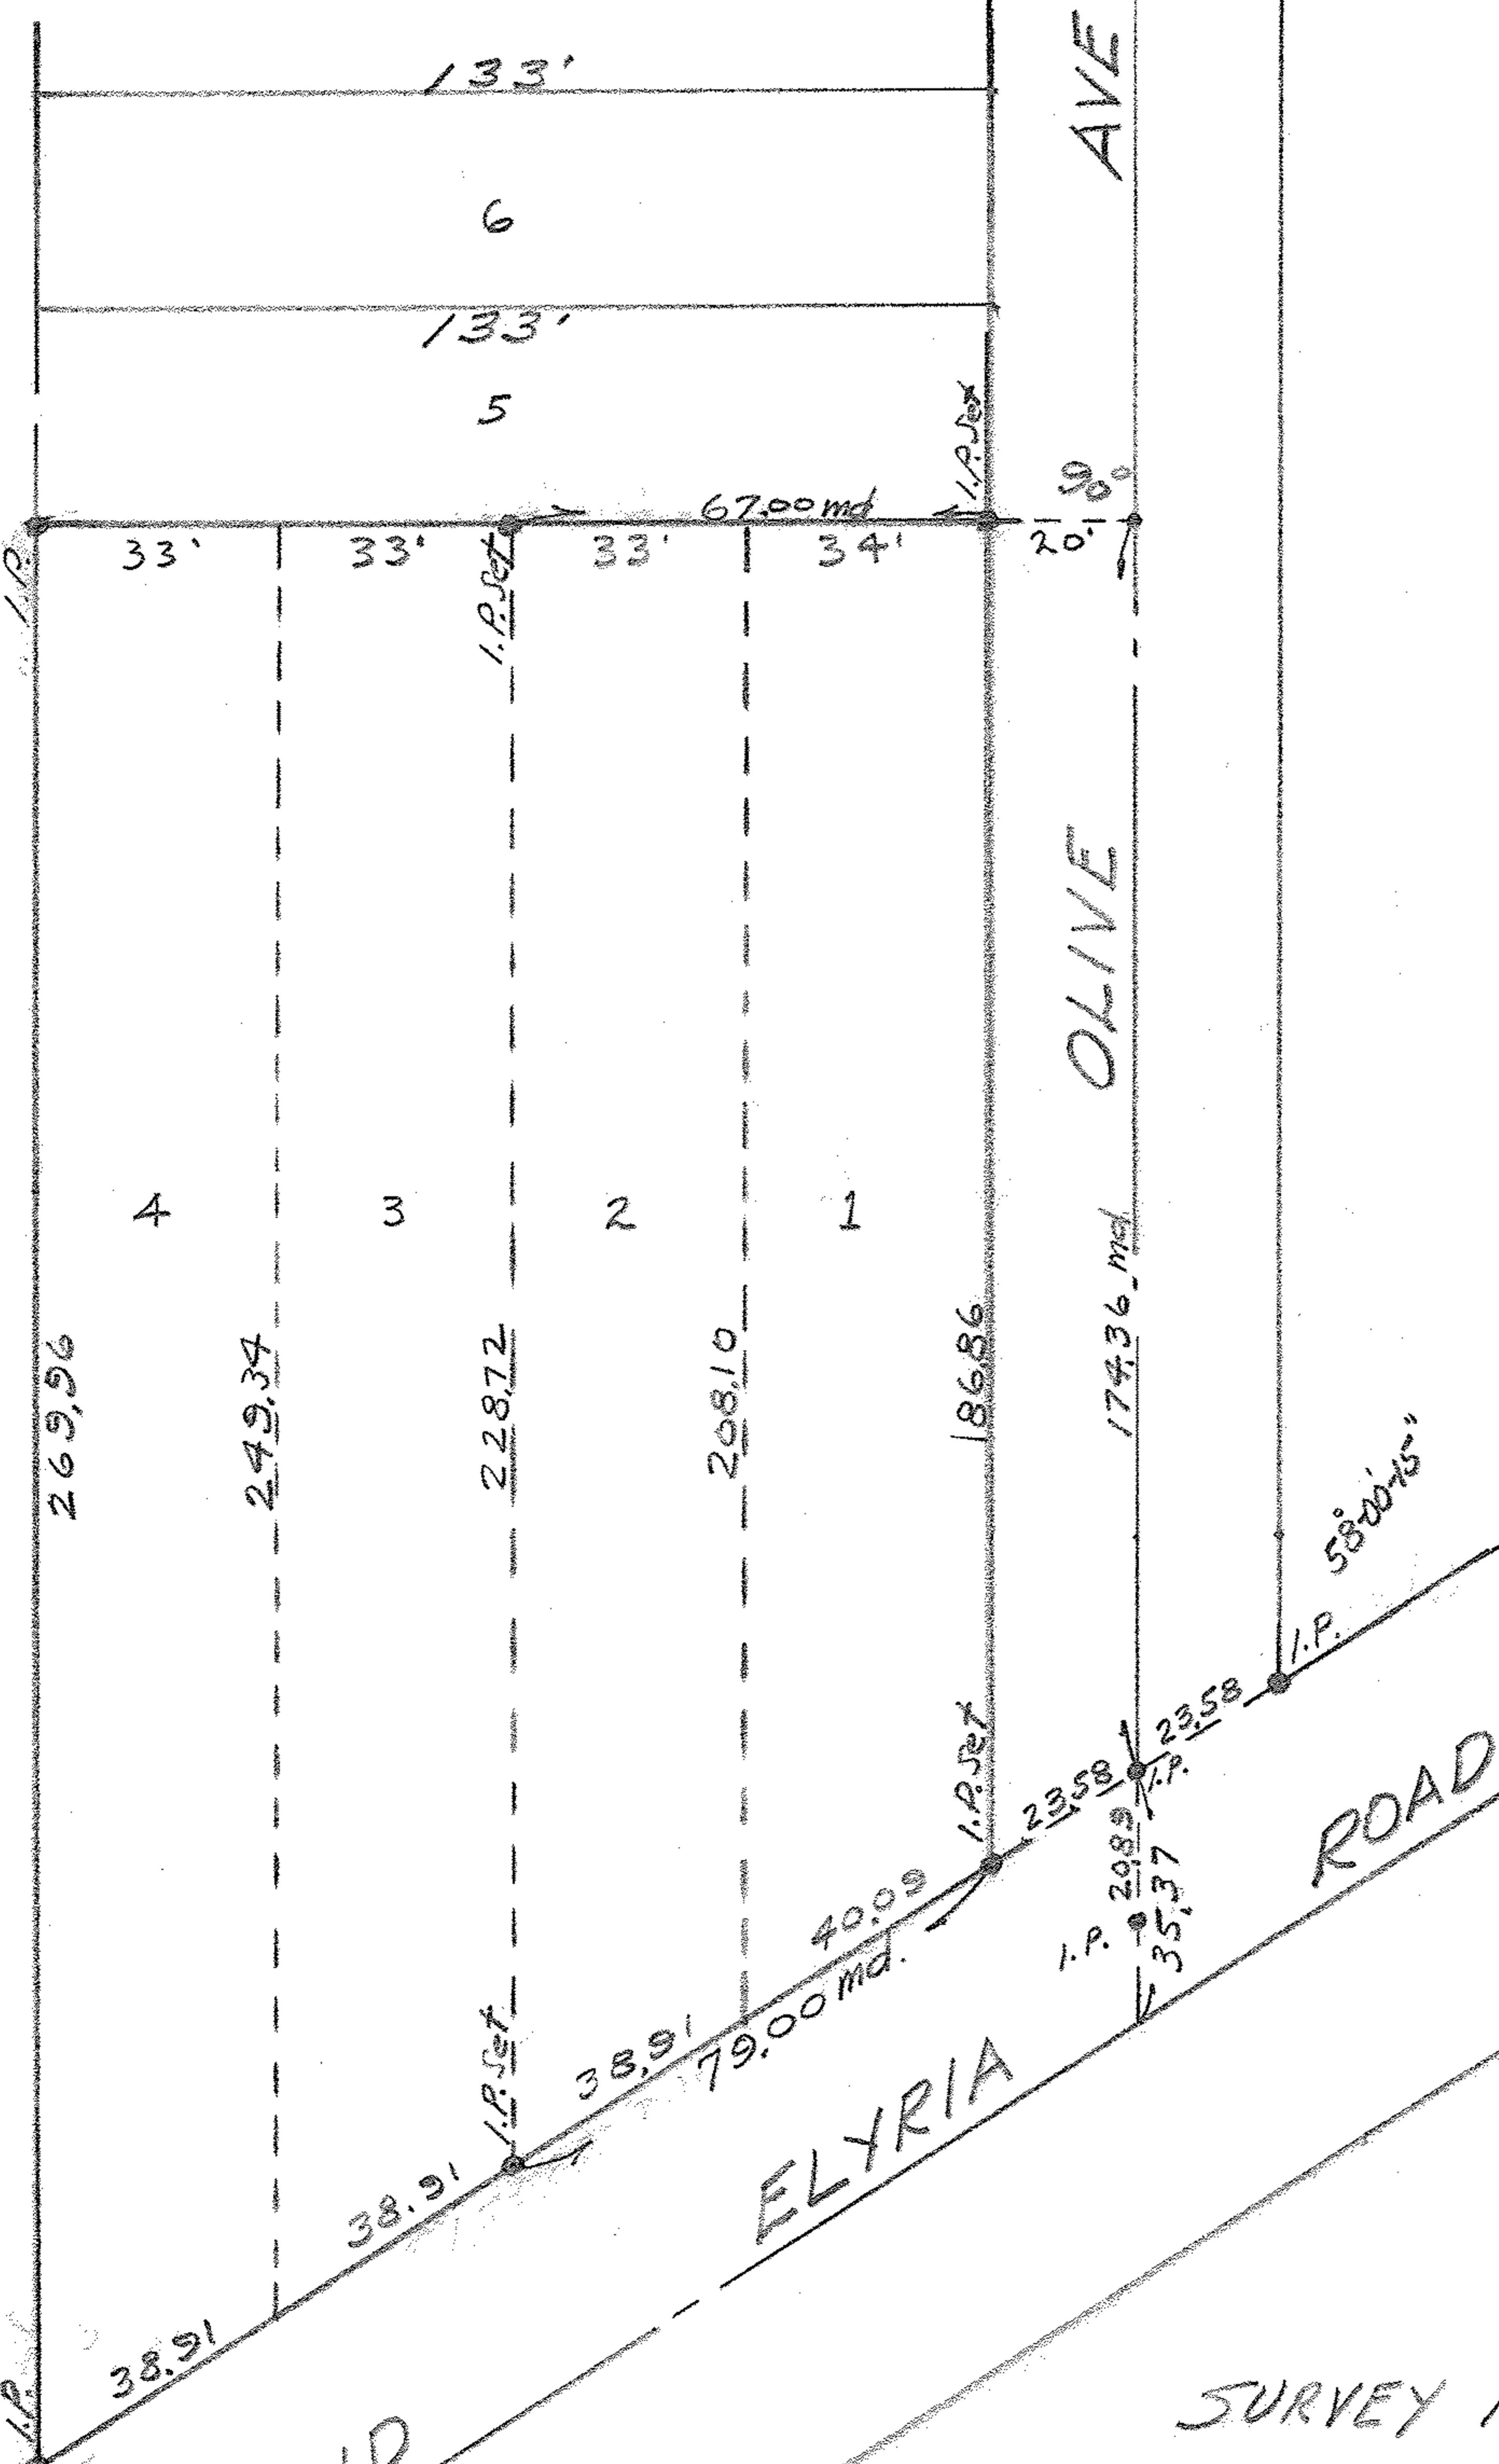

CLEVELAND

ELYRIA

OLIVE

ROAD

SURVEY FOR

Cletus Biermacher
of Sublots 1 and 2 in Block "D"

The Cleveland Road Homesite Allt.

Part of Orig. Ridgeville Twp. Lot No. 16

Lorain County Ohio

Scale: 1" = 30' March 1952

J.H. Getz, Reg. Engr. and Surveyor

