

07-00-028-101-???

07-00-028-A

ACET


Kentucky Holding Co.

Lot No. 28, Twp. 1.P. Fd. N65-59E 1.P.Fd.

119.36

25.01

0.41 Ac.

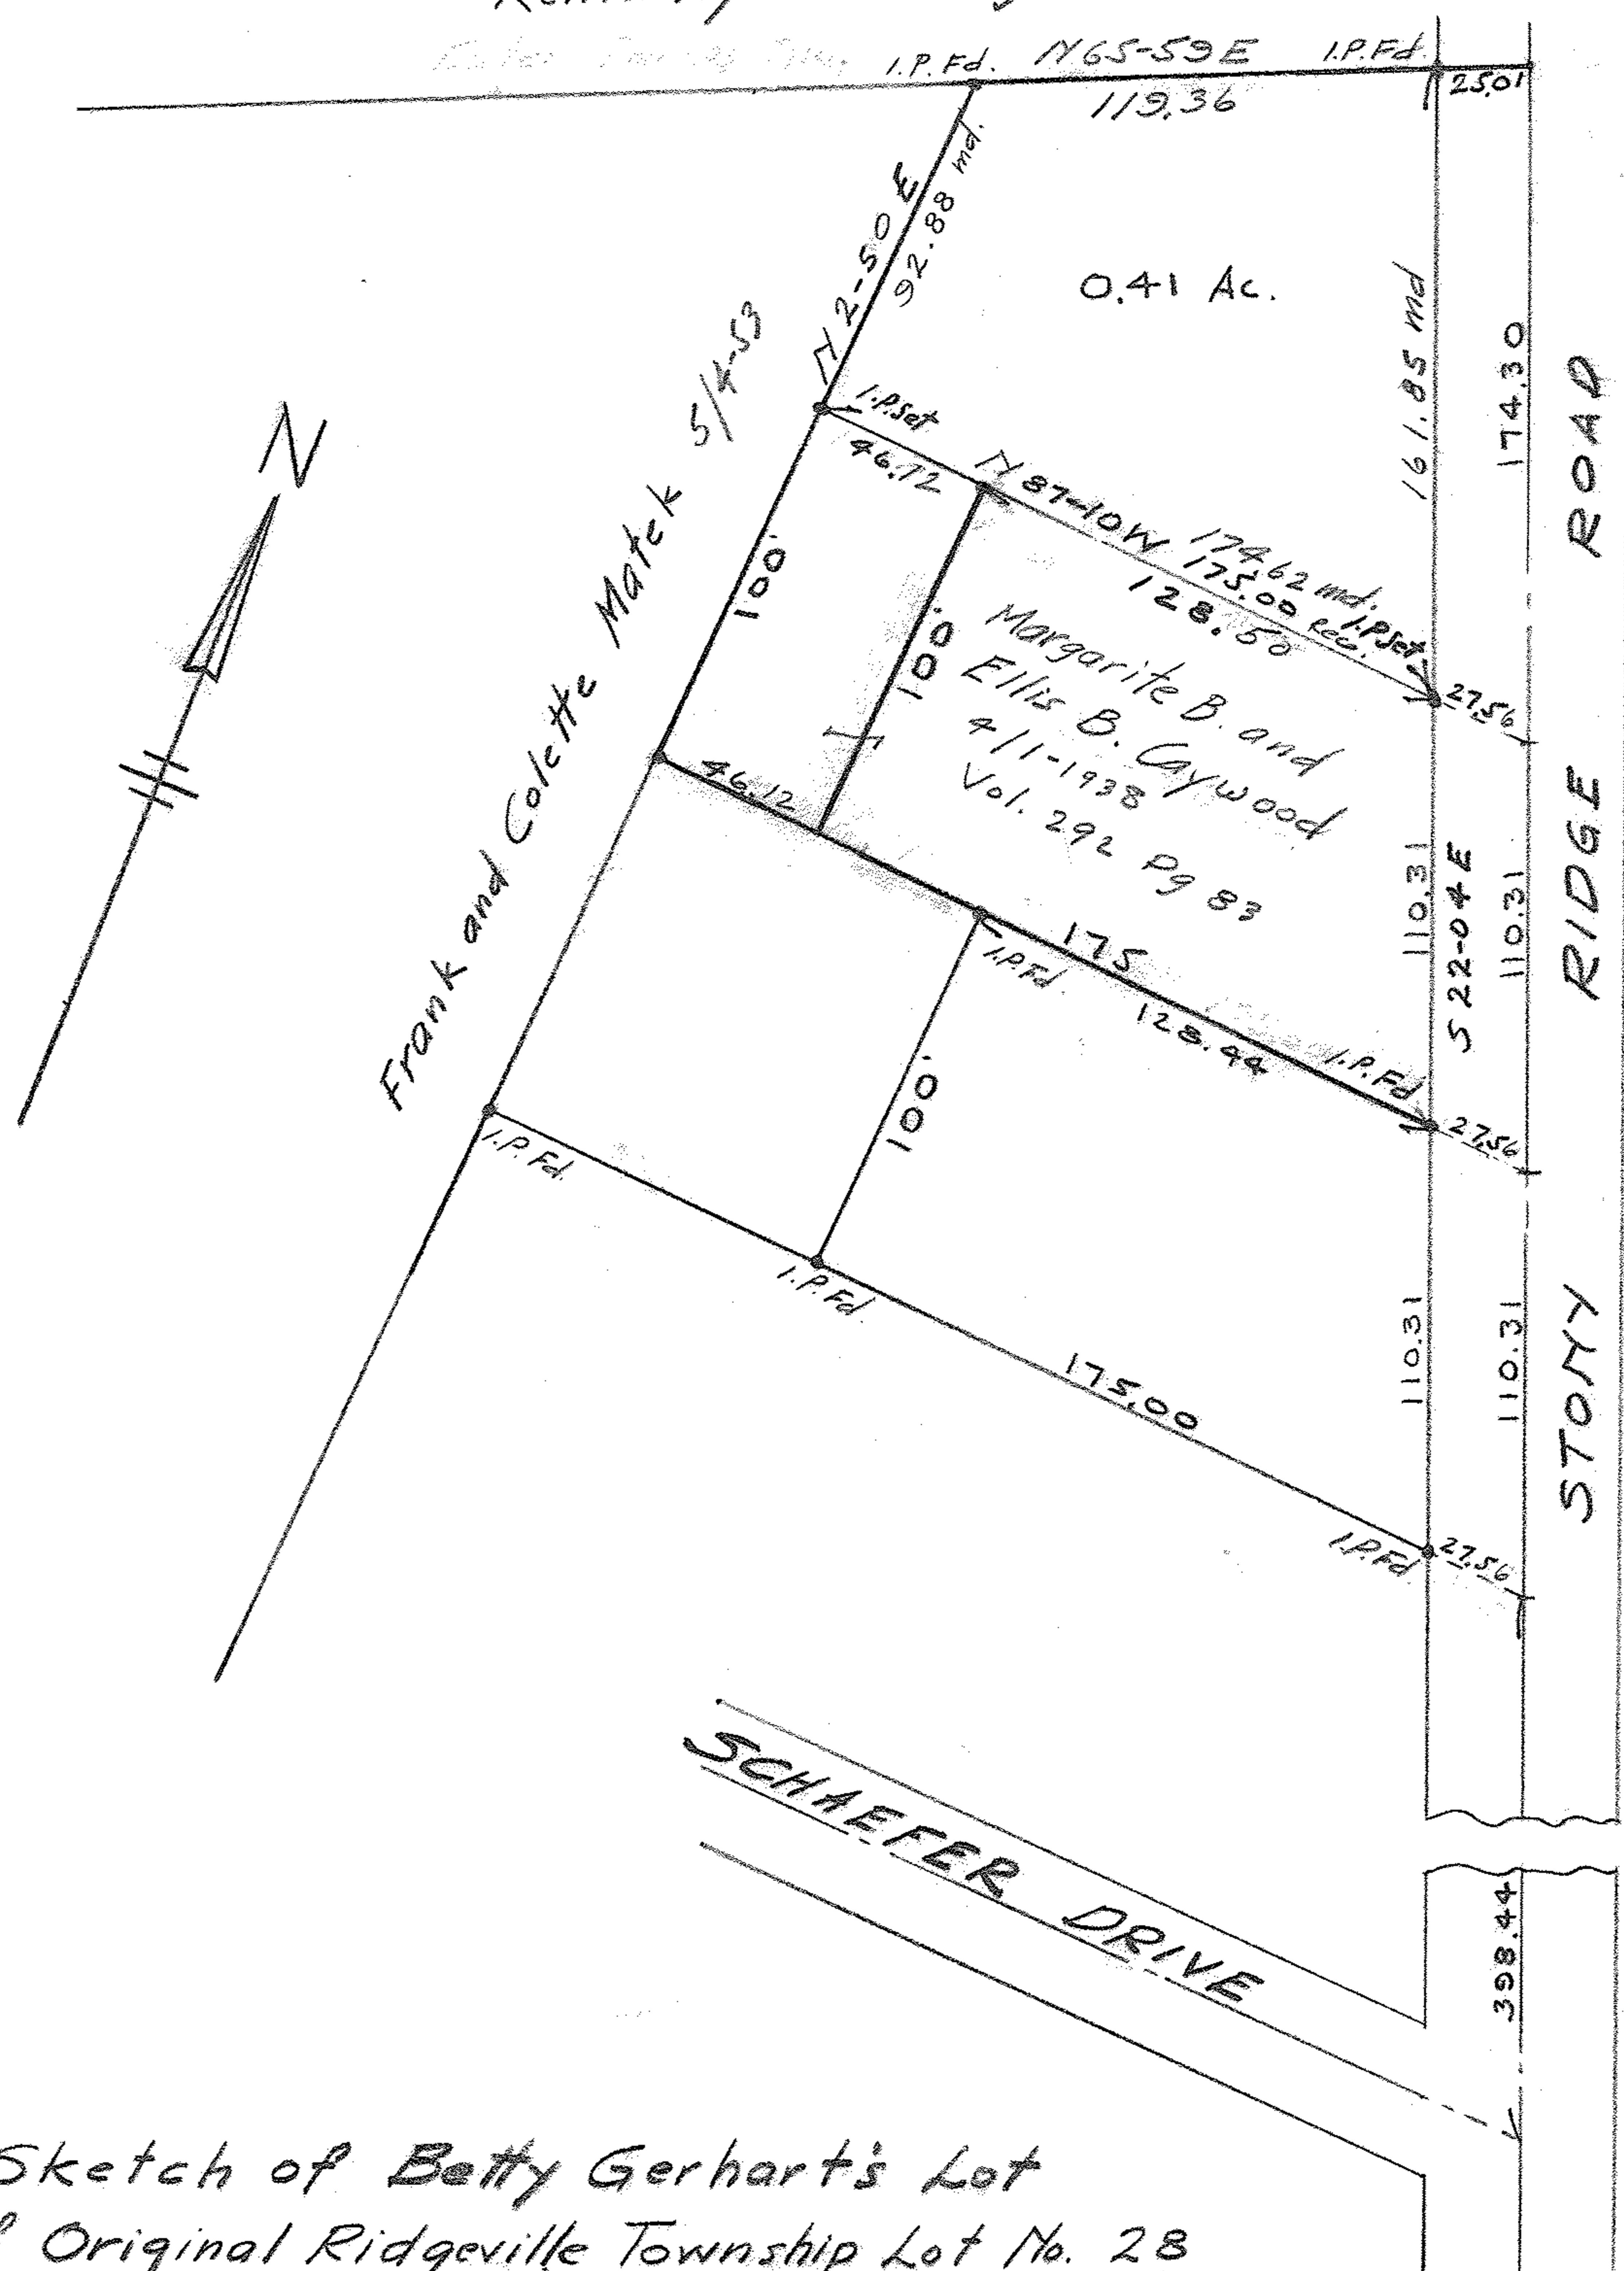

Survey Sketch of Betty Gerhart's Lot
In Part of Original Ridgeville Township Lot No. 28
Lorain County Ohio Scale: 1" = 50'
April 26, 1958 J.H. Getz Reg. Engineer and Surveyor