
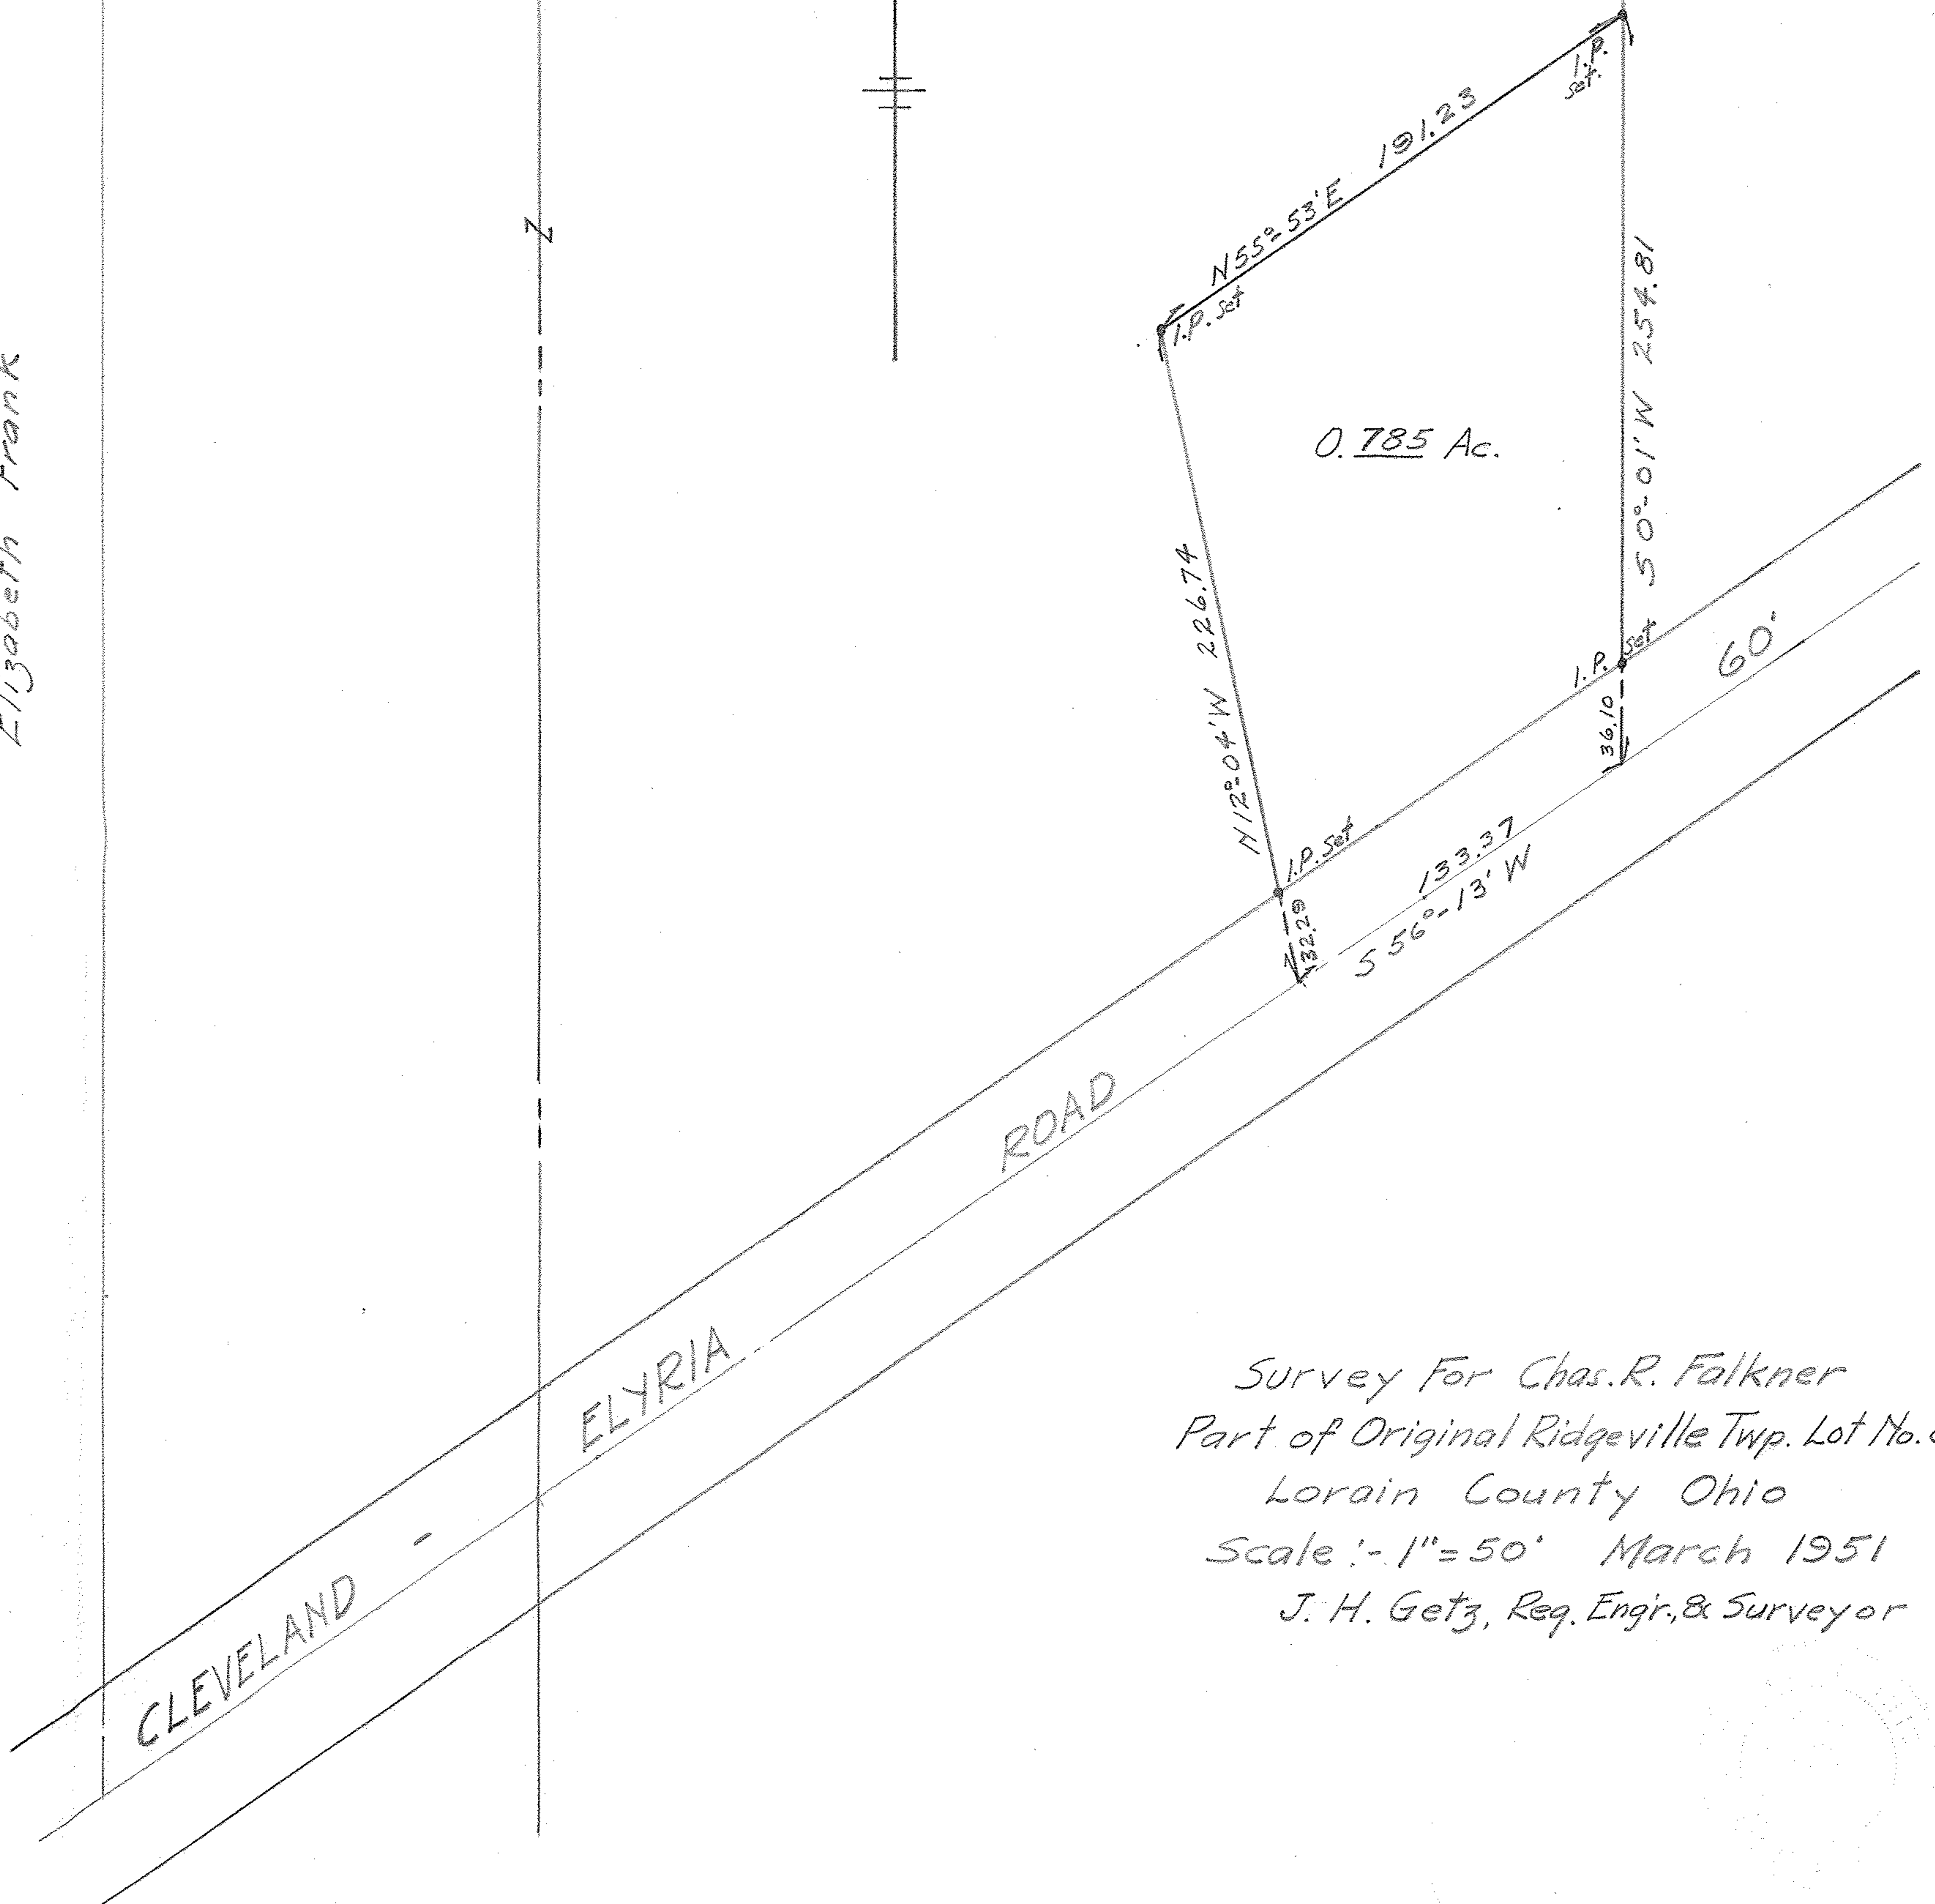


Neils Kjaer  
43018

Elizabeth Frank

0.L. 17  
0.L. 8

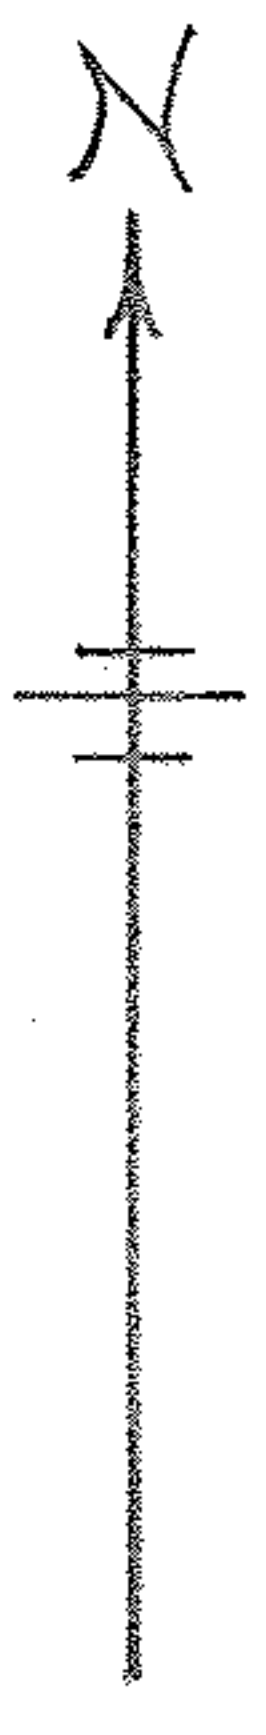

Survey For Chas. R. Falkner  
 Part of Original Ridgeville Twp. Lot No. 8  
 Lorain County Ohio  
 Scale: - 1" = 50' March 1951  
 J. H. Getz, Reg. Engr. & Surveyor

