


A.O.B. 10-5-49

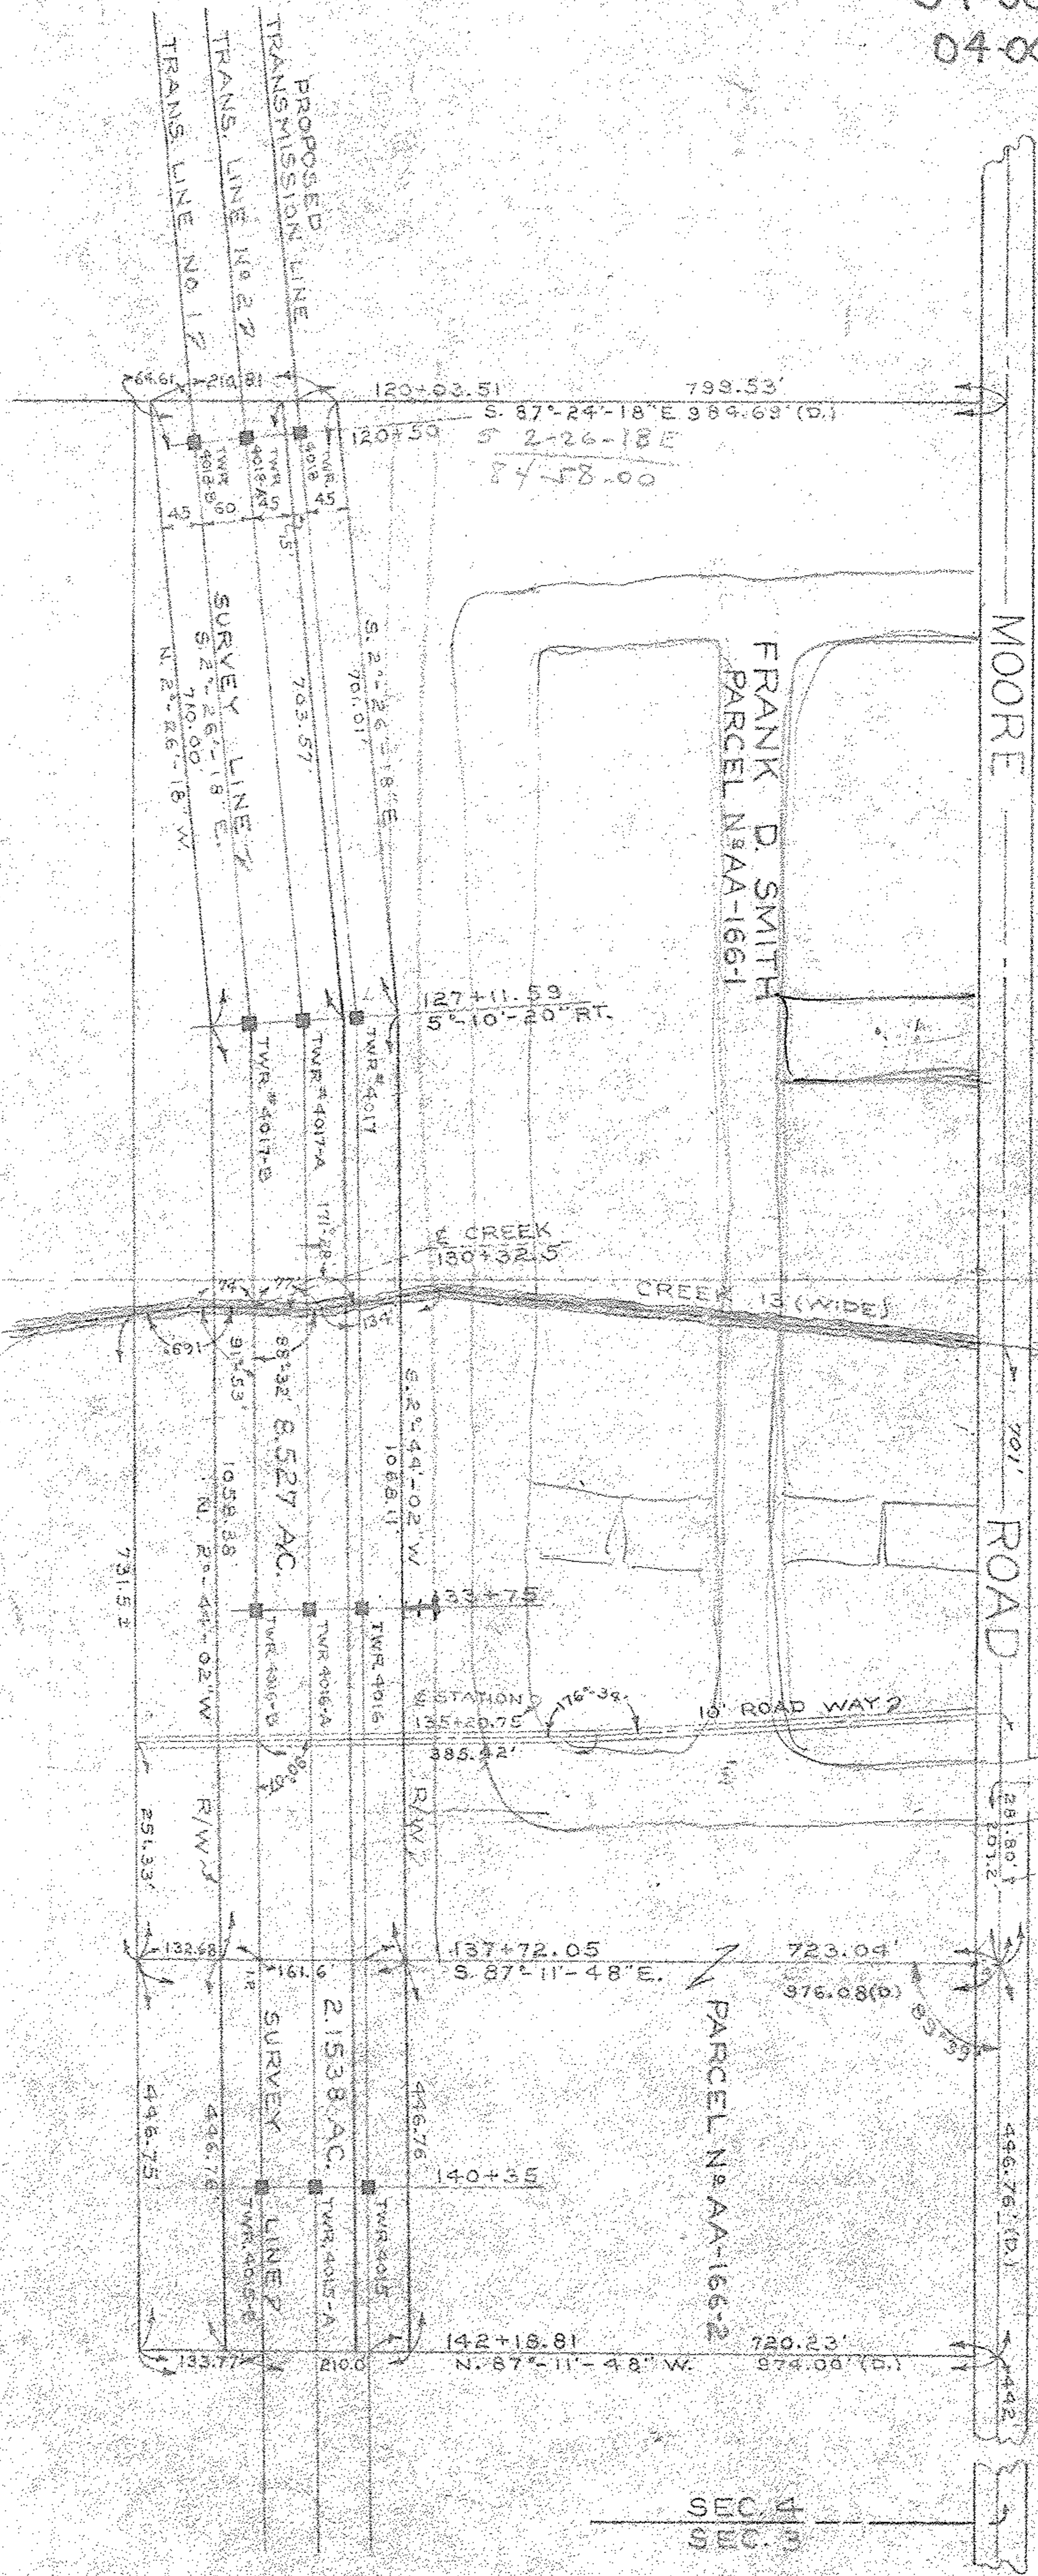

PARCEL N^o AA-166-1 & 2

ADDED 13 FT CREEK
AND 10 FT ROAD WAY
ADDED CHESTER ROAD 8/21/52

PARCEL N^o AA-166-1 & 2
VILLAGE OF AVON
PT. OF ORIG. AVON TWP. SEC. 4, LORAIN CO.
SCALE 1" = 200'