


04-00-010-III-???

04-00-010-G

8POET

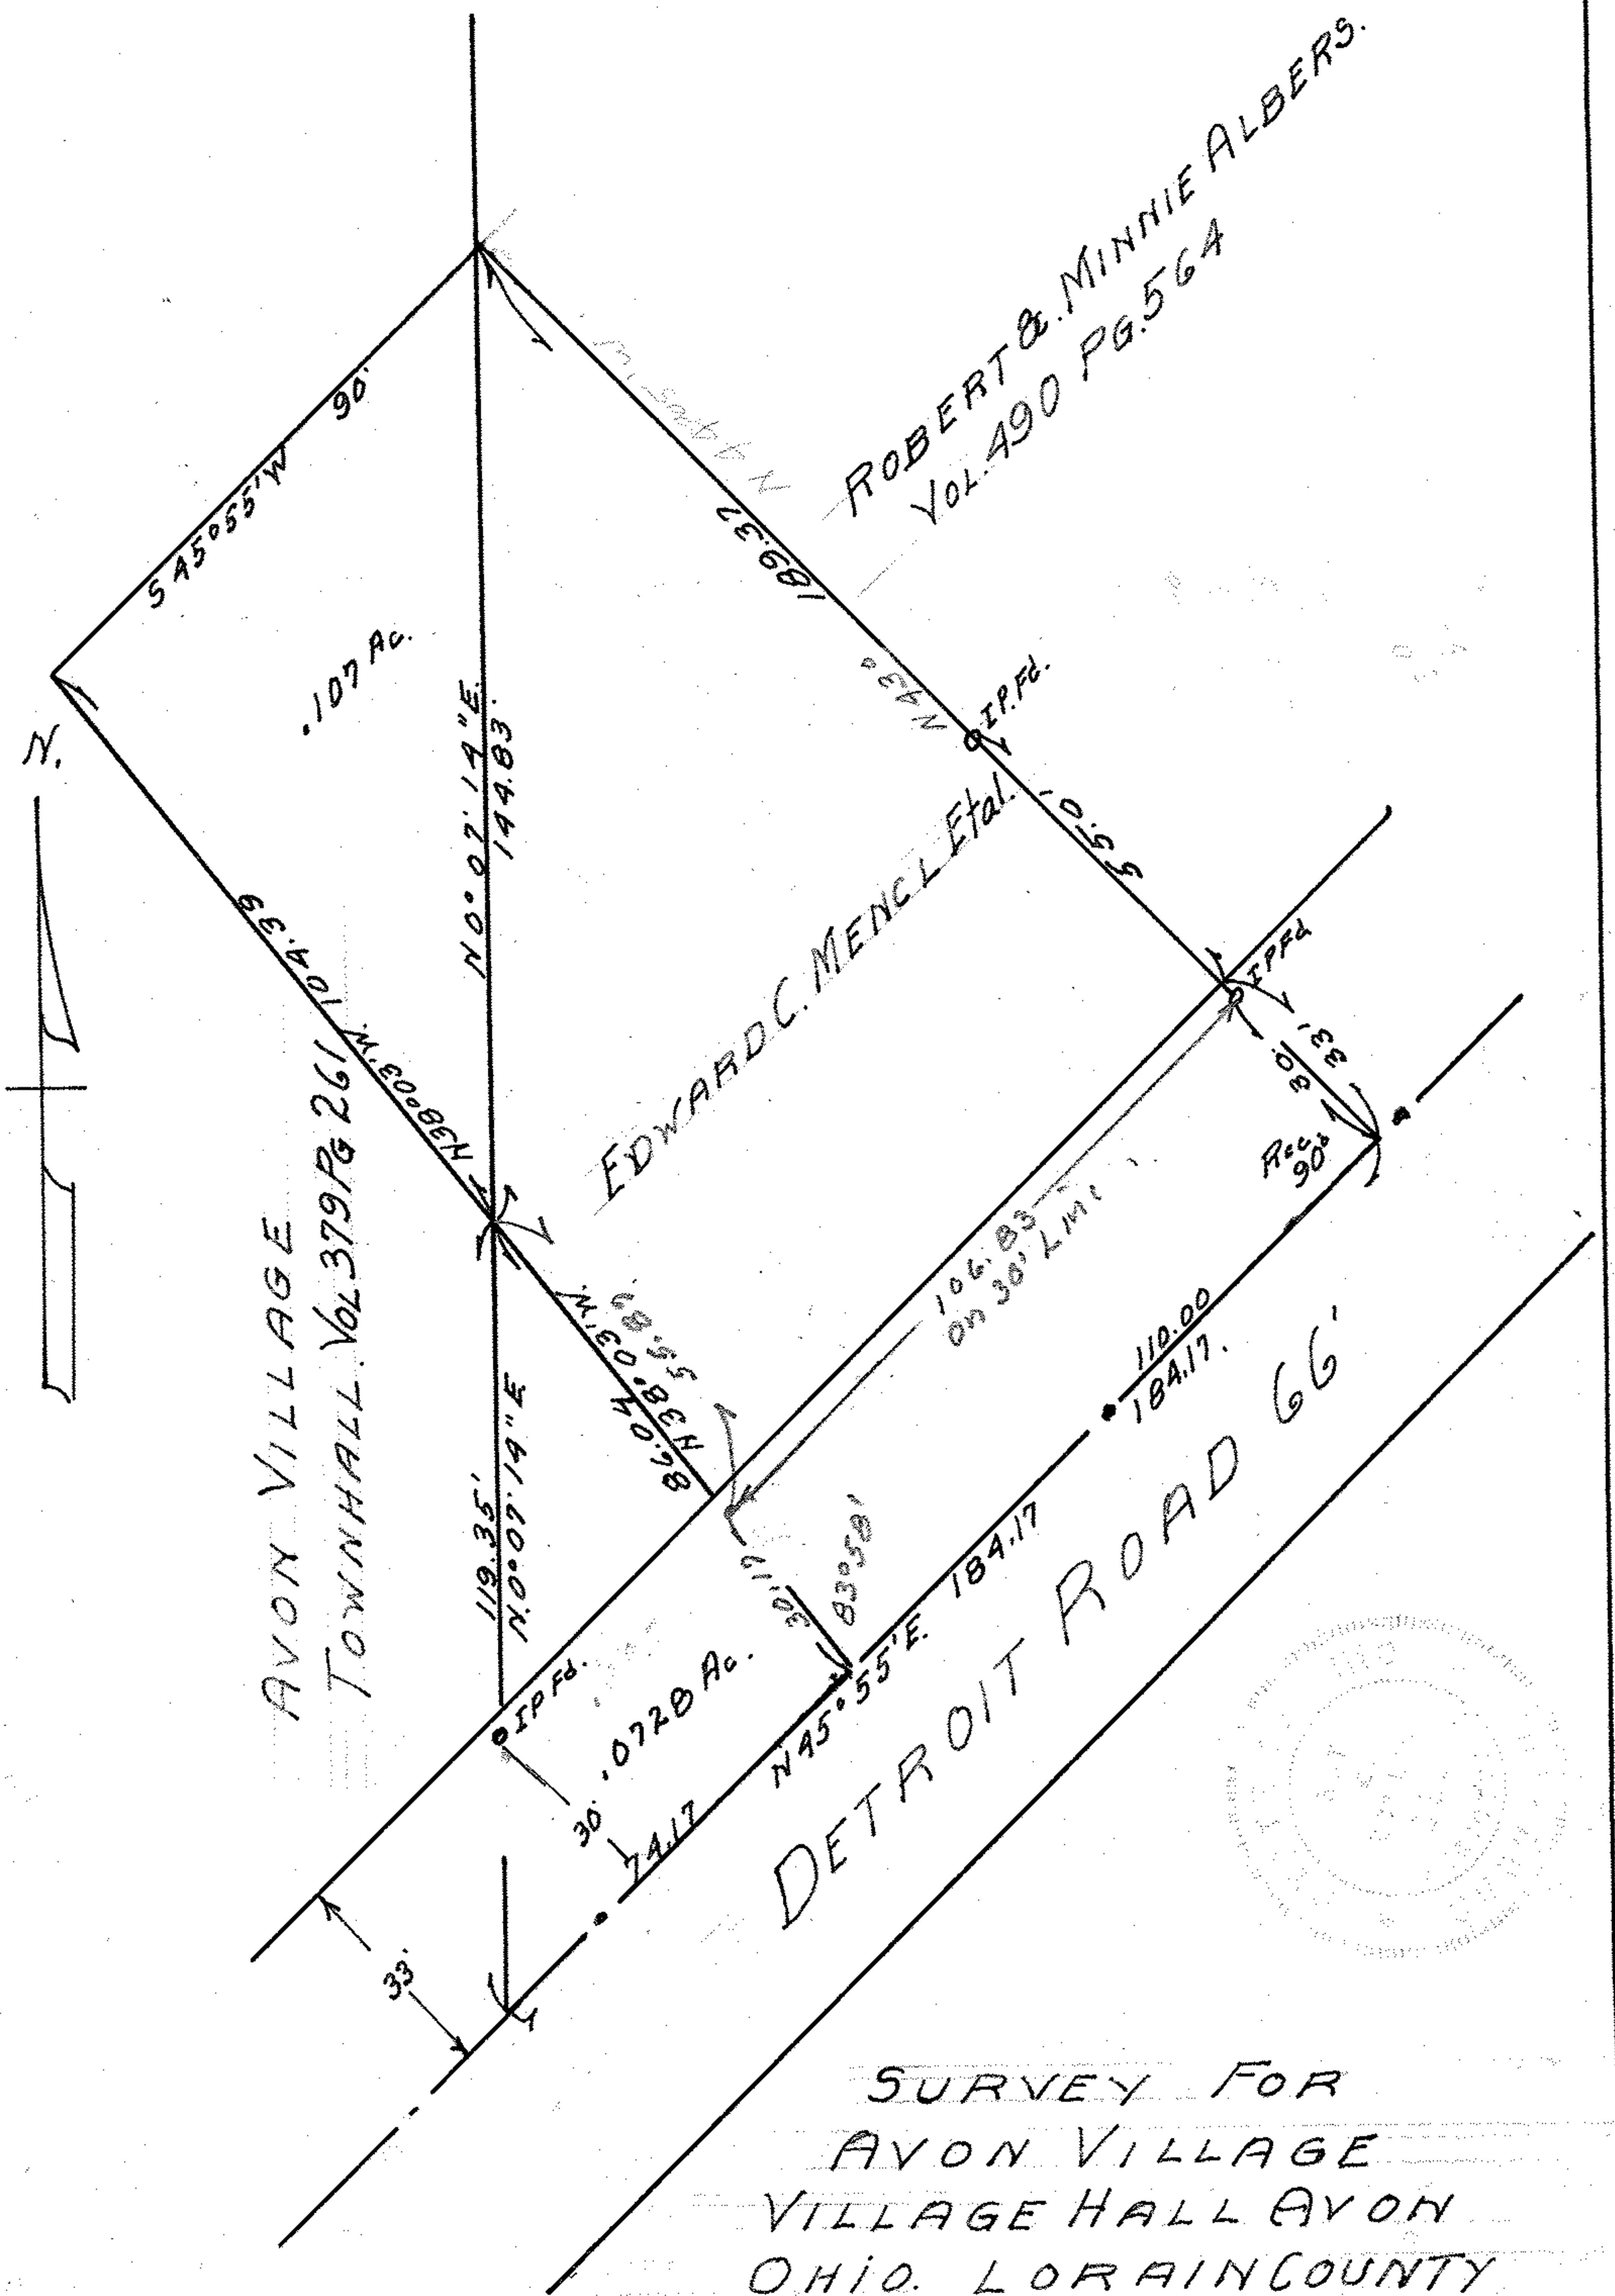


ROBERT & MINNIE ALBERS.  
 Vol. 490 PG. 564

EDWARD C. MENCEL ET AL.

AVON VILLAGE  
 TOWNHALL VOL. 379 PG. 261

DETROIT ROAD 66'

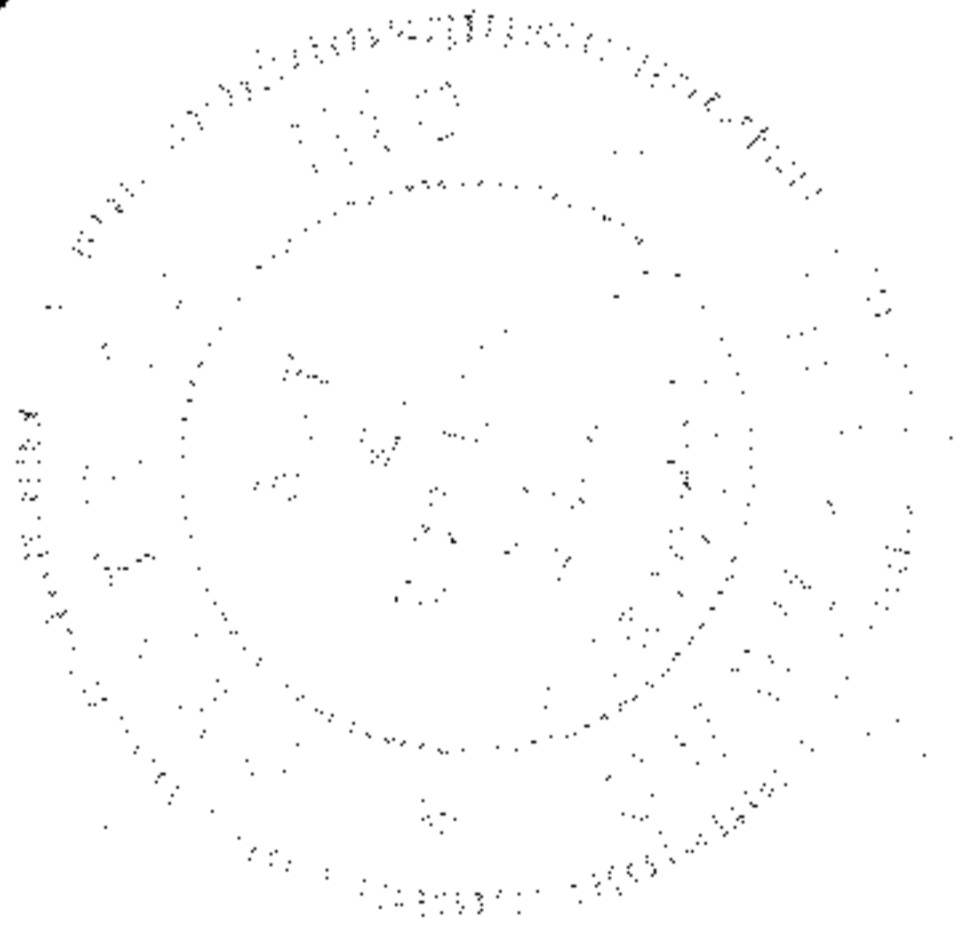

SURVEY FOR  
 AVON VILLAGE  
 VILLAGE HALL AVON  
 OHIO. LORAIN COUNTY  
 SCALE 1"=30' APRIL 12 1958  
 BY RAY E. HOLLIS VILLAGE ENG.  
 B 4-00-010 (-) 57

FB 143 P. 3

4-20

PLIHA.