


05-00-048-000-022
 023
 05-00-048-B 024
 05-00-053-000-002
 05-00-053-A

5

20104



THEODORE CSINGSAK.
 DEED DATED MARCH 25 1946 VOL 381 PG. 477
 N1°49'E 595.51

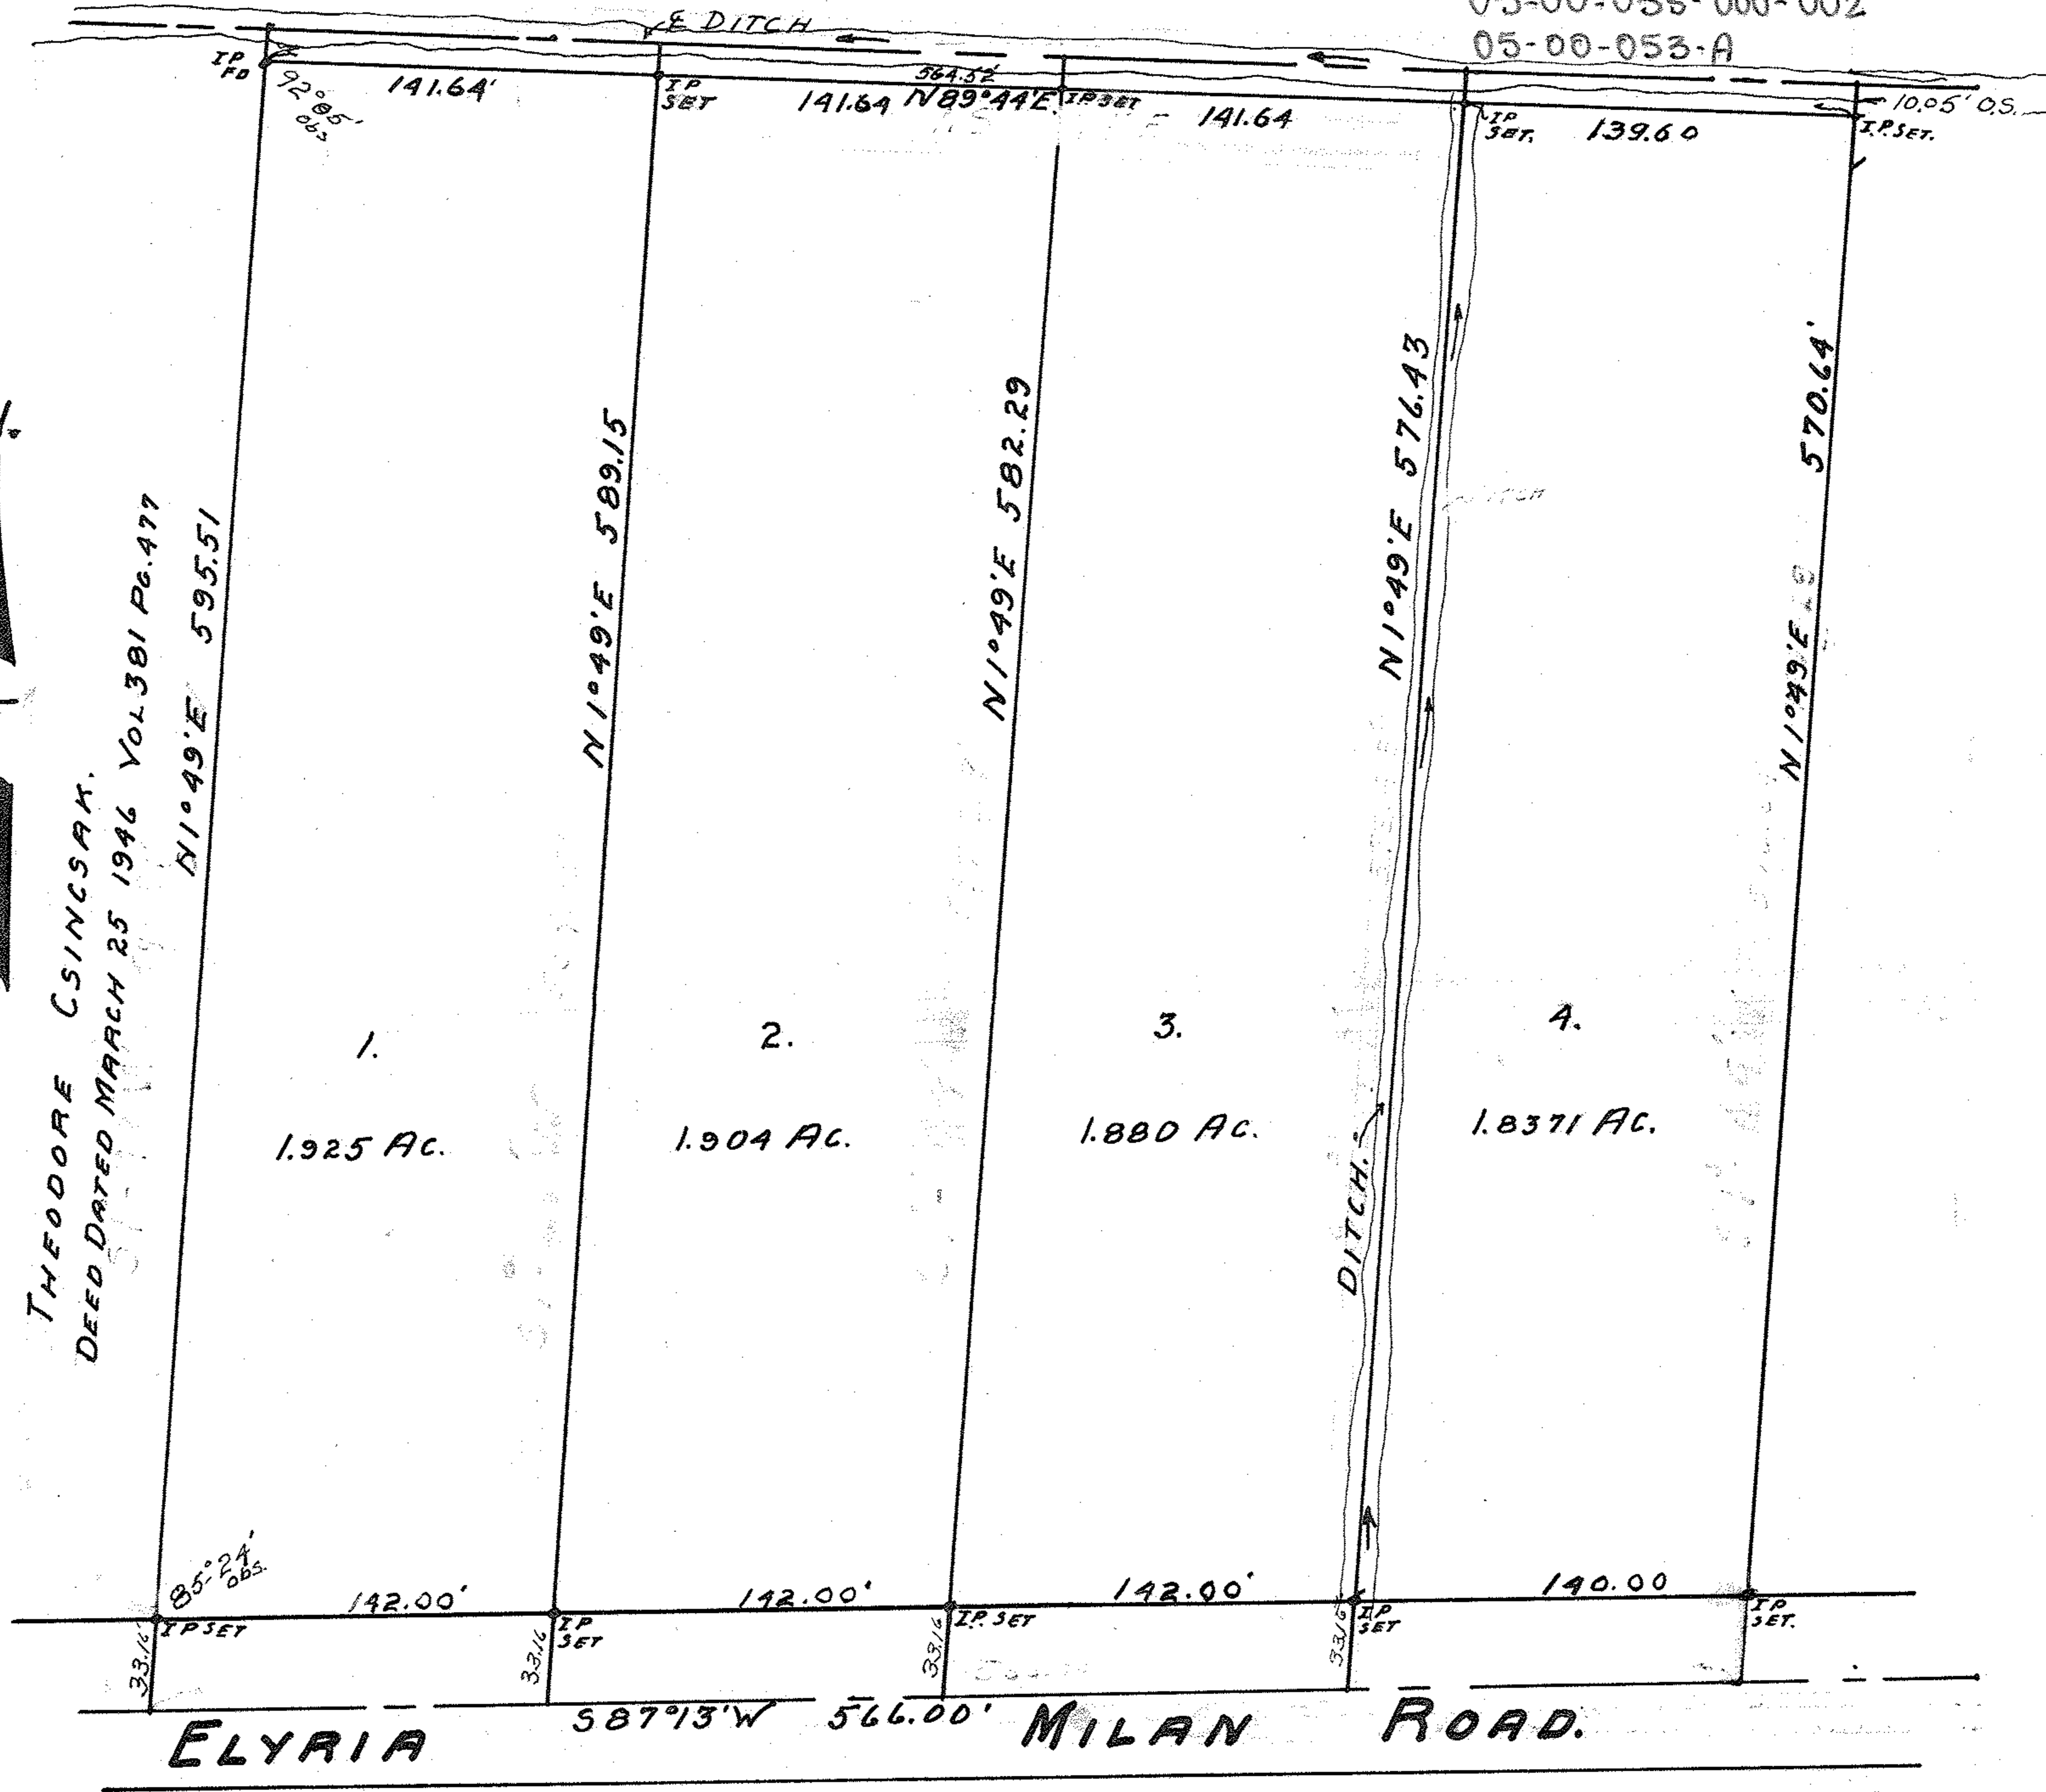

SURVEY FOR
 CLARENCE E. & CLARA COOK.
 AMHERST TOWNSHIP. D.L. 48
 LORAIN COUNTY, OHIO.
 SCALE 1"=60' MAY. 8. 1946
 BY RAY E. HOLLIS REG. ENG. & SURVEYOR. ① 5-45