

02-01-004-105-021

022

PT 104

023

02-01-004-B

024

E SIXTH ST

Sewer Elevations.

Gr. El. Broadway Sewer opp. S. line Bank Bldg = 15.95
 " " " " N. " Pierce " = 16.38
 " " Sixth St " " W. " Bank " = 19.15
 " " " " " " E. " Alley " = 19.57


Broadway Sewer is Brick, 45" X 35 3/8" inside.
 Sixth St " " 9 inch Pipe.

Survey of property at Broadway and Sixth Streets, Lorain, Ohio, formerly own by The Century Building Company and now owned by Joseph Gould and being parts of lots 1, 2 and 5 and all of lots 3 and 4 in Chamberlain, Edison & Mussey's Addition to Lorain and also part of Original Lot 4, Tract 1, Black River Township.

Figures underscored represent elevations.

Nichols & Loofbrow
 Civil Engrs.

SCALE 1" = 20'

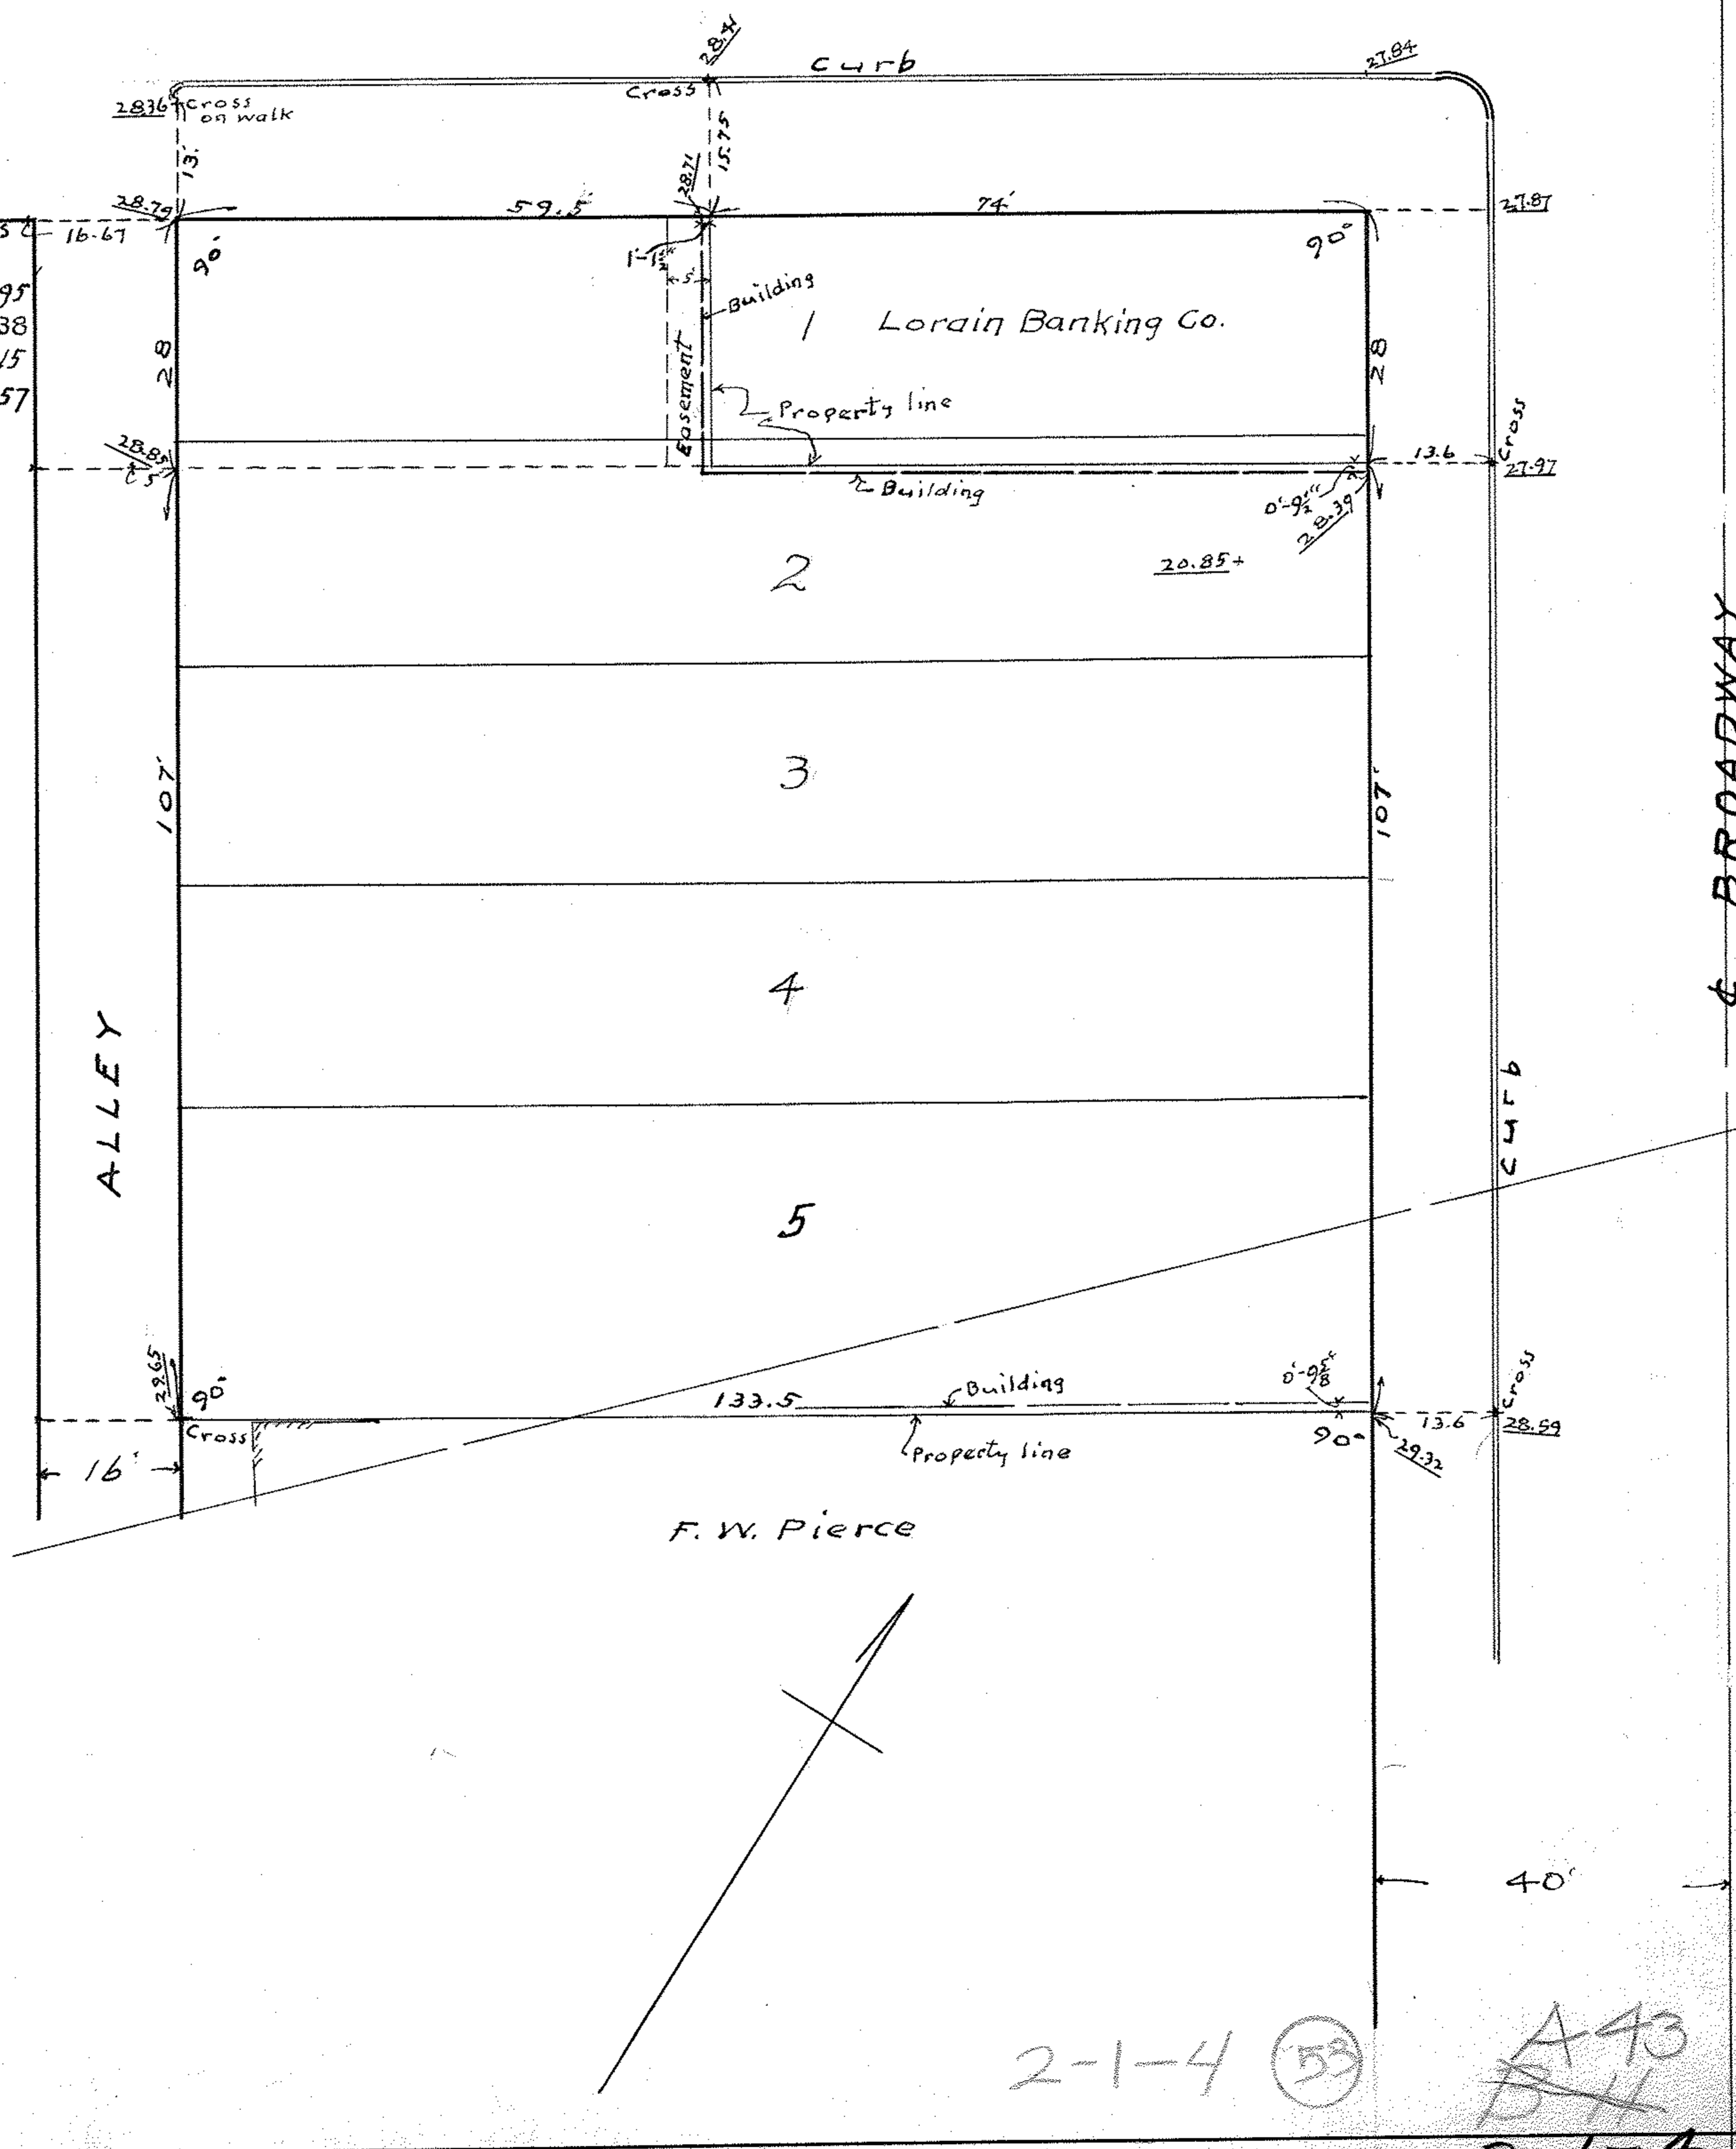

2-1-4

53

A 43
B H

2-1-4