
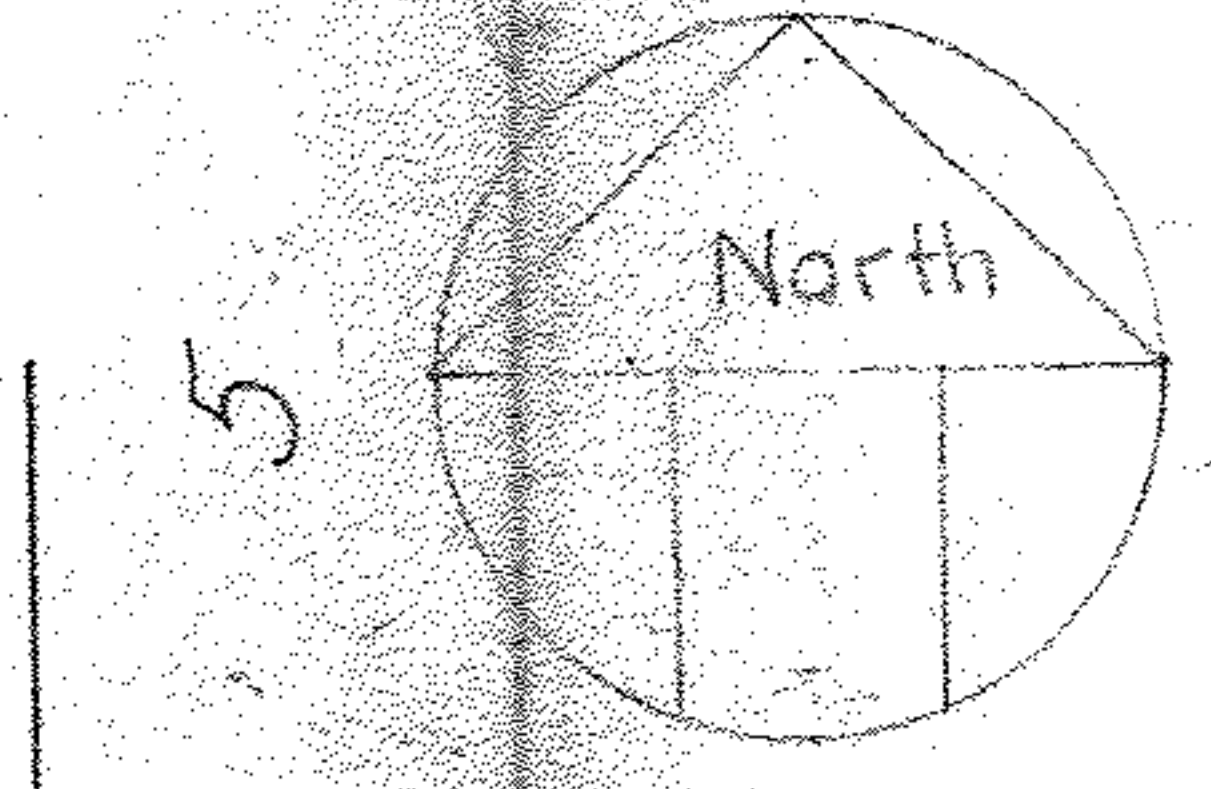


THE BOARD OF EDUCATION OF THE
WELLINGTON VILLAGE SCHOOL DISTRICT

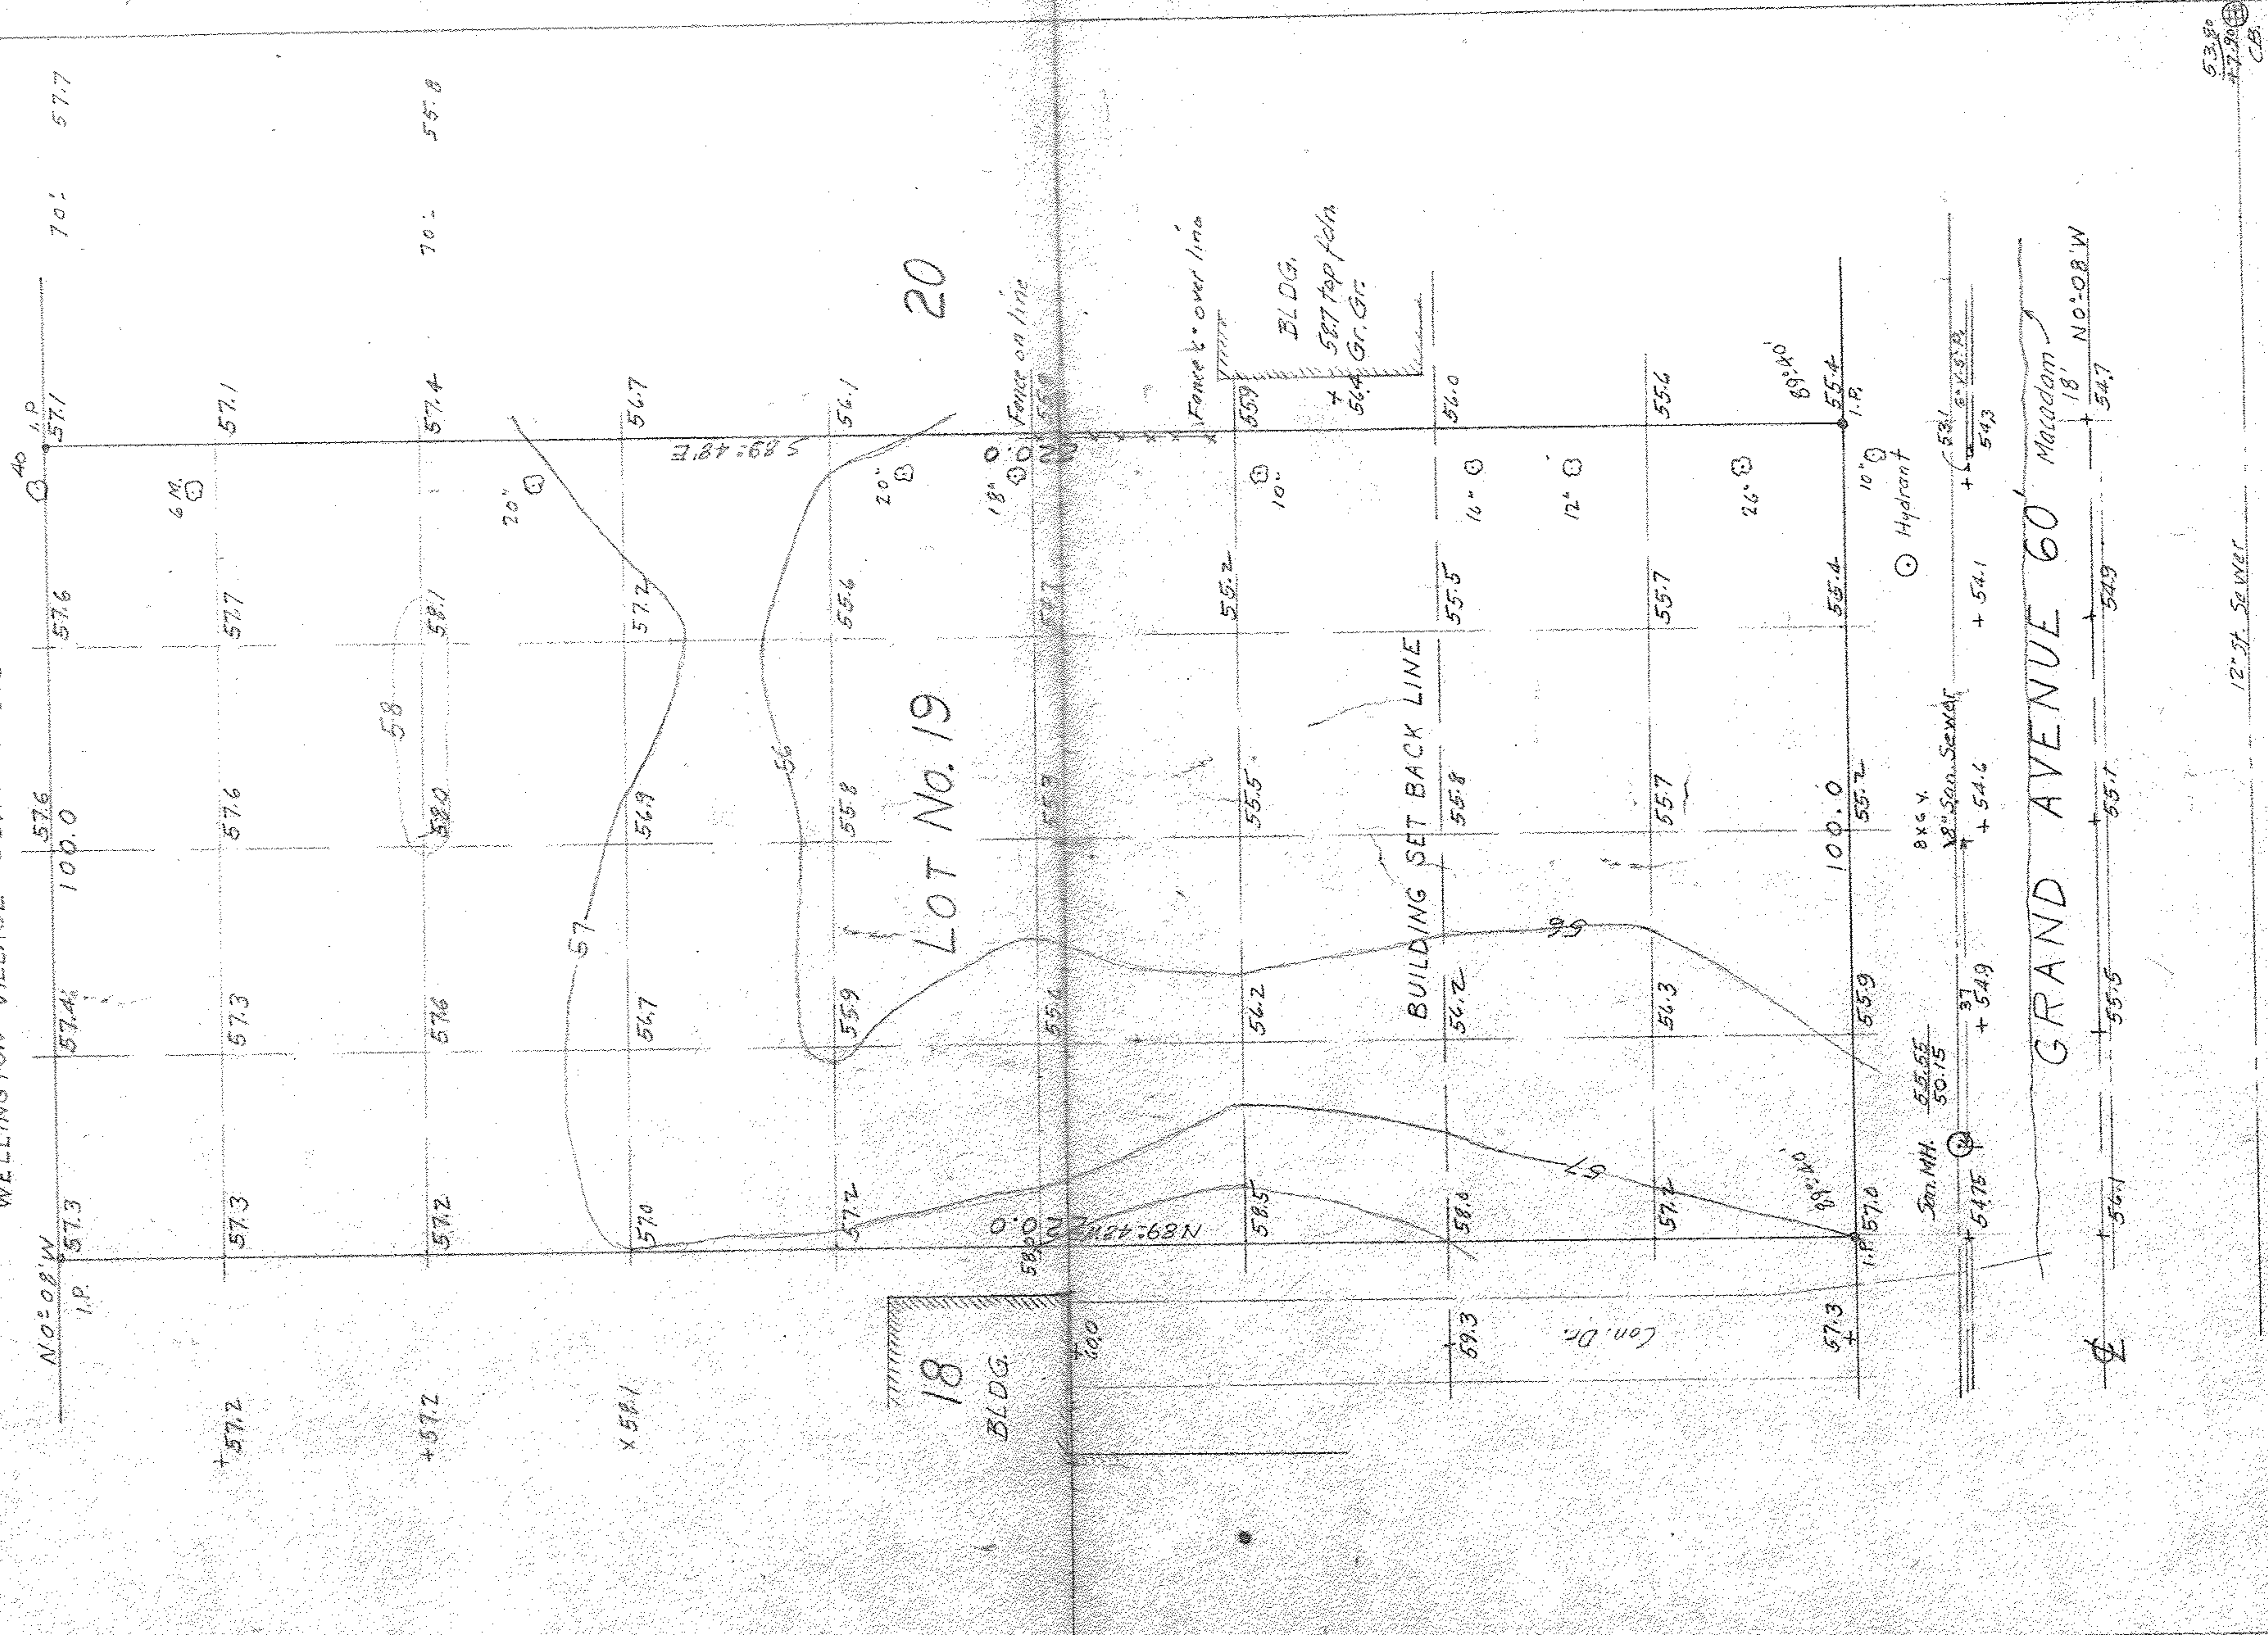

SURVEY FOR HARRY W. WAGNER
LOT 19 EASTERN HEIGHTS SUBN
WELLINGTON VILL. LORAIN CO OHIO.
SCALE 1"=20'
JULY 1, 1953
T.W. LAUNDON REG. SURVEYOR,