

19-06-105-000-003  
19-05-005-000-003  
19-C

JAMES W. MCHENRY  
4-27-16 DV. 139 PG. 474

S. 89° 59' 58" E 2137.90

O.L. 108  
N. 0° 39' 40" W.  
169.62  
O.L. 105

I.P. Set  
N. 89° 59' 41" W.  
170.75  
I.P. Set

TRACT 6 O.L. 105  
TRACT 5 O.L. 5

4446  
MON. BOX  
I.P. Set

WALKO


N. 0° 15' 18" E. 1019.04'

37.9039 Ac.

INDIAN HOLLOW

KELLER

CARTER

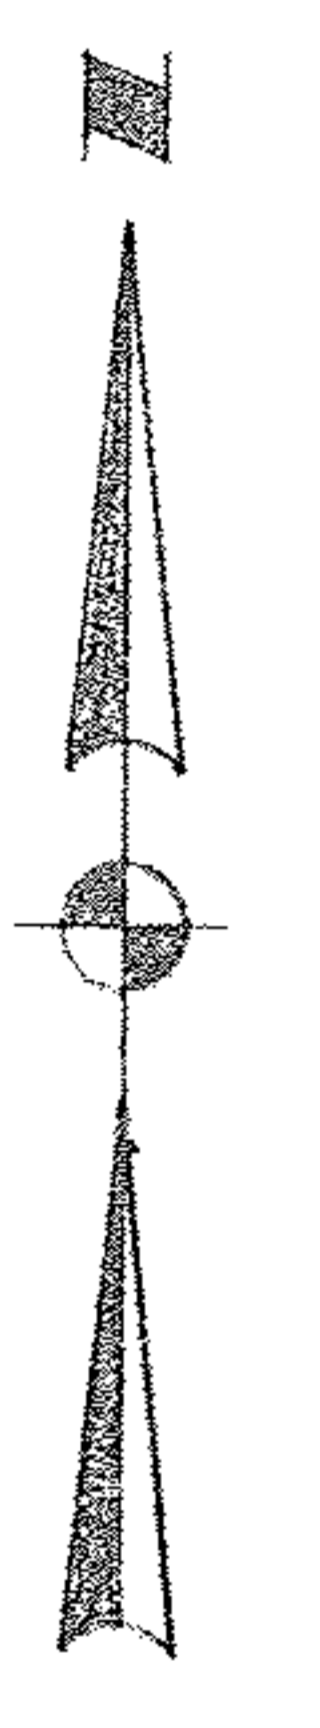

O.L. 5  
O.L. 6  
N. 89° 04' 07" W. 1119.38  
I.P. Fd. I.P. Fd. I.P. Fd. I.P. Fd.

S. 1° 54' W. 340.56'

S. 26° 41' W. 502.90'

S. 55° 47' W. 741.75'  
RD. 60'

18'

18' LANE TO LAGRANGE ROAD

SURVEY FOR PAUL E. BAUER

O.L. 105 TRACT 6 O.L.s 5 & 6 TRACT 5 PENFIELD TWP.  
COUNTY OF LORAIN STATE OF OHIO  
SCALE 1"=100'  
NOV. 1973  
LAUNDON · SIMON · CAHL & ASSOC. - ENGINEERS & SURVEYORS