


CLEVELAND ELECTRIC ILLUMINATION COMPANY  
VOL. 97, PG. 763

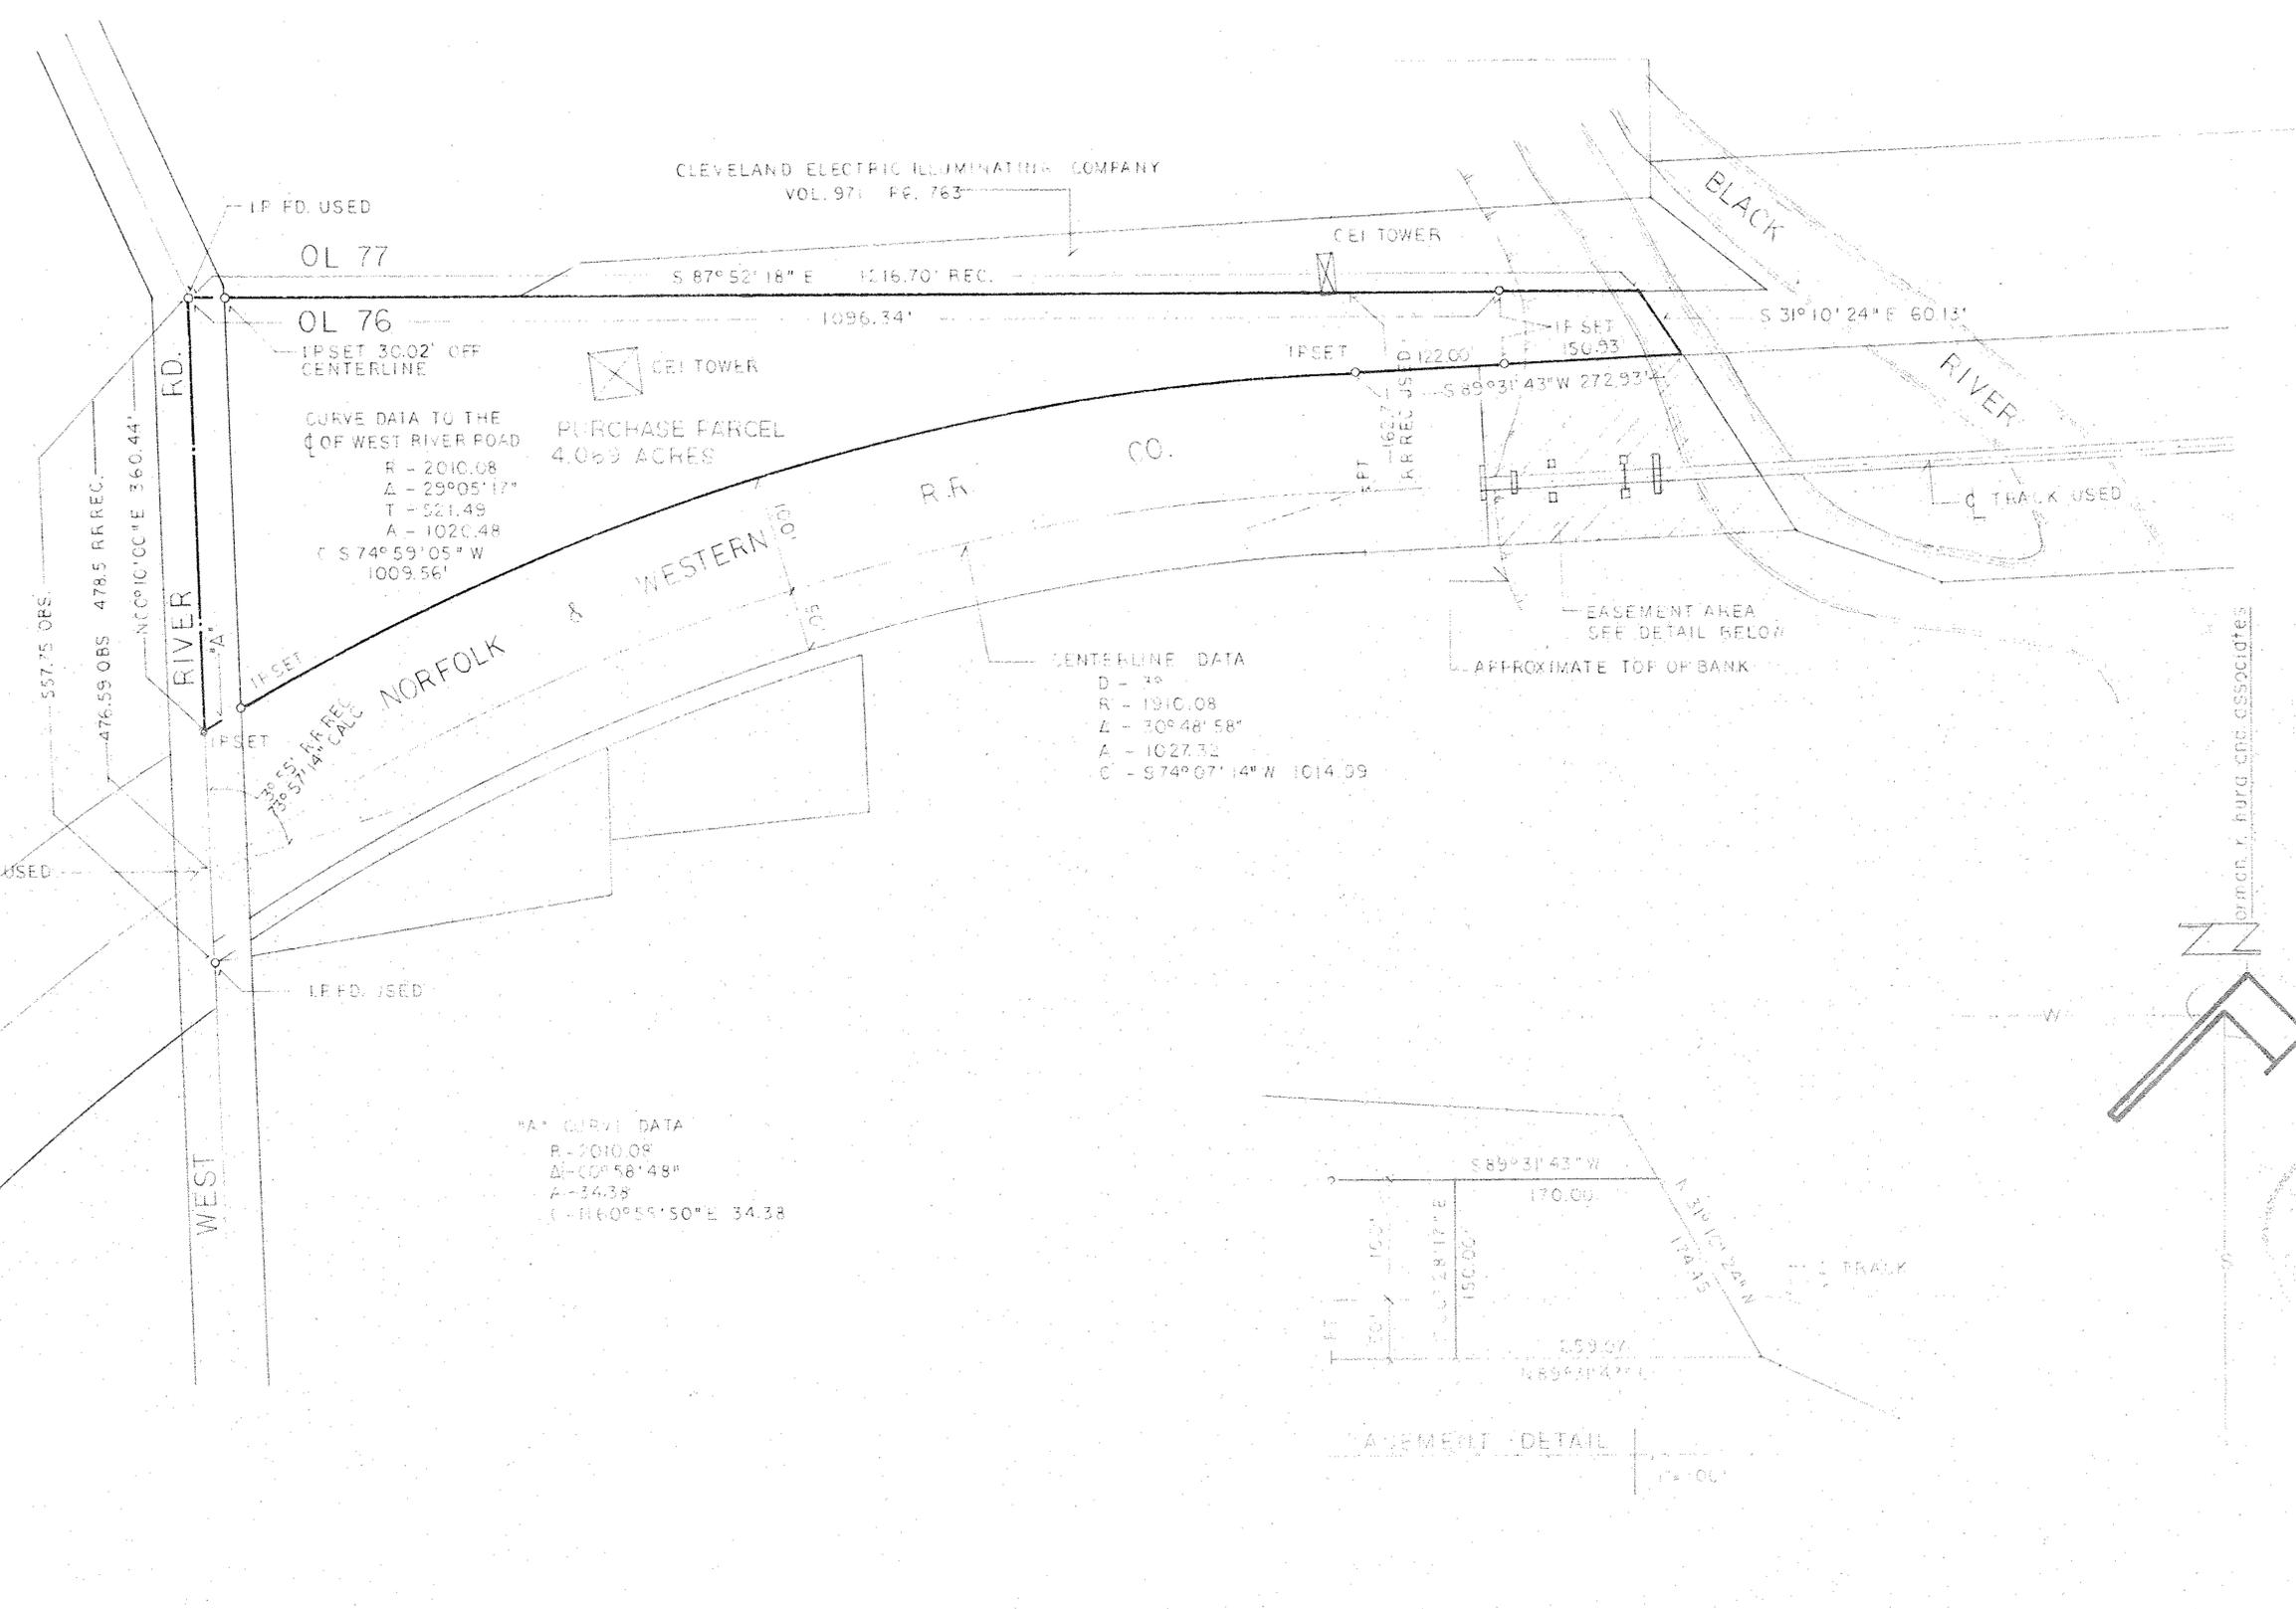

OL 77

OL 76

CURVE DATA TO THE  
Q OF WEST RIVER ROAD

R - 2010.08  
 Δ - 29°05'17"  
 T - 321.49  
 A - 1020.48  
 C - S 74°59'05" W  
 1009.56'


PURCHASE PARCEL  
4.069 ACRES

CENTERLINE DATA

D - 3°  
 R - 1910.08  
 Δ - 30°48'58"  
 A - 1027.32  
 C - S 74°07'14" W 1014.09

"A" CURVE DATA

R - 2010.08  
 Δ - 00°58'48"  
 A - 34.38  
 C - N 60°55'50" E 34.38

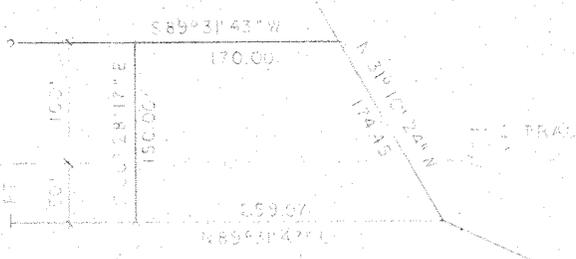

EASEMENT DETAIL  
1" = 100'



LORAIN COUNTY METROPOLITAN PARK DISTRICT

PLAN OF SURVEY  
FN 03-00-076-113-001

PART OF ORIGINAL SHEFFIELD TOWNSHIP  
LOT NO 76 - LORAIN COUNTY-OHIO

APRIL 1993  
SCALE 1" = 100' 0"