


TOTAL AREA =	3.90177	AS
TAKE AREA =	3.50	AS
REMAINDER =	0.40177	AS



TAKE AREA	
LAND AREA =	52.42150 AS
ZIVER AREA =	1.07820 AS
TOTAL =	3.50 AS

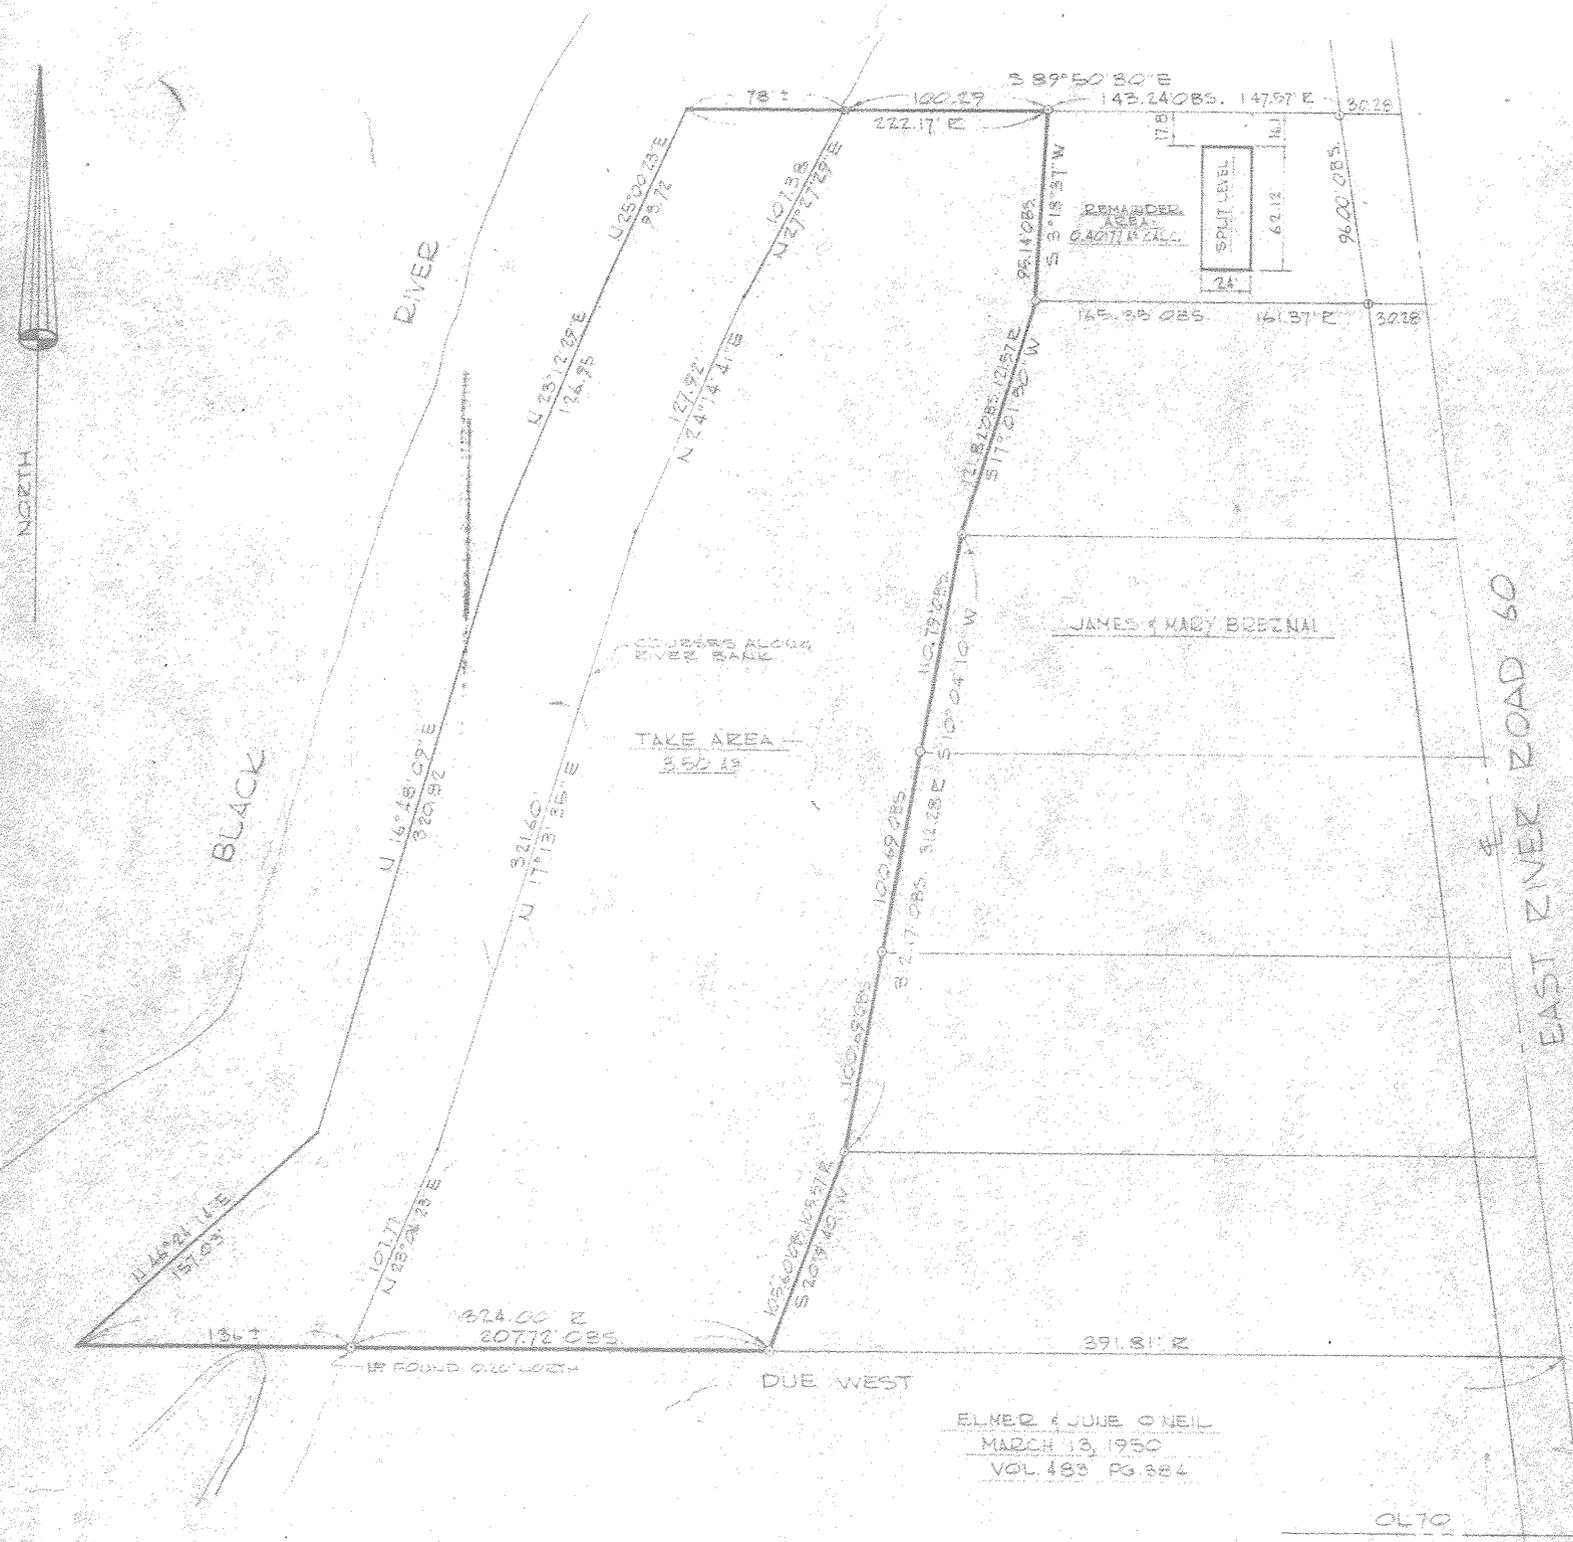

LEGEND
 IRON PIN FOUND ----- ○
 IRON PIN SET ----- ●
 RECORD ----- ○
 OBSERVED ----- ○

ELNEQ & JUNE O'NEIL
 MARCH 13, 1950
 VOL. 483 PG. 384

LORAIN COUNTY METROPOLITAN PARKS
 LAND ACQUISITION SURVEY
 GEORGE SZOYKA PROP.
 SHEPPARD TOWNSHIP

SCHAFFER, HURA & ASSOCIATES, INC.
 ENGINEERS AND SURVEYORS
 4656 OBERLIN AVE.
 LORAIN, OHIO

NBR
100

REVISOR 8-29-74 J72
 ORIGINAL DATE 3-13-50 DATE
 TOWNSHIP SHEPPARD DATE
 CITY OF SHEPPARD DATE
 COUNTY OF LORAIN DATE
 STATE OF OHIO DATE
 R. O. ZOSHA FILE NO.