


P.M.W

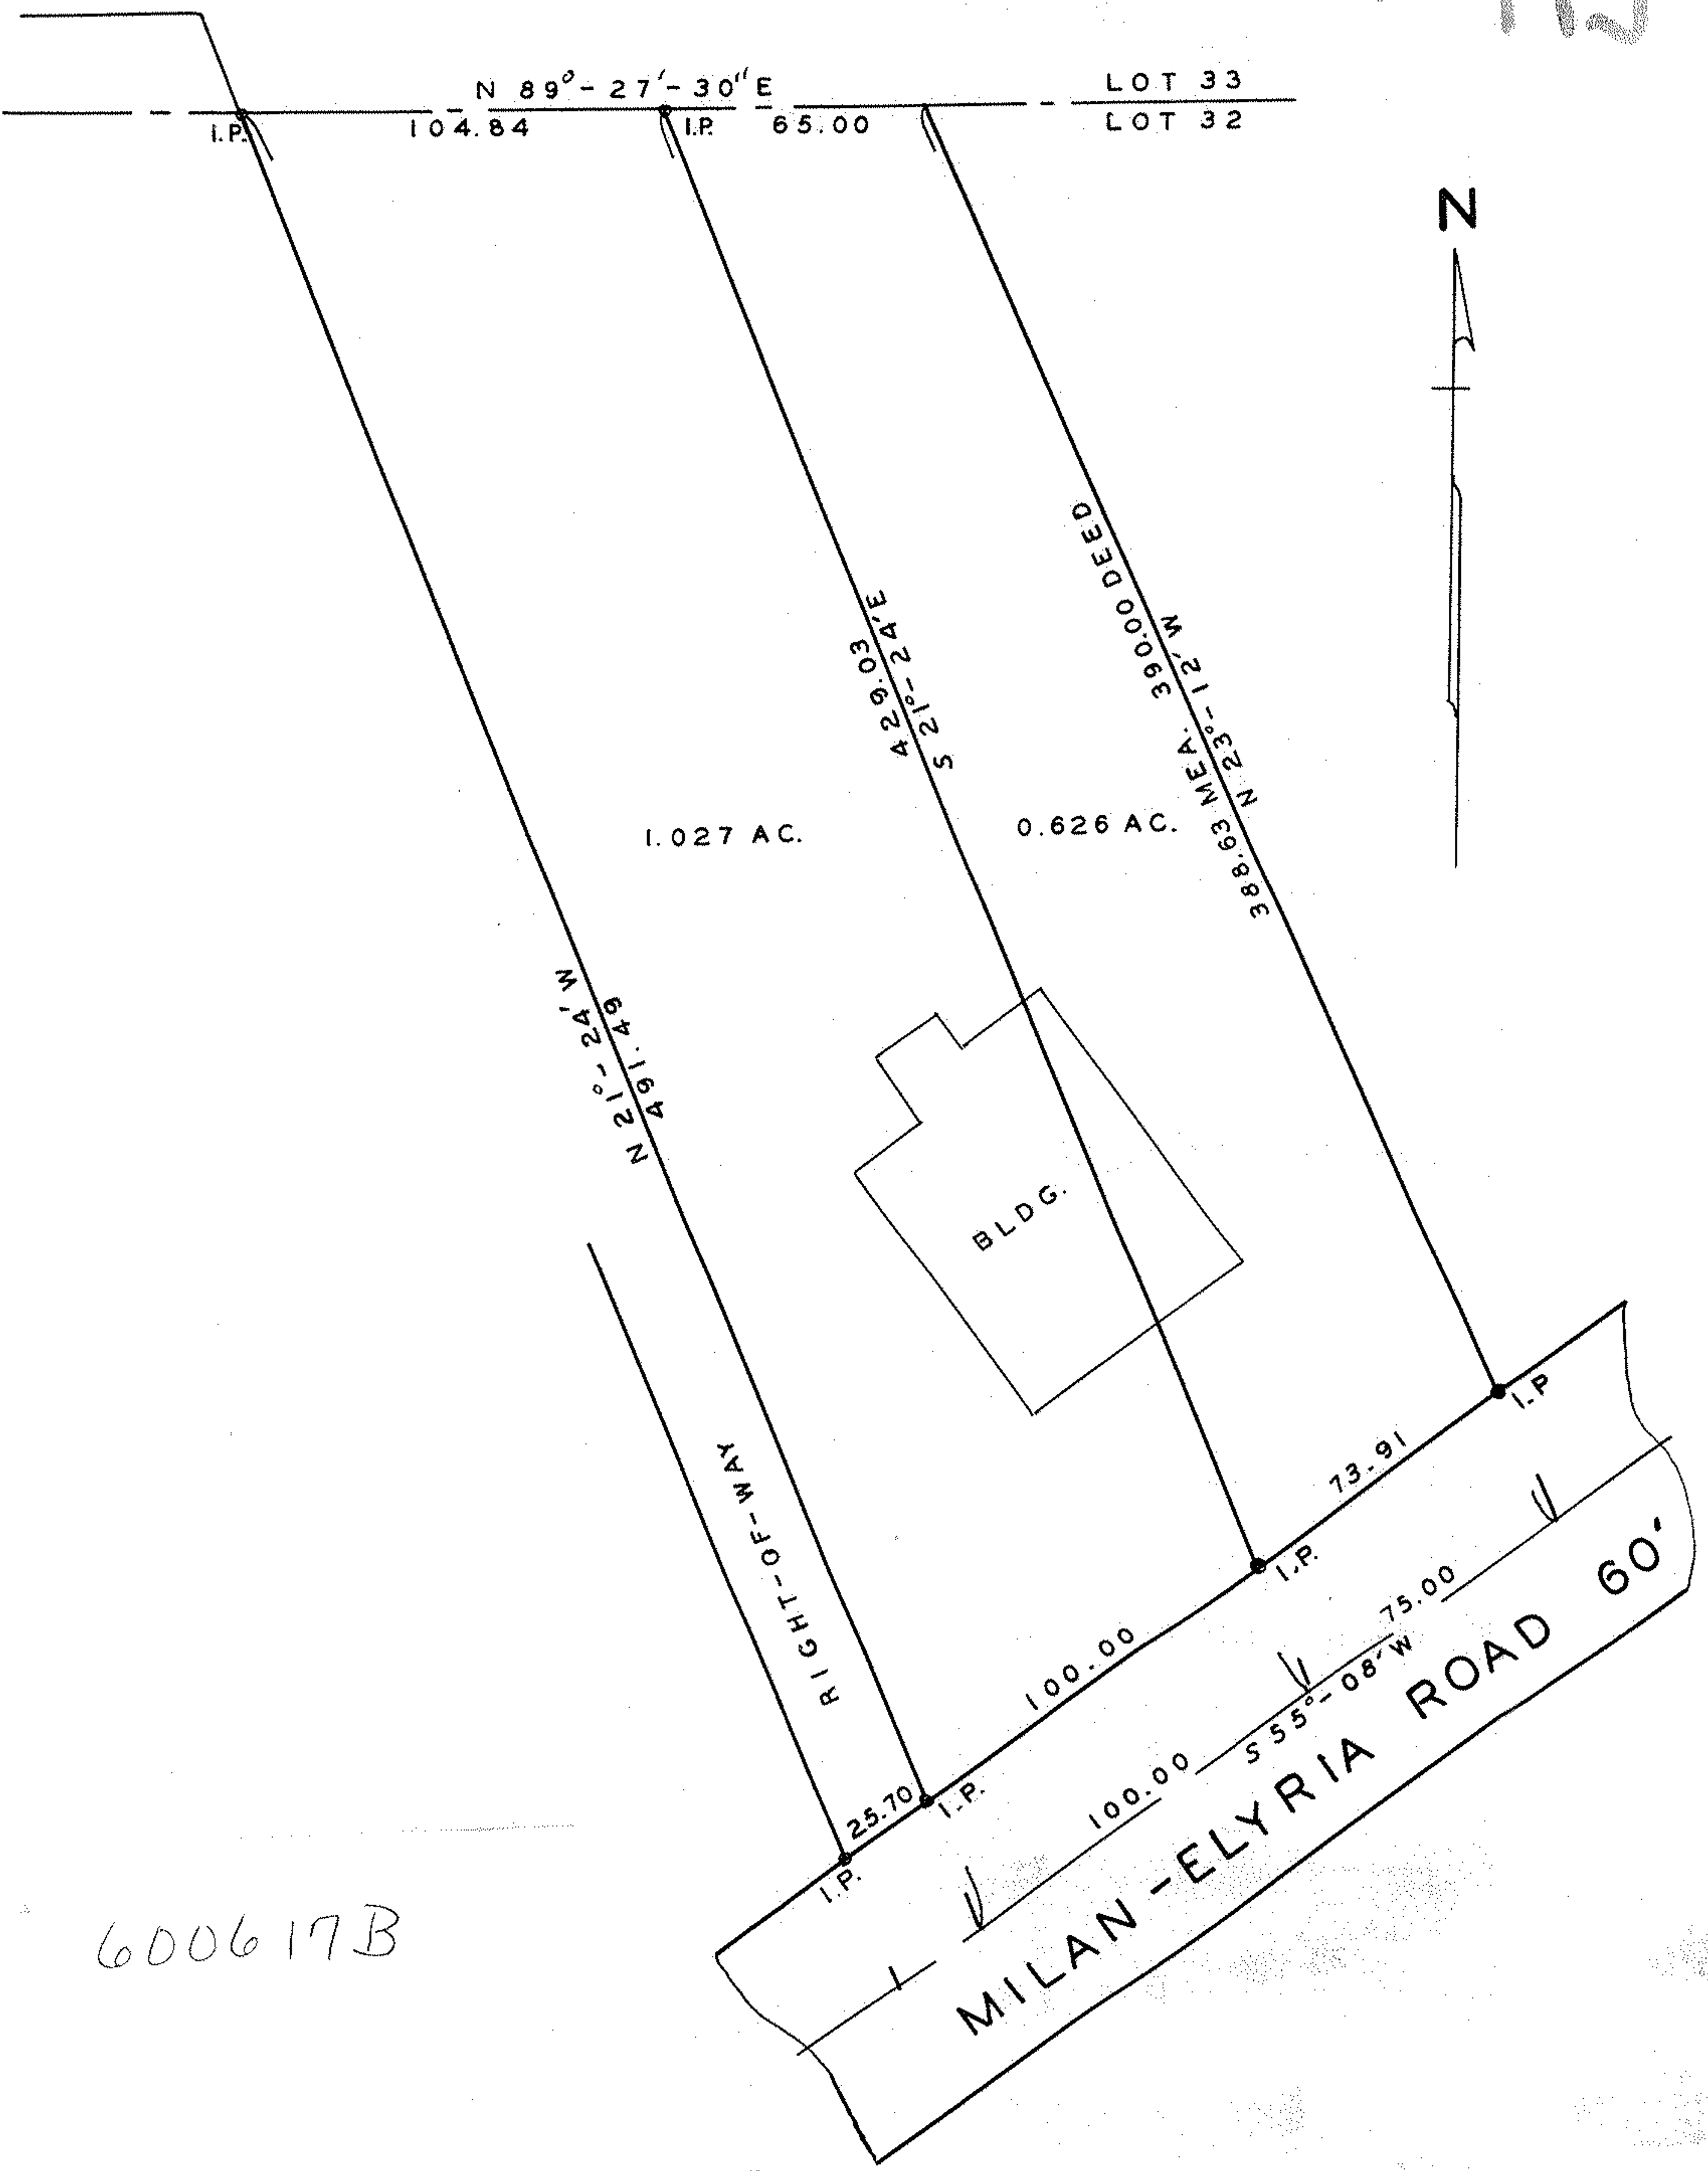

600617B

SURVEY AND LOCATION MAP
 FOR
SOUTH AMHERST TRACTOR SALES
 D-VOL. 648 PG. 195 OCT. 6, 1955
 D-VOL. 728 PG. 305 AUG. 14, 1958
 O. L. 32 AMHERST TOWNSHIP
 LORAIN COUNTY, OHIO
 SCALE 1" = 50' FEB 24, 1960
 J. W. WARDEN AND ASSOCIATES REG. SURVEYORS

MAP PLANS 00-032-A 05-00-032-000-023, 024