

J. W. WARDEN & ASSOCIATES


CIVIL ENGINEERS AND SURVEYORS

D. D. ANDRUS, PRESIDENT
405 ELYRIA BLOCK
ELYRIA, OHIO

STATE OF OHIO
REGISTERED { PROFESSIONAL ENG.
SURVEYOR

TELEPHONES 3211
42871

M. W. JACKSON
SECRETARY

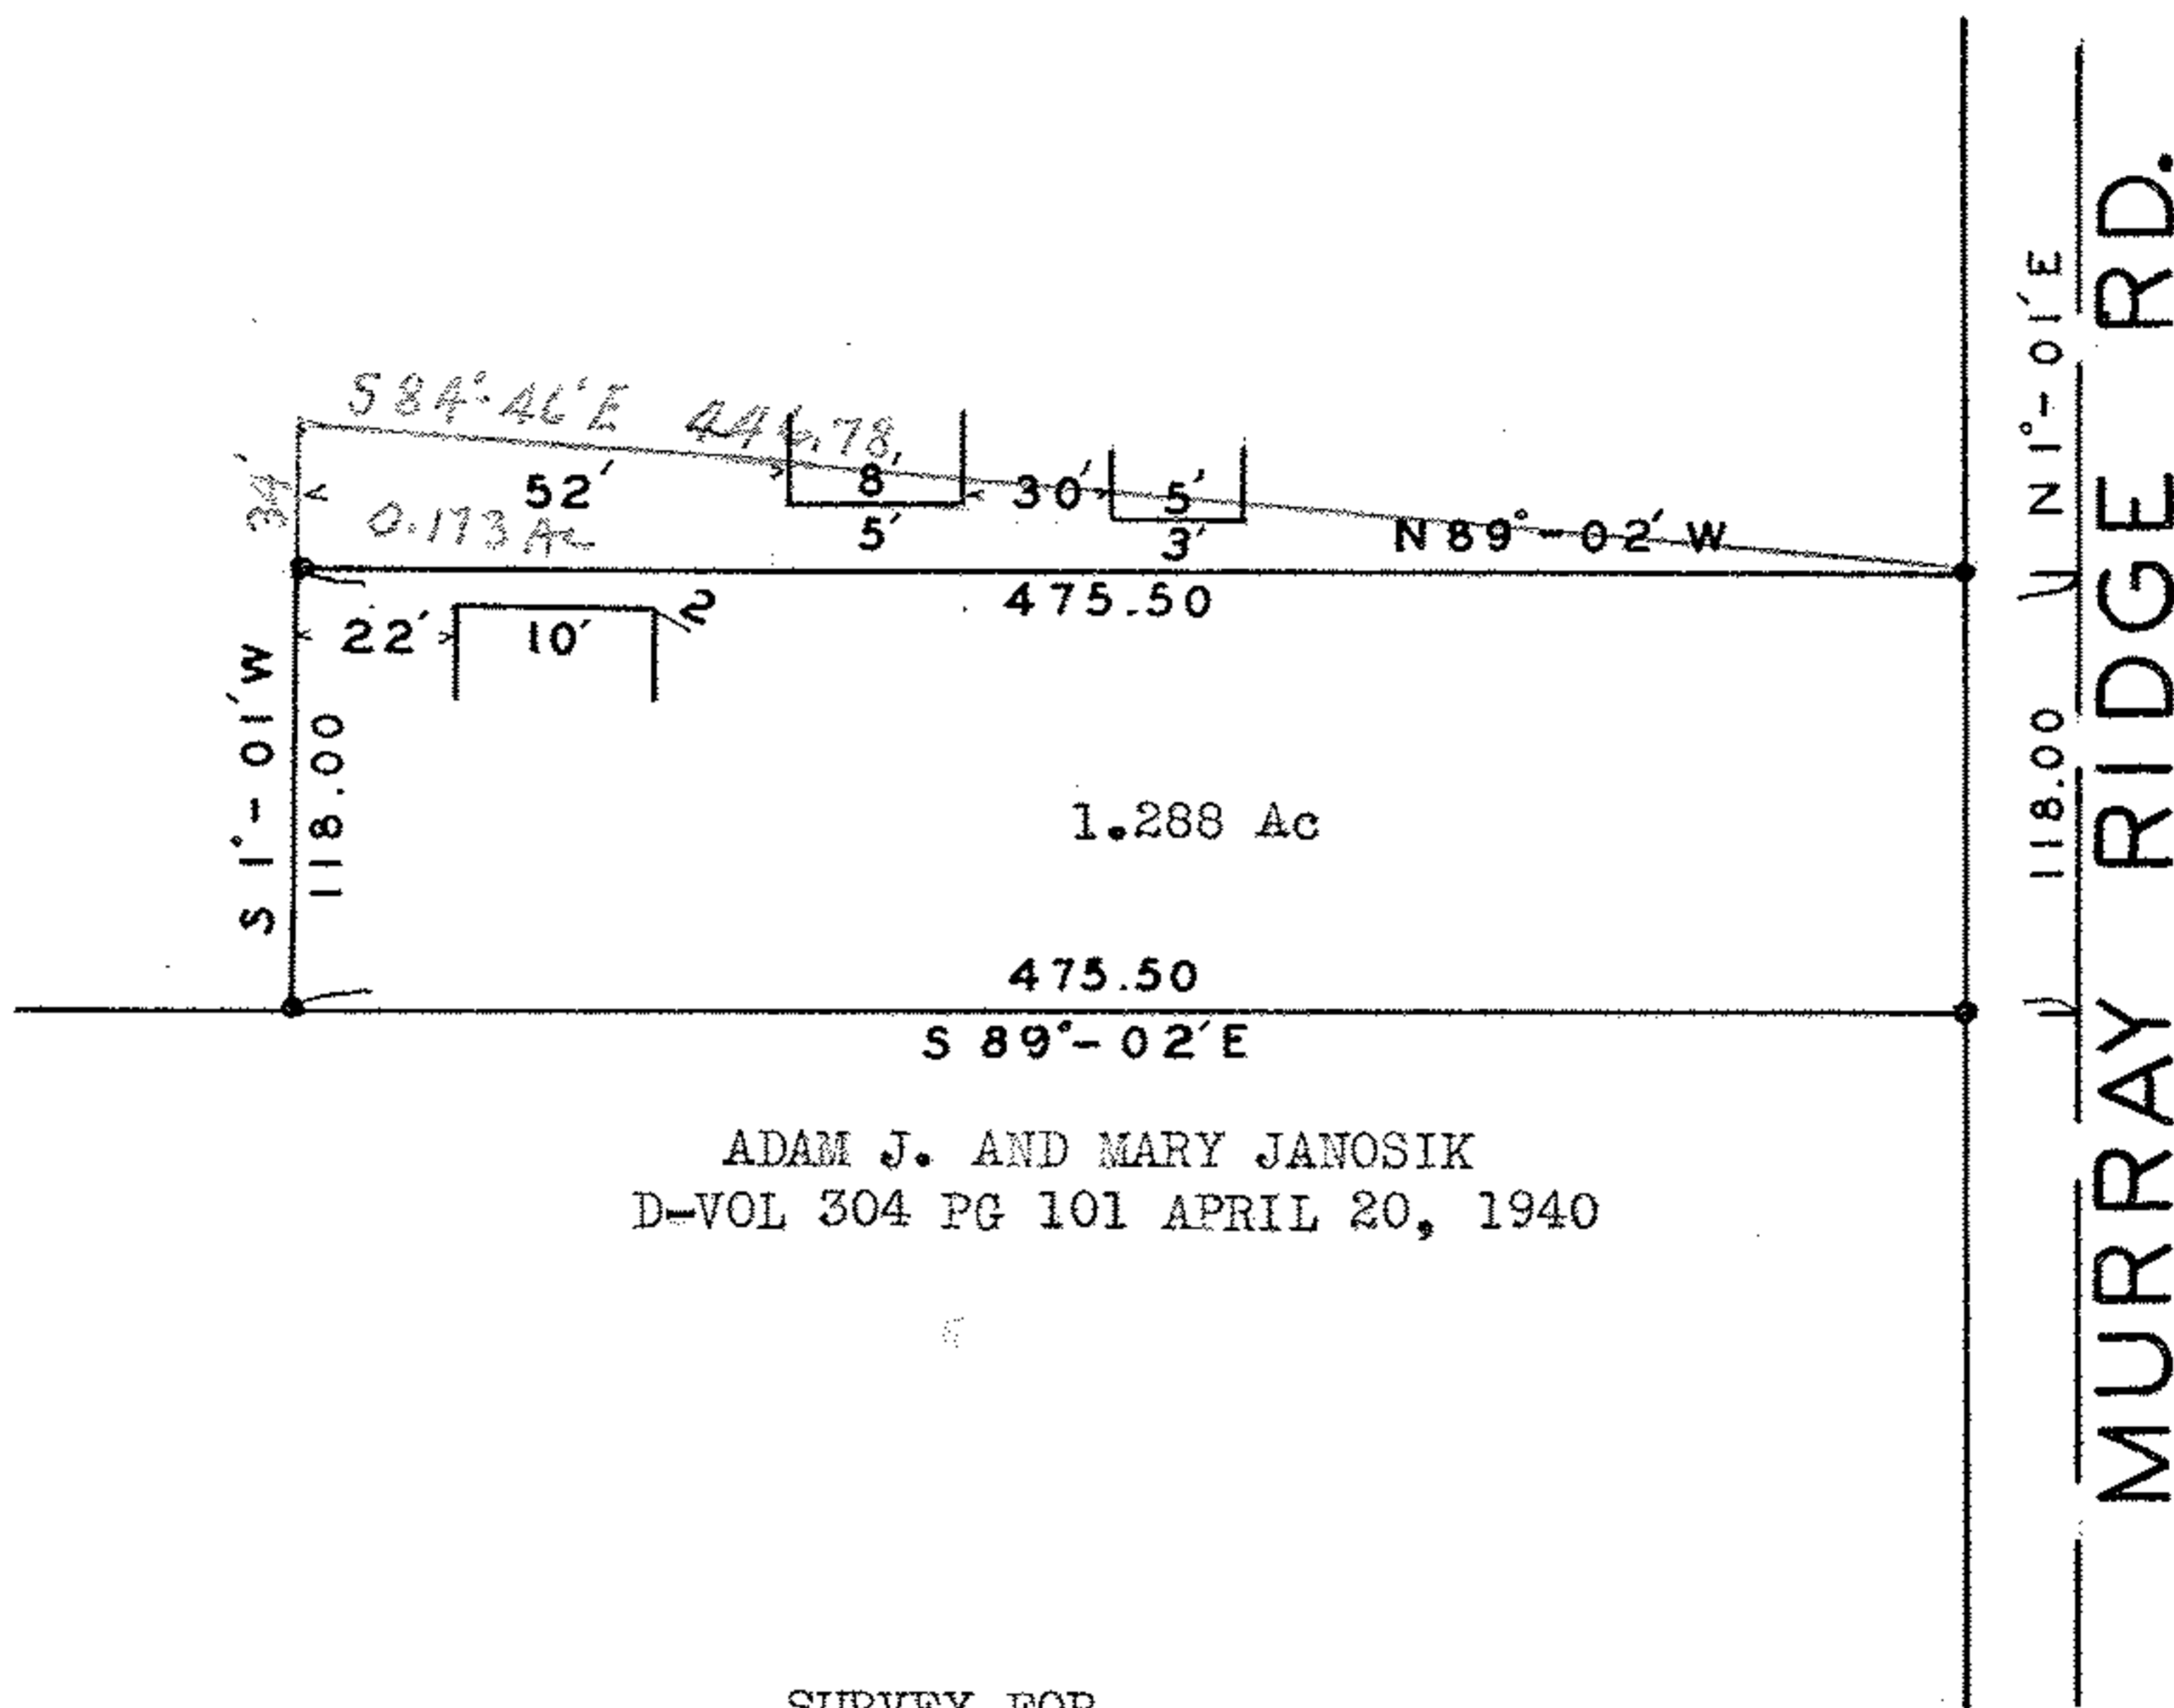

ADAM J. AND MARY JANOSIK
D-VOL 304 PG 101 APRIL 20, 1940

SURVEY FOR
HOWARD ROE
D-VOL 552 PG 554 JULY 29, 1952
O. L. 45 ELYRIA TOWNSHIP
LORAIN COUNTY OHIO
SCALE 1" = 100' NOV 13, 1956

Iron pins set at all points indicated thus •
Revised Dec. 31, 1959

6 00165 C

*06-24-043-101-006, -013
MAP PG 6-57*

9-1-192