


De-26-064-000-019,-020,-039  
-023  
06-119

6000844

S. line Broad St.

Survey for Oscar Duan  
Lot 141, Block 64, H. Elys. O. P.  
Elyria, Lorain Co. Ohio  
Scale 1"=20' Oct 14, 1919  
Warden & Loudon, C.E.s

E West Ave 66'

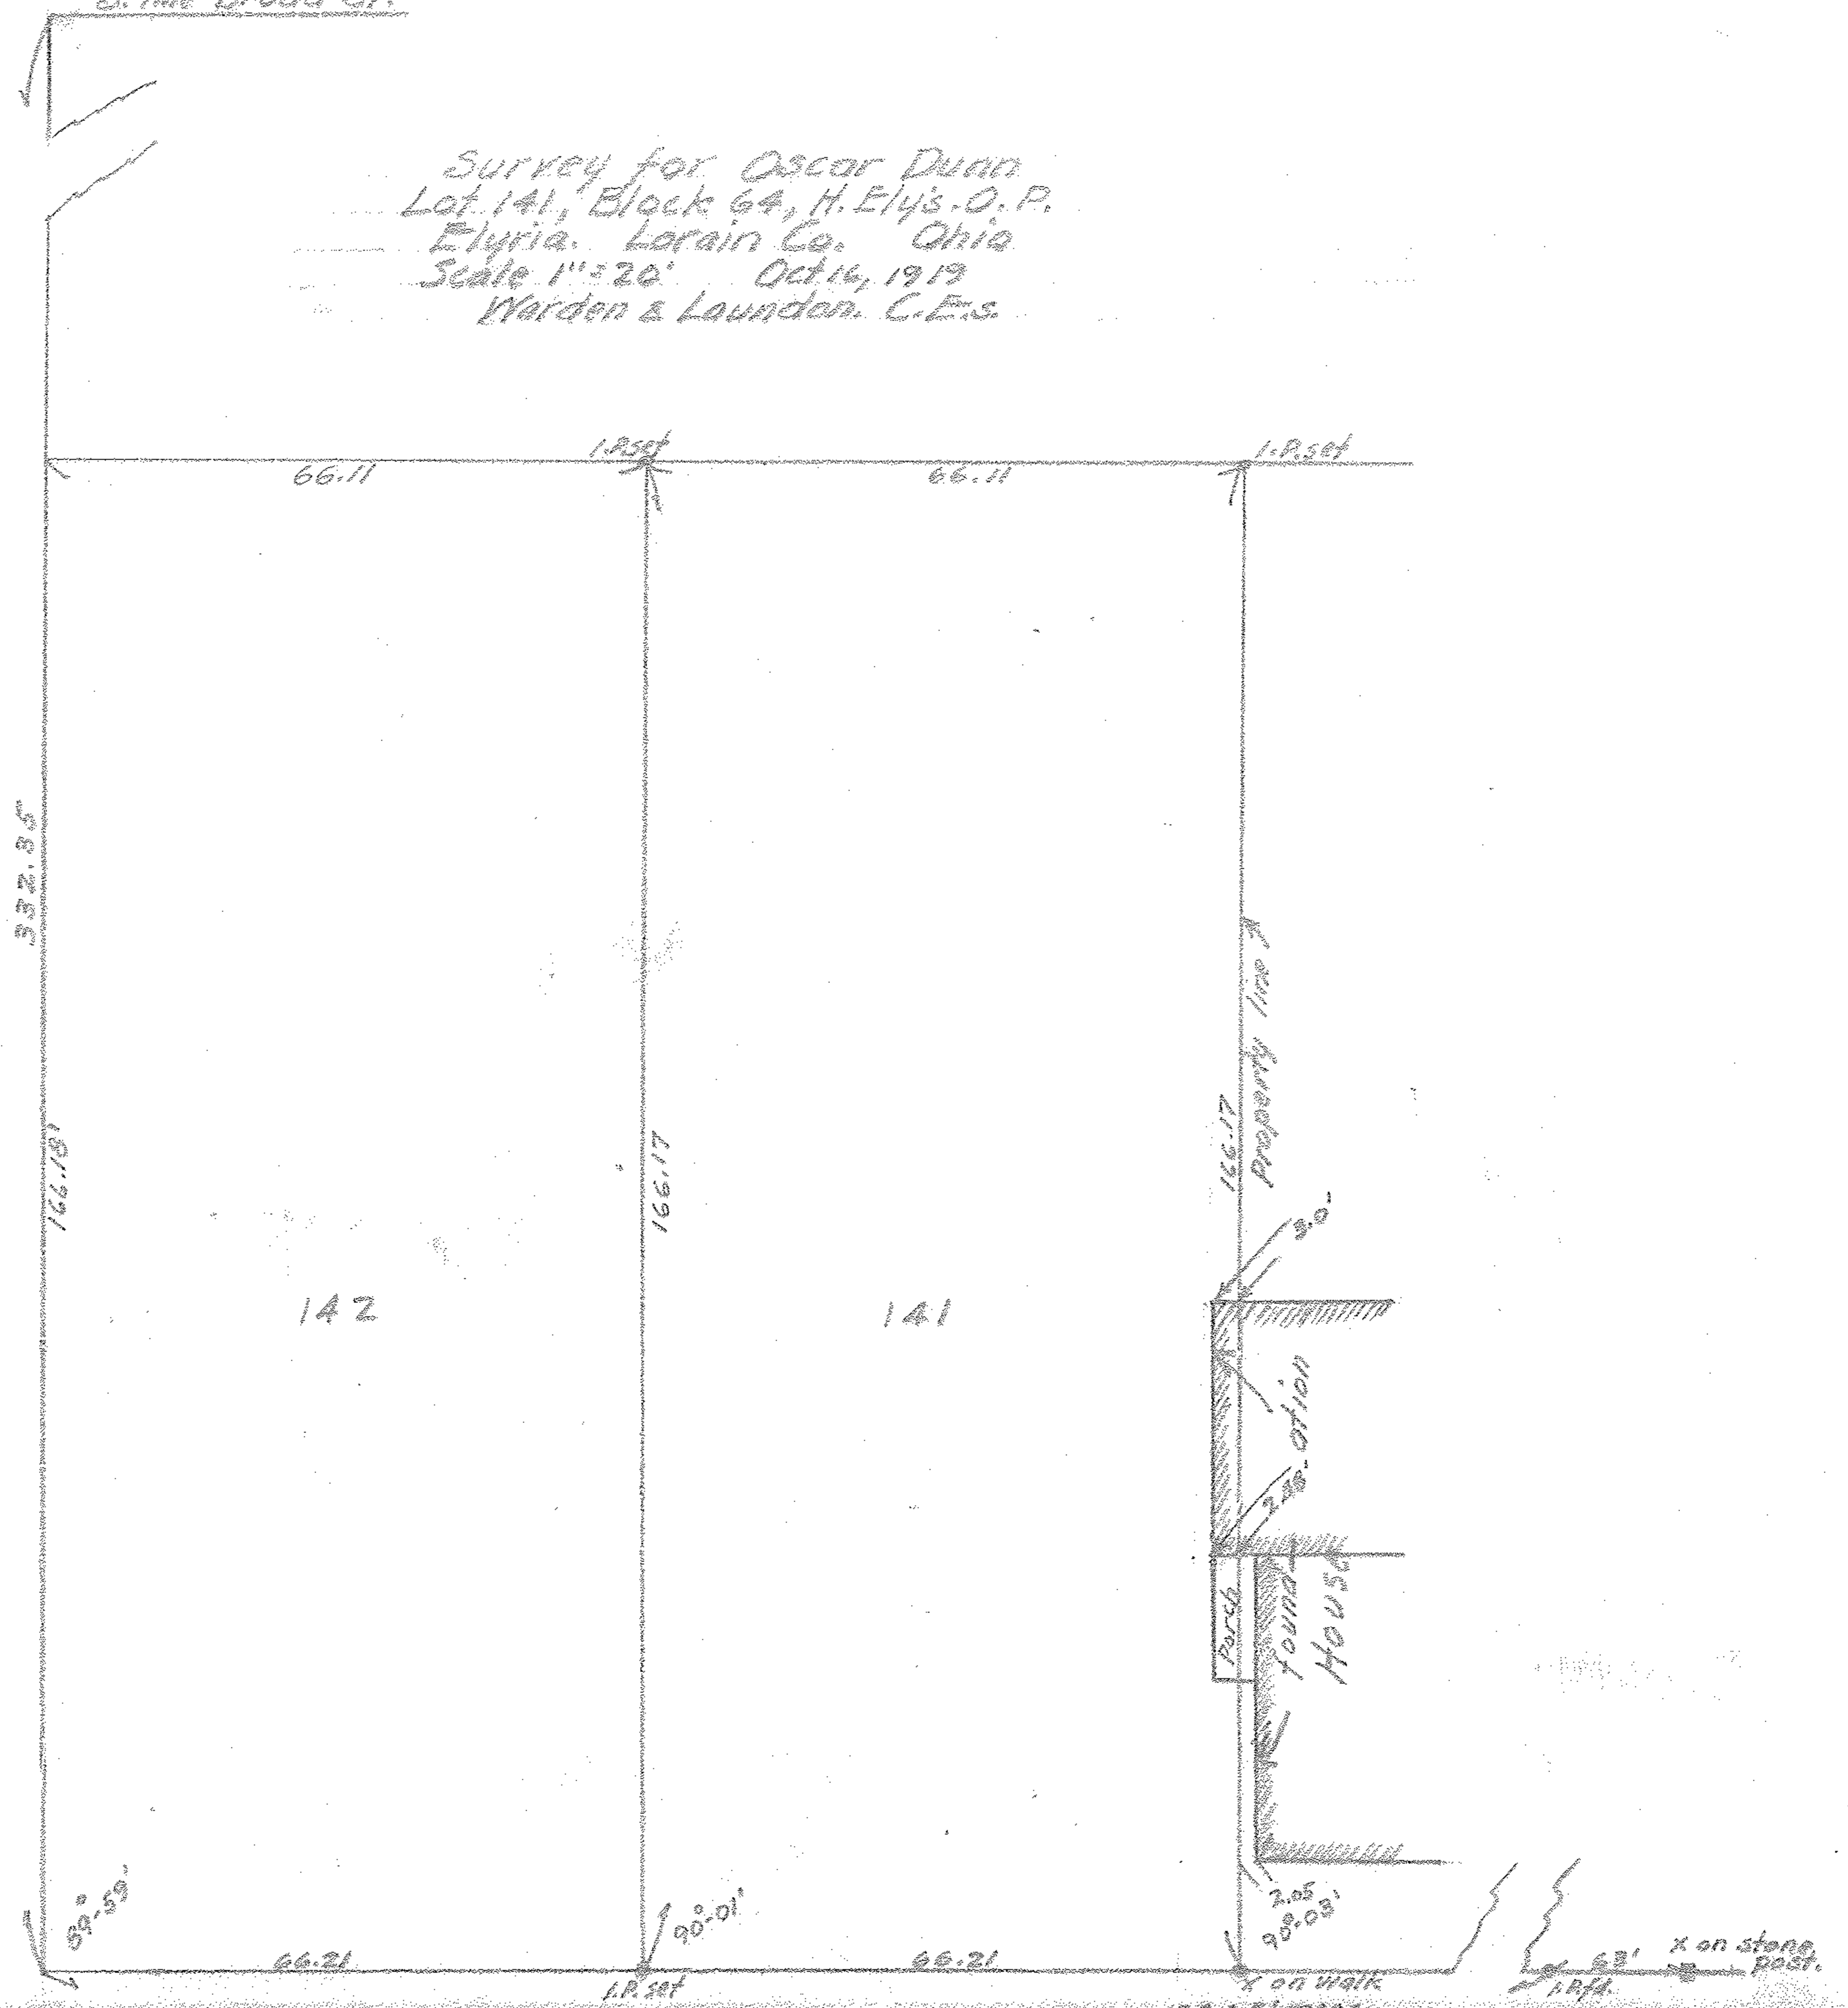

E Second St 66'