


07-00-003-102-064, -065  
07-00-003-A

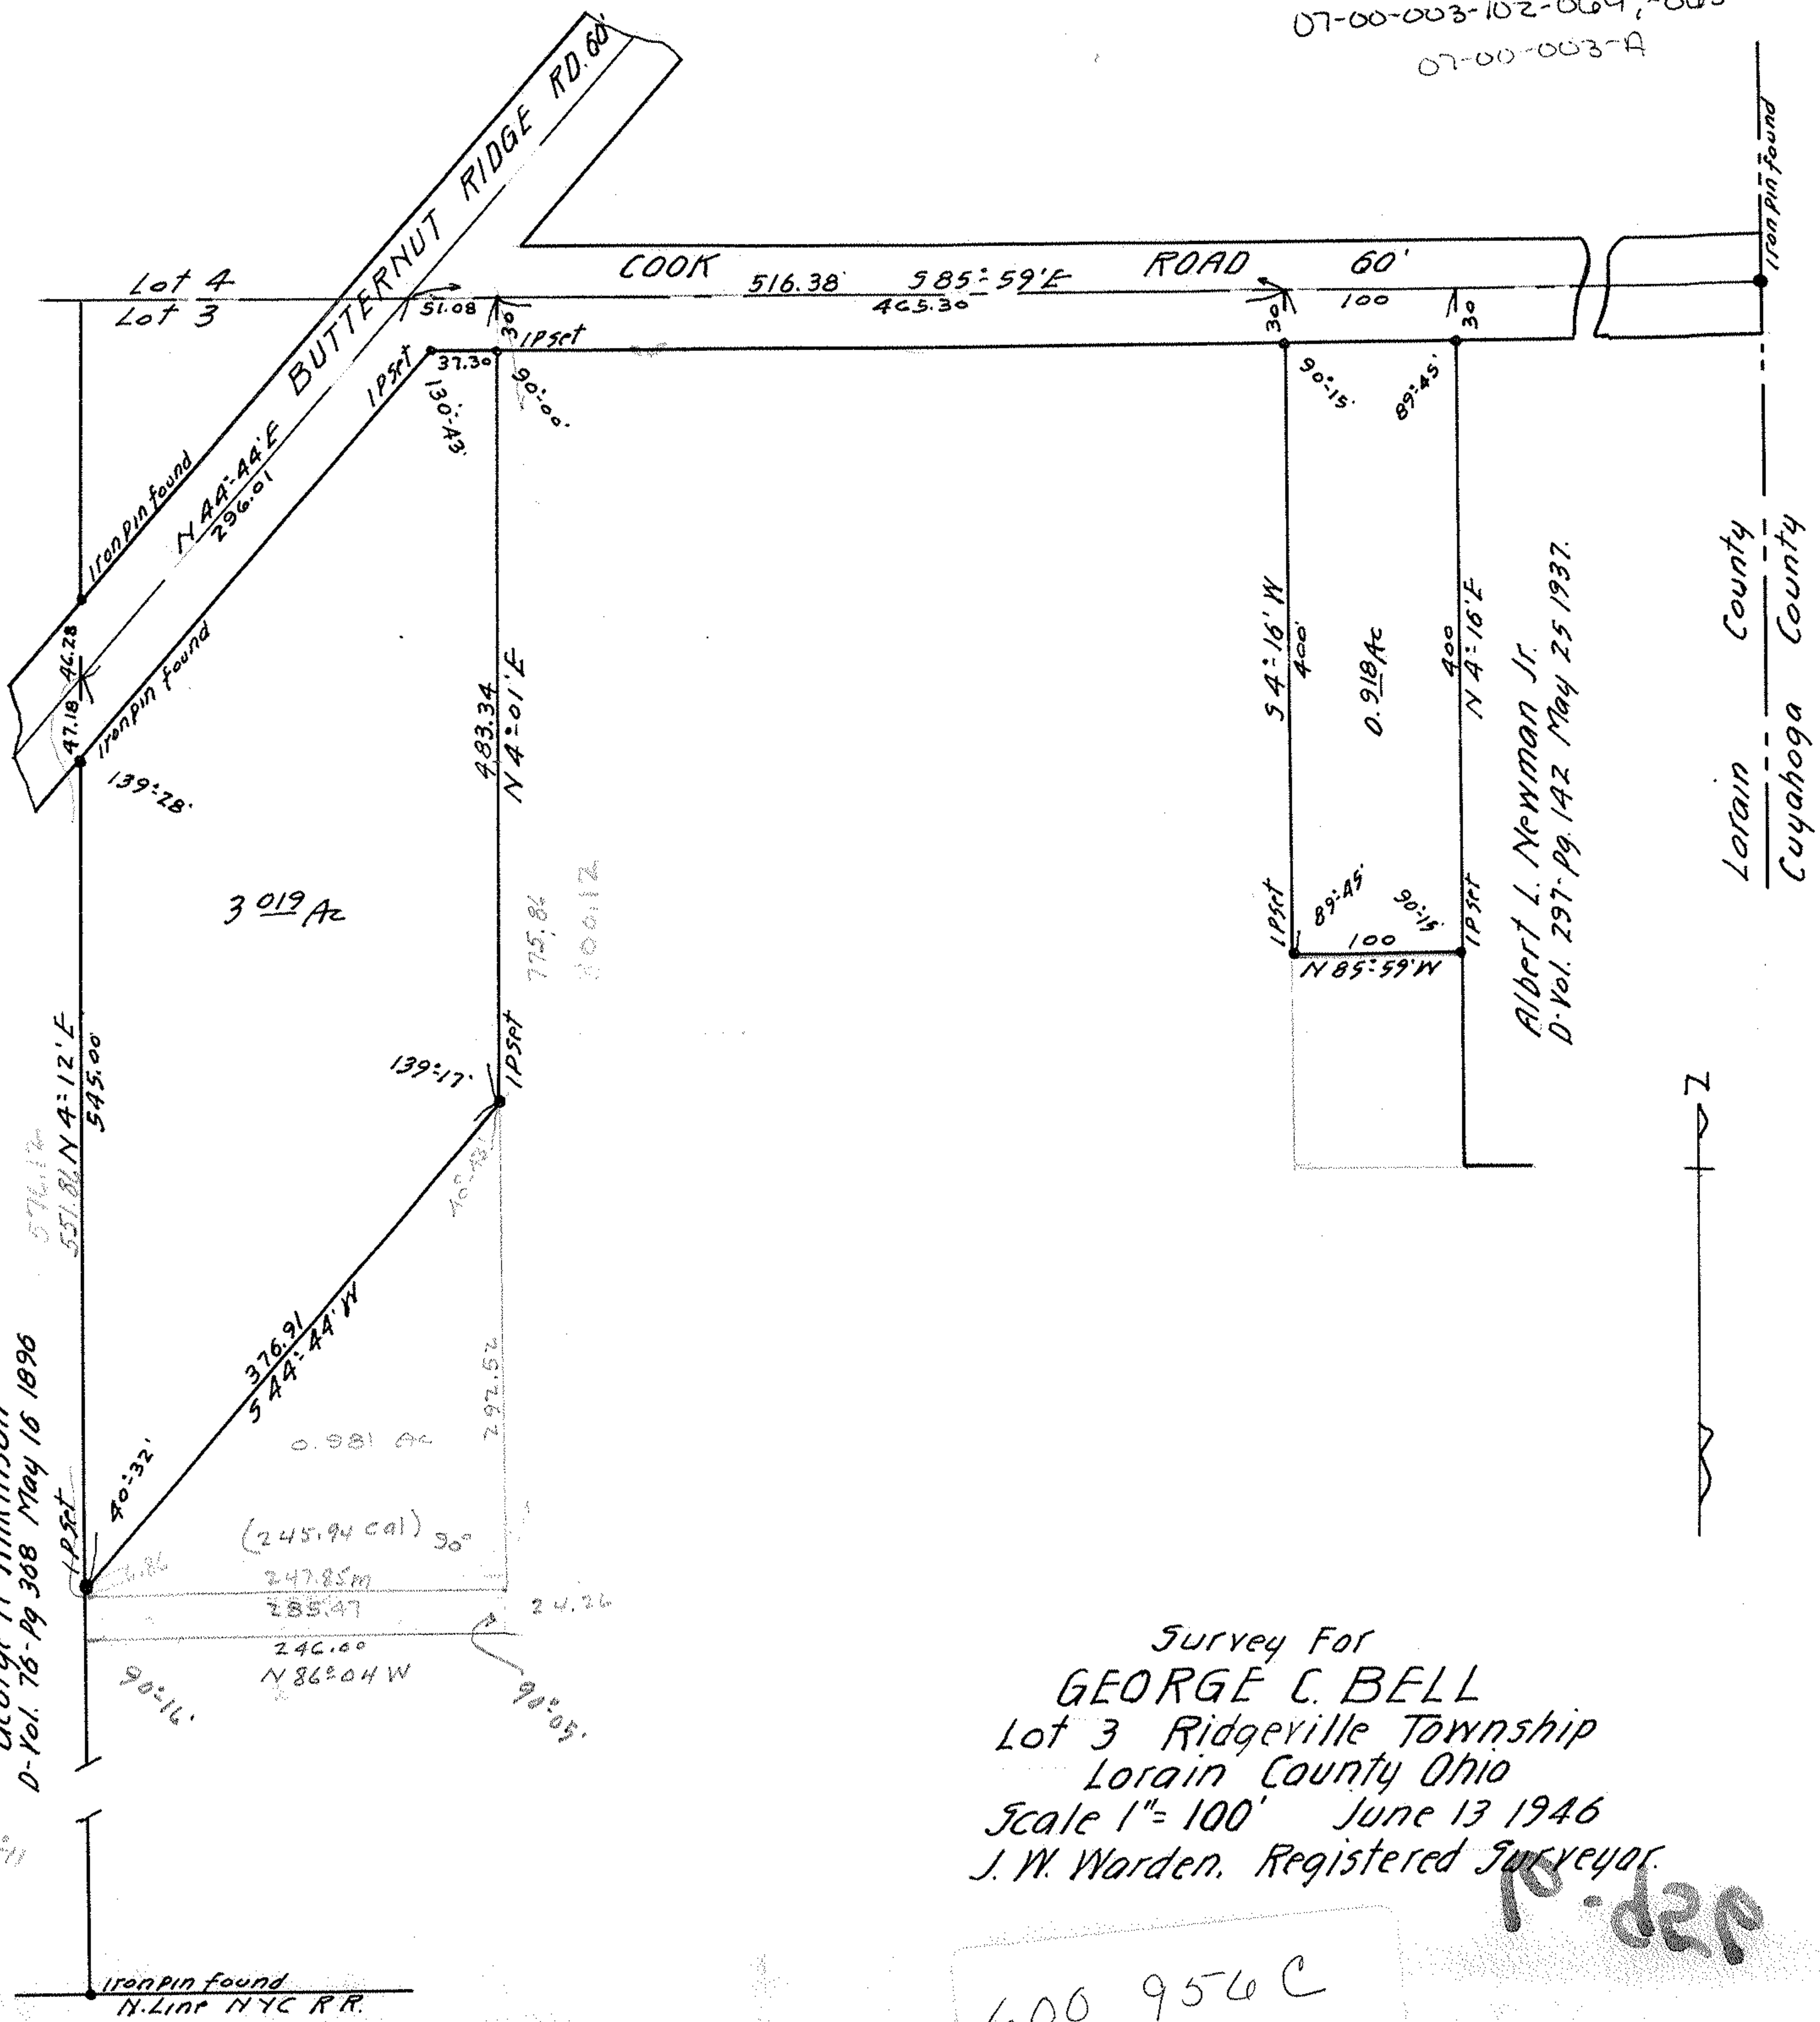

George H Wilkinson  
D- Vol. 76-Pg 368 May 16 1896

Albert L. Newman Jr.  
D- Vol. 297-Pg 142 May 25 1937.

Survey For  
GEORGE C. BELL  
Lot 3 Ridgerville Township  
Lorain County Ohio  
Scale 1" = 100' June 13 1946  
J. W. Warden, Registered Surveyor.

600 956 C

FB 53-Pg 69

D.A.

1-953