

J. W. WARDEN & ASSOCIATES


CIVIL ENGINEERS AND SURVEYORS

D. D. ANDRUS, PRESIDENT
405 ELYRIA BLOCK
ELYRIA, OHIO

STATE OF OHIO
REGISTERED PROFESSIONAL ENG.
SURVEYOR

TELEPHONES 3211
42871

M. W. JACKSON
SECRETARY

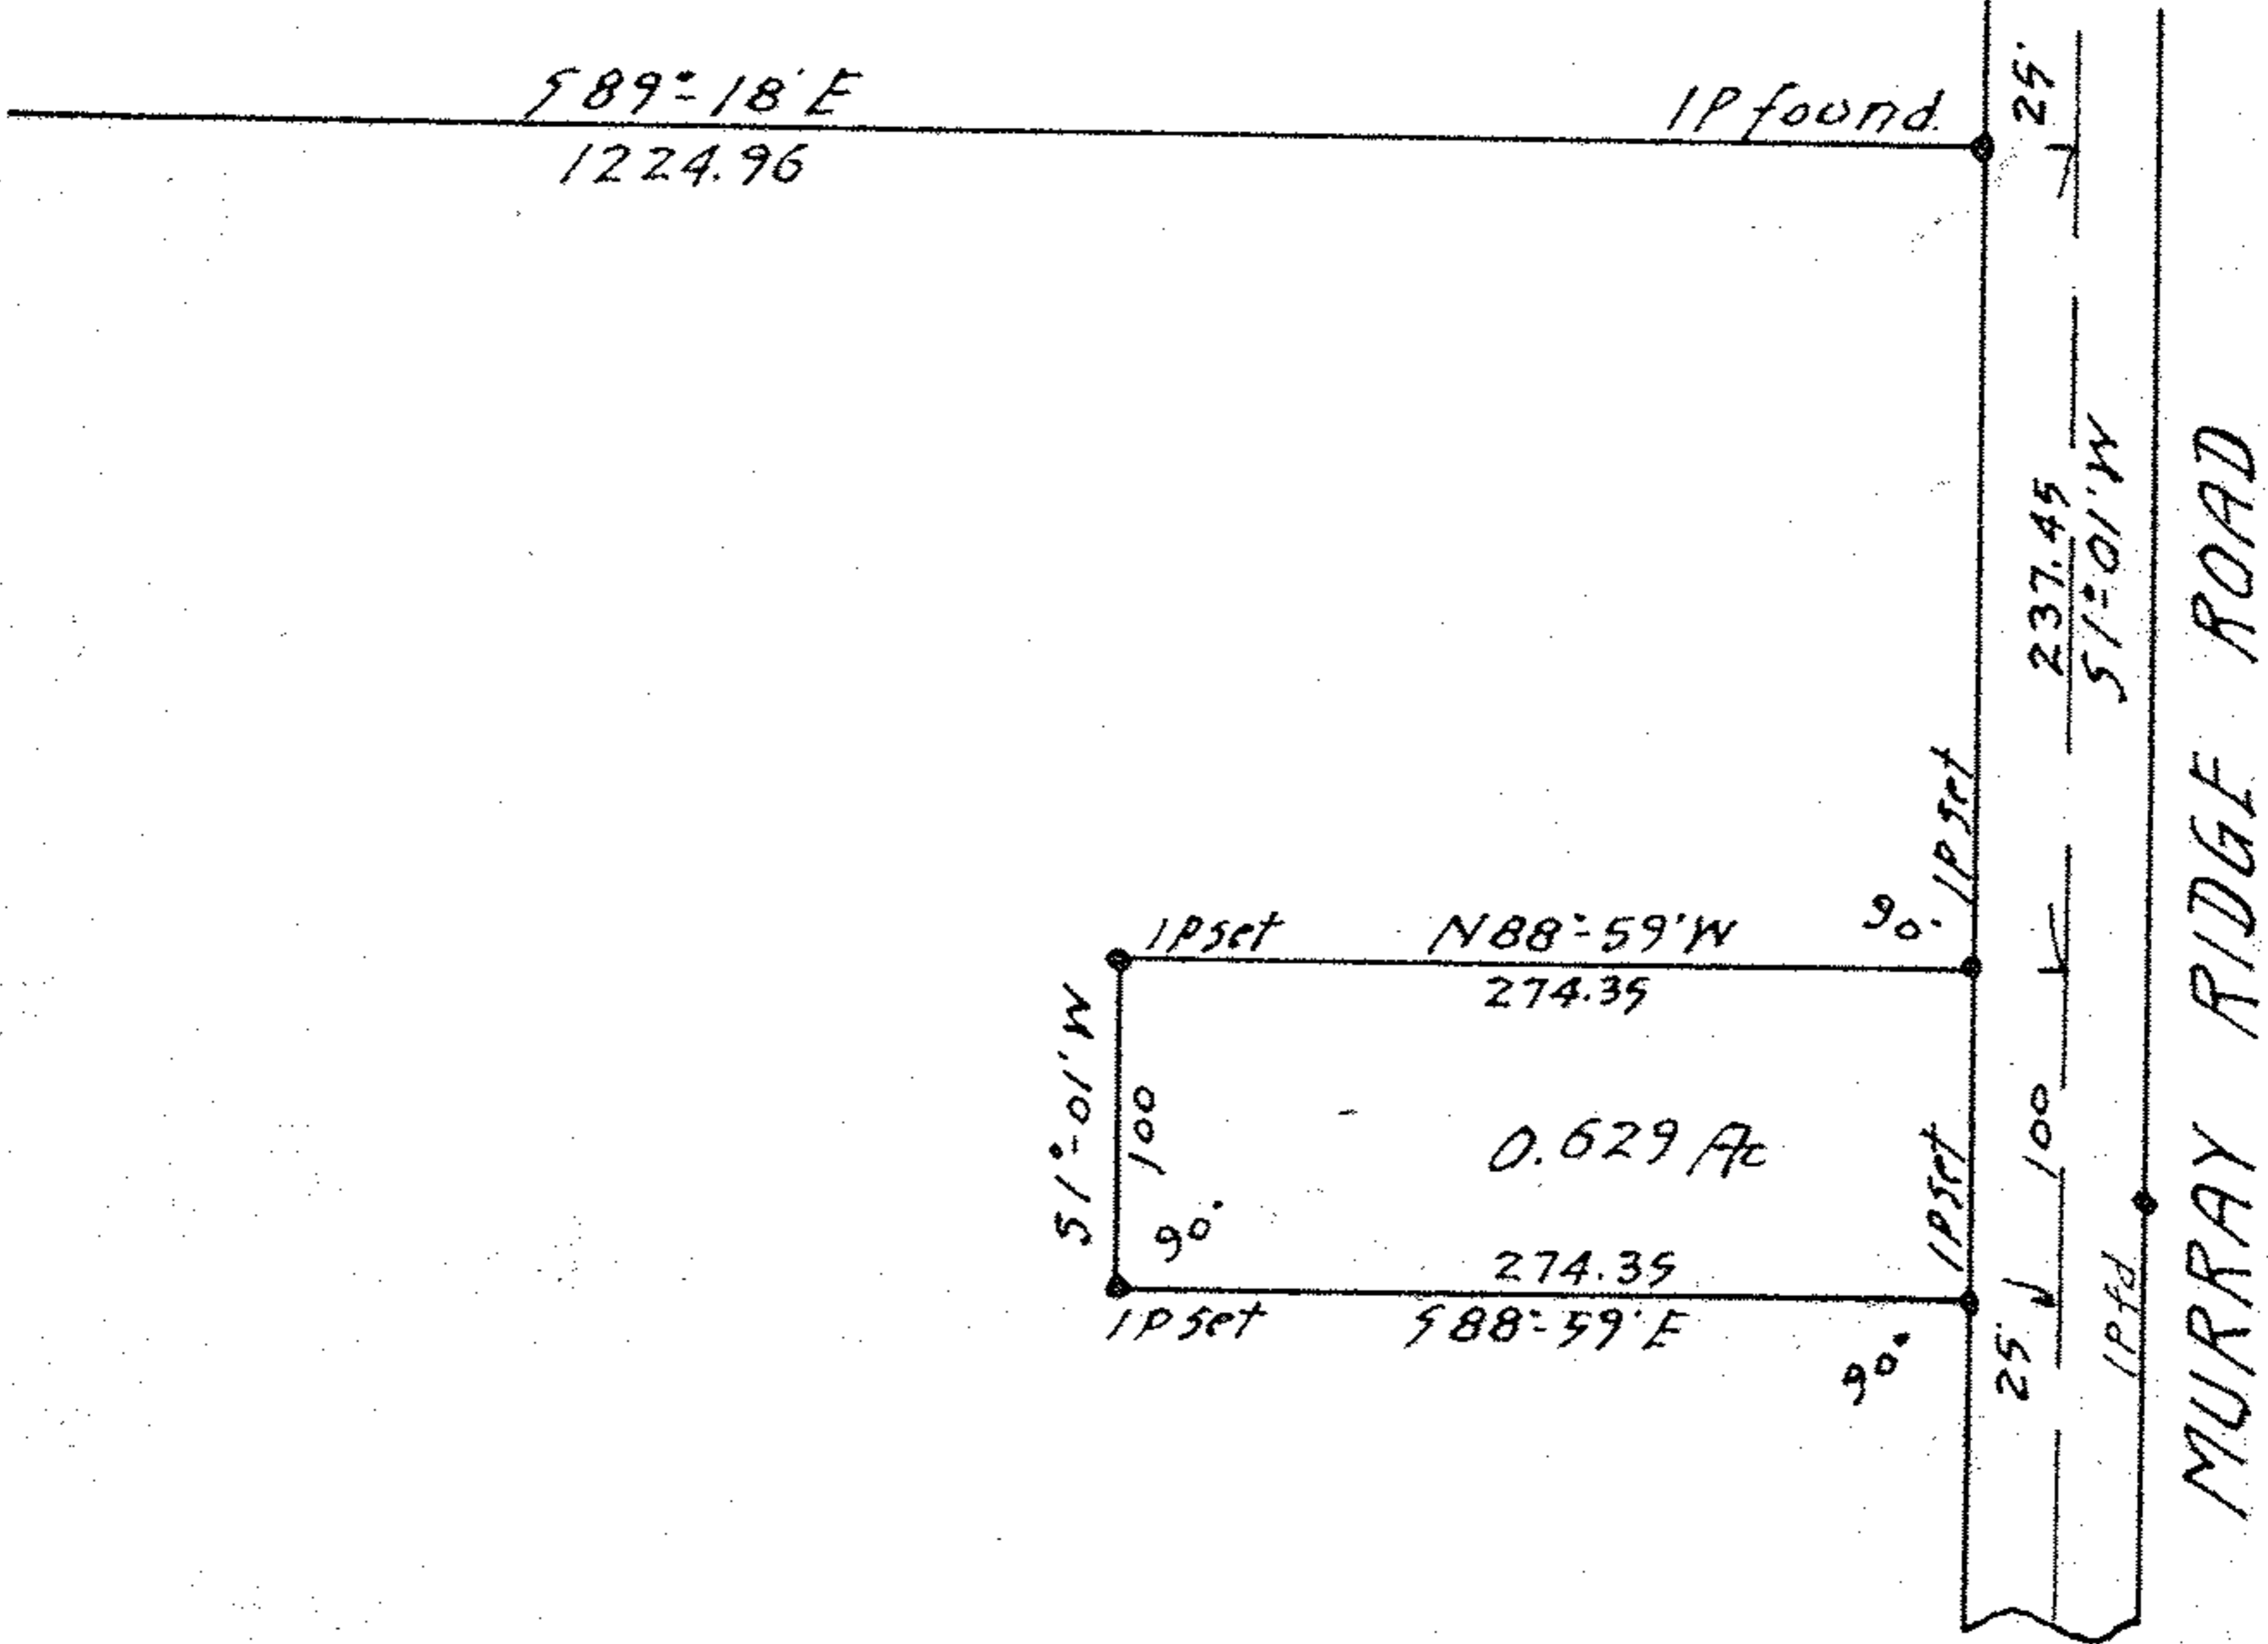

SURVEY FOR
HOWARD A. AND MARIE M. ROE
D-VOL 307 PG. 119 AUG. 9, 1940
LOT 21 WEST OF BLACK RIVER
ELYRIA TOWNSHIP-LORAIN COUNTY, OHIO
SCALE 1" = 100' AUG. 26, 1955

06-24-021-000-051, -050, -049

MAP PG: 6-75