

# J. W. WARDEN & ASSOCIATES

CIVIL ENGINEERS AND SURVEYORS

STATE OF OHIO

REGISTERED { PROFESSIONAL ENG.  
SURVEYOR


D. D. ANDRUS, PRESIDENT  
405 ELYRIA BLOCK

ELYRIA, OHIO



TELEPHONES 3211  
42871

M. W. JACKSON  
SECRETARY

*250 1/2 Carey Lane*

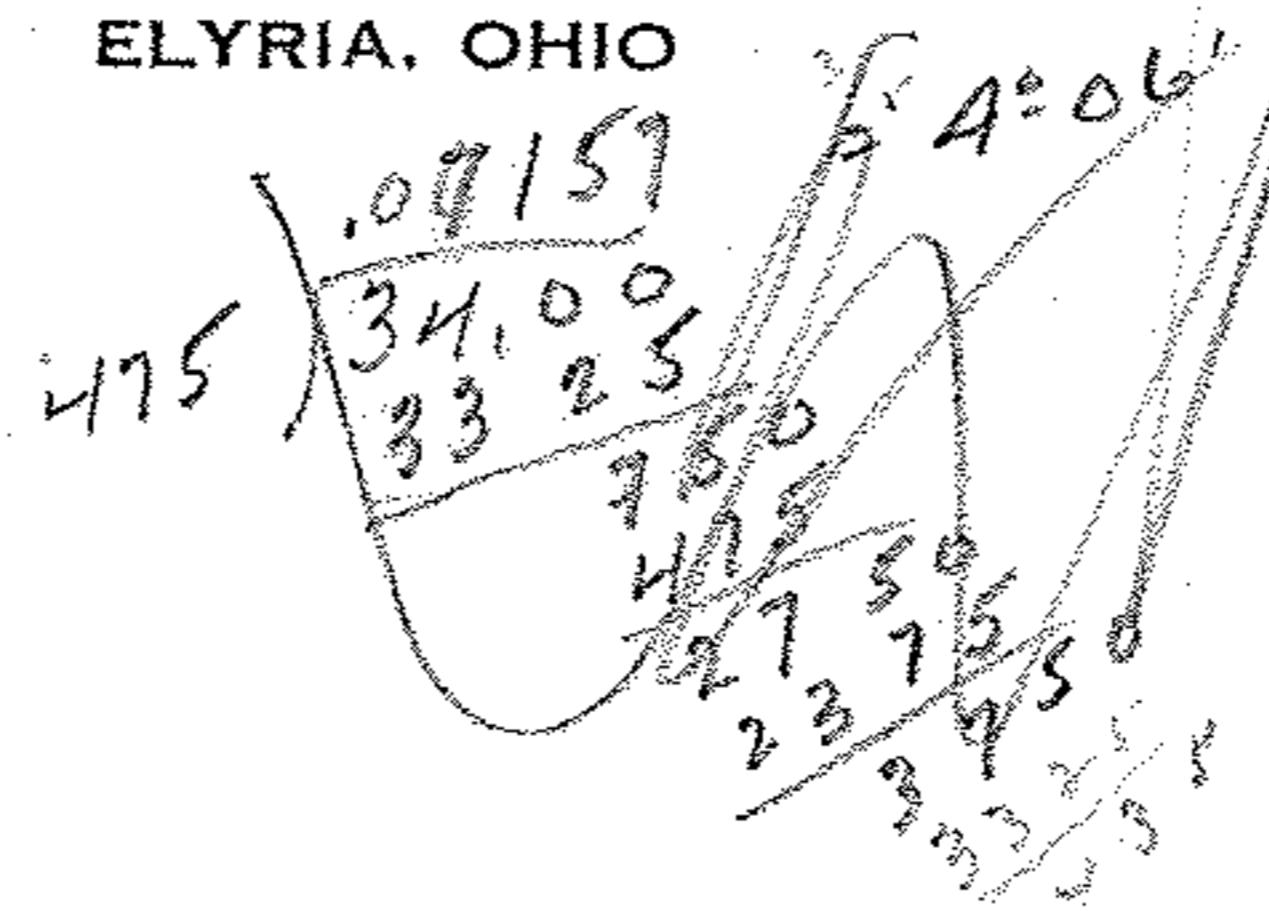

*0.1734*

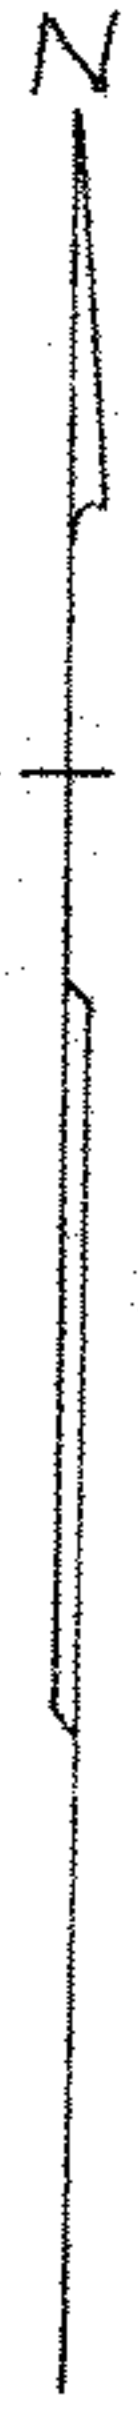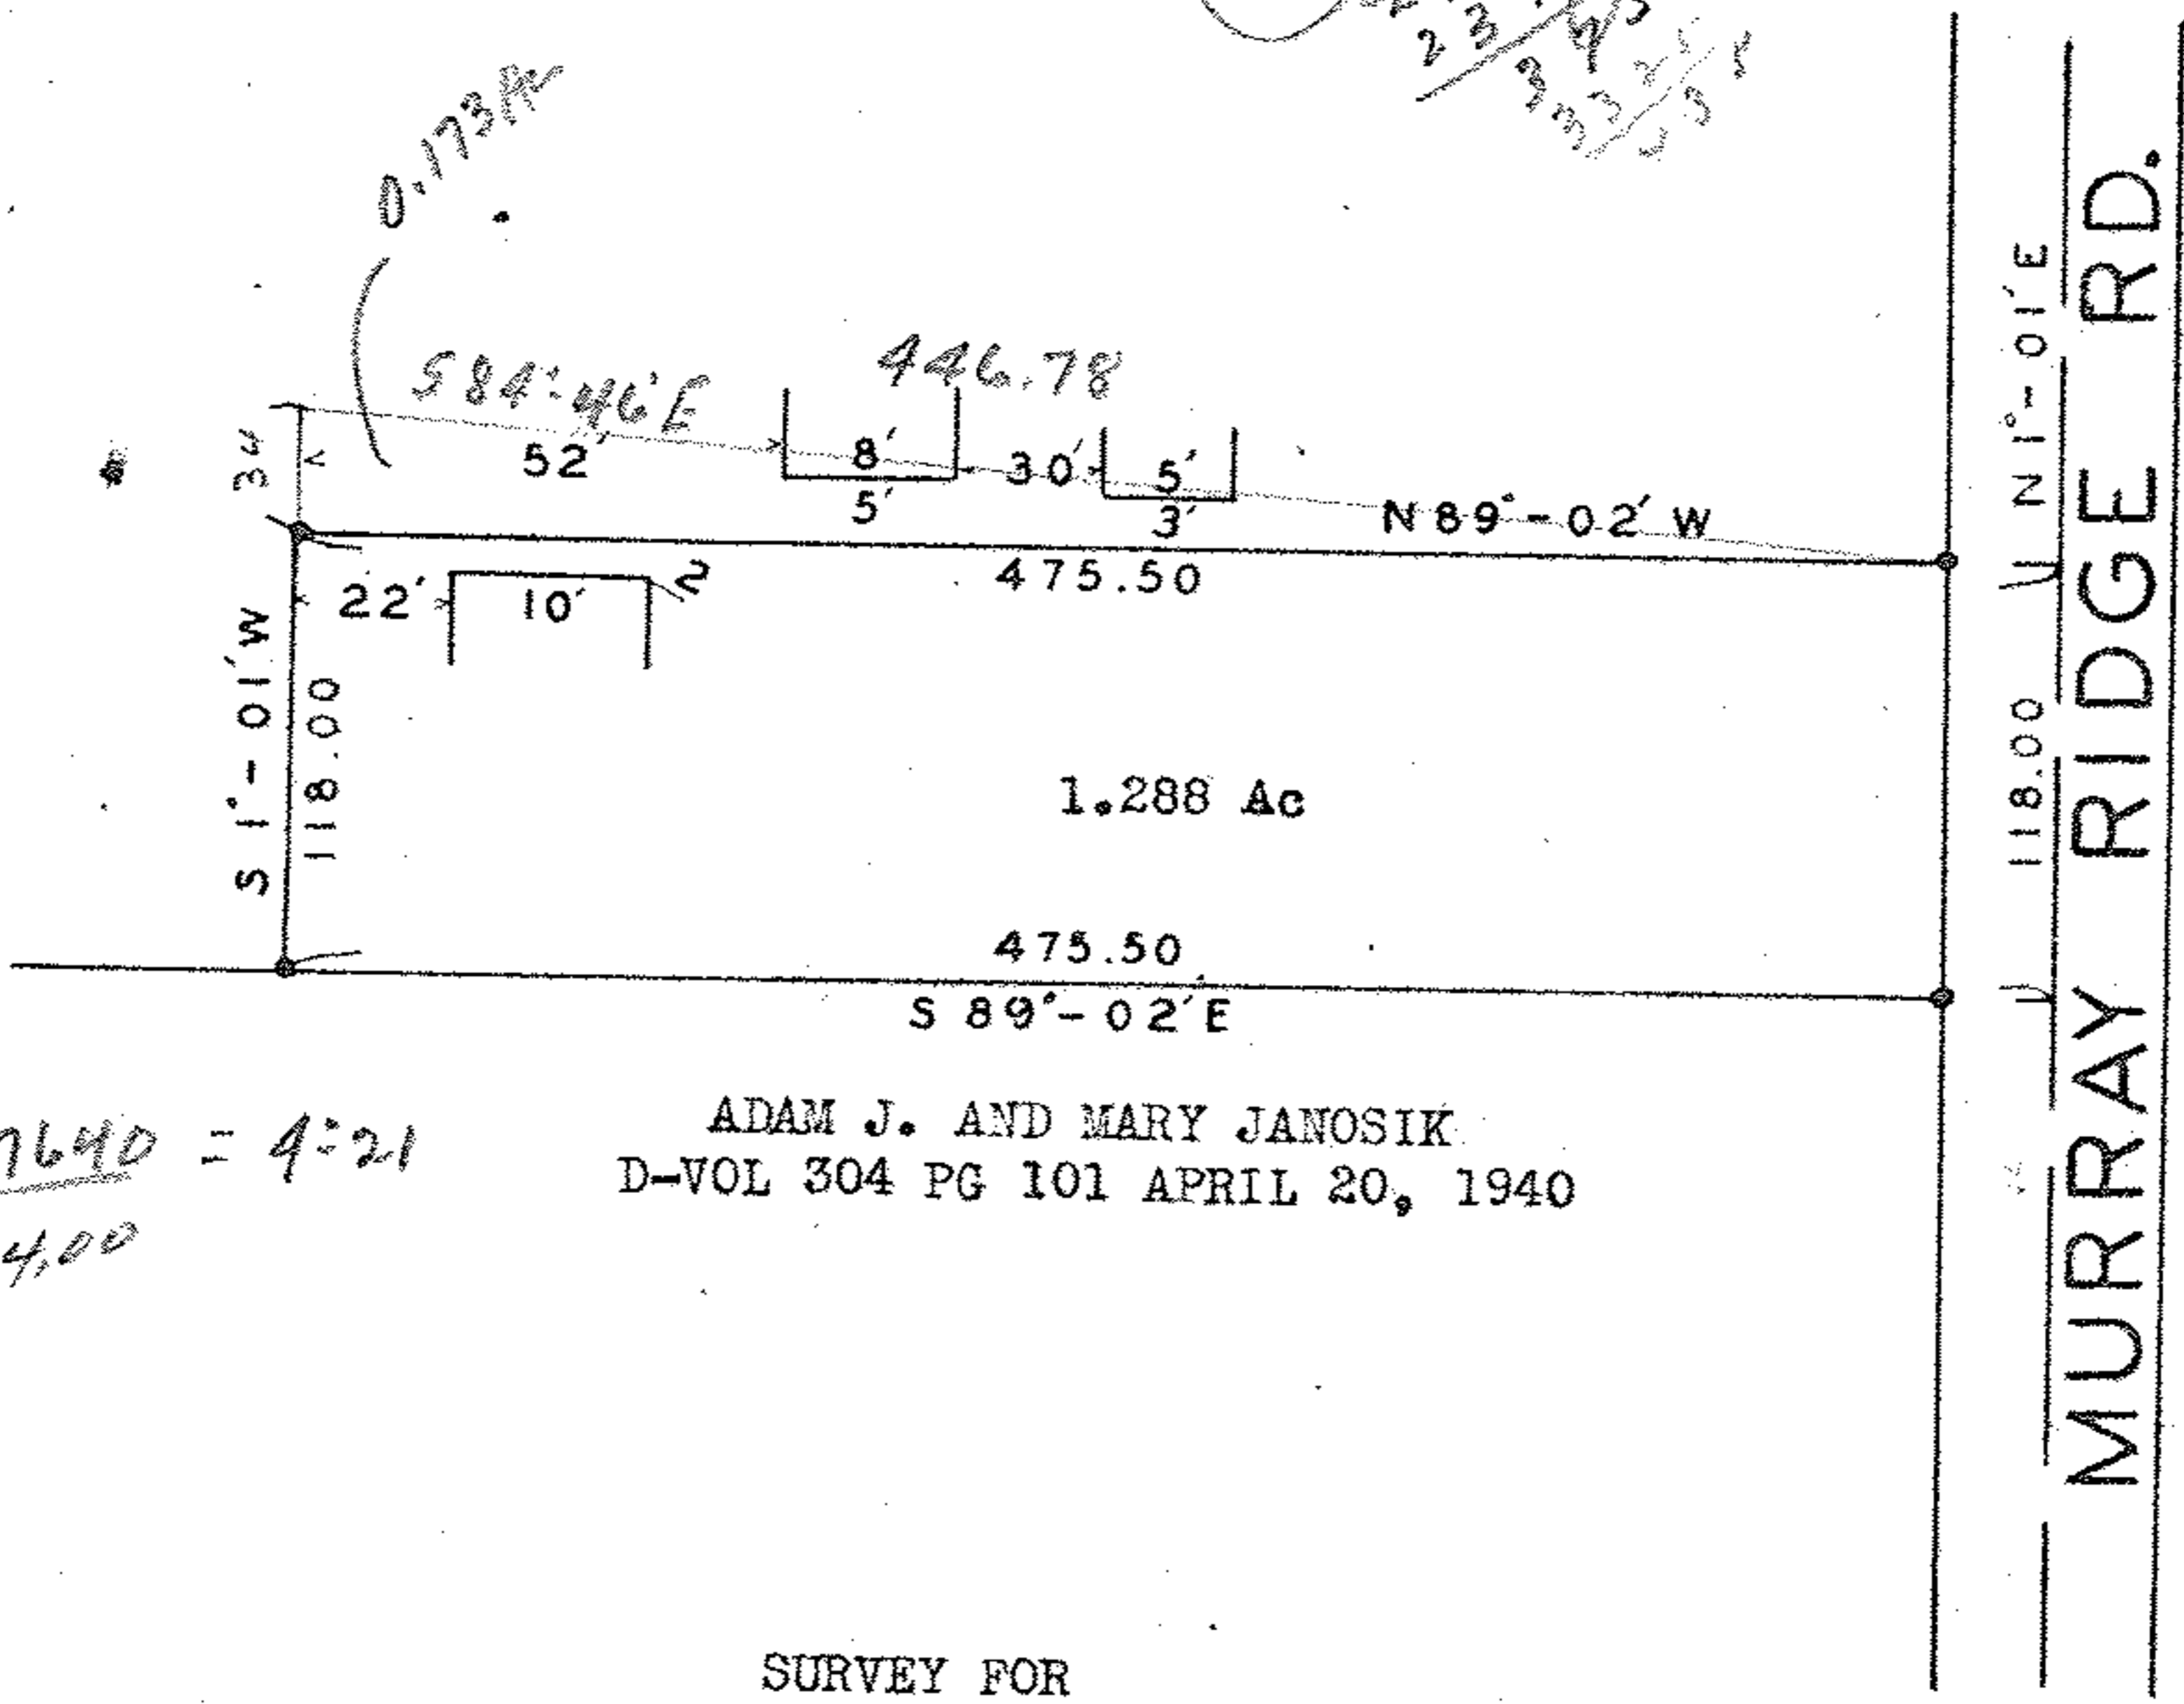

*07640 = 4:21*  
*445.34.00*

ADAM J. AND MARY JANOSIK  
D-VOL 304 PG 101 APRIL 20, 1940

SURVEY FOR  
HOWARD ROE  
D-VOL 552 PG 554 JULY 29, 1952  
43 O. L. 45 ELYRIA TOWNSHIP  
LORAIN COUNTY OHIO  
SCALE 1" = 100' NOV 13, 1956

*89-02*  
*421*  
*8441*

Iron pins set at all points indicated thus •

*SP 7-0272*

*N. Olmstead*

*4:21 1.00289 x 445.90 =*

*MAP PG. 6-57*

*06-24-043-101-0000*  
*-013*