

George H. Wilkinson
D-Vol. 76-Pg. 368 May 16, 1896.

73069 AC
~~73264 AC~~

Mildred E. Strauss
1946

George C. Bell
1.50 Ac


Albert L. Newman Jr.
D-Vol. 297-Pg. 142 May 25, 1937
2.260 Ac

Frank Josef Schmitt & Hildegrade Schmitt
D-Vol. 320-Pg. 423 June 16, 1942

Survey for
GEORGE C. BELL
D-Vol. 212-Pg. 430 July 25, 1925
Lot 3, Ridgerville Township
Lorain County Ohio.
Scale 1"=100' June 13, 1946
J. W. Warden, Registered Surveyor. F.B. 53-Pg. 69
Revised July 5, 1946

600 956 B

LORAIN COUNTY
CUYAHOGA COUNTY

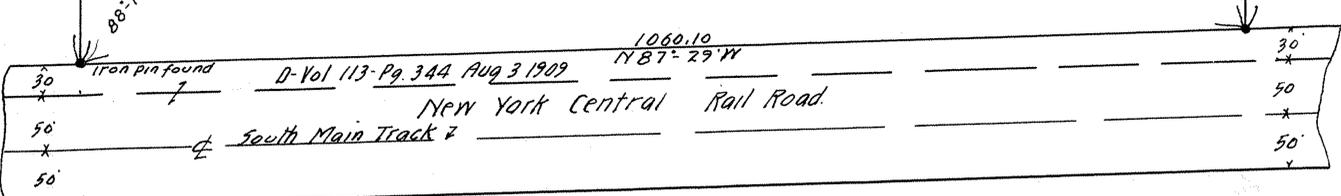

Map Pls. 7-00-003-B, C, D
07-00-003-102-084, -064, -065, -048, -049, -045
-046, -028, -019, -040, -027, -010