

J. W. WARDEN & ASSOCIATES


CIVIL ENGINEERS AND SURVEYORS

D. D. ANDRUS, PRESIDENT
405 ELYRIA BLOCK
ELYRIA, OHIO

TELEPHONES 3211
42871

M. W. JACKSON
SECRETARY

STATE OF OHIO
REGISTERED { PROFESSIONAL ENG.
SURVEYOR

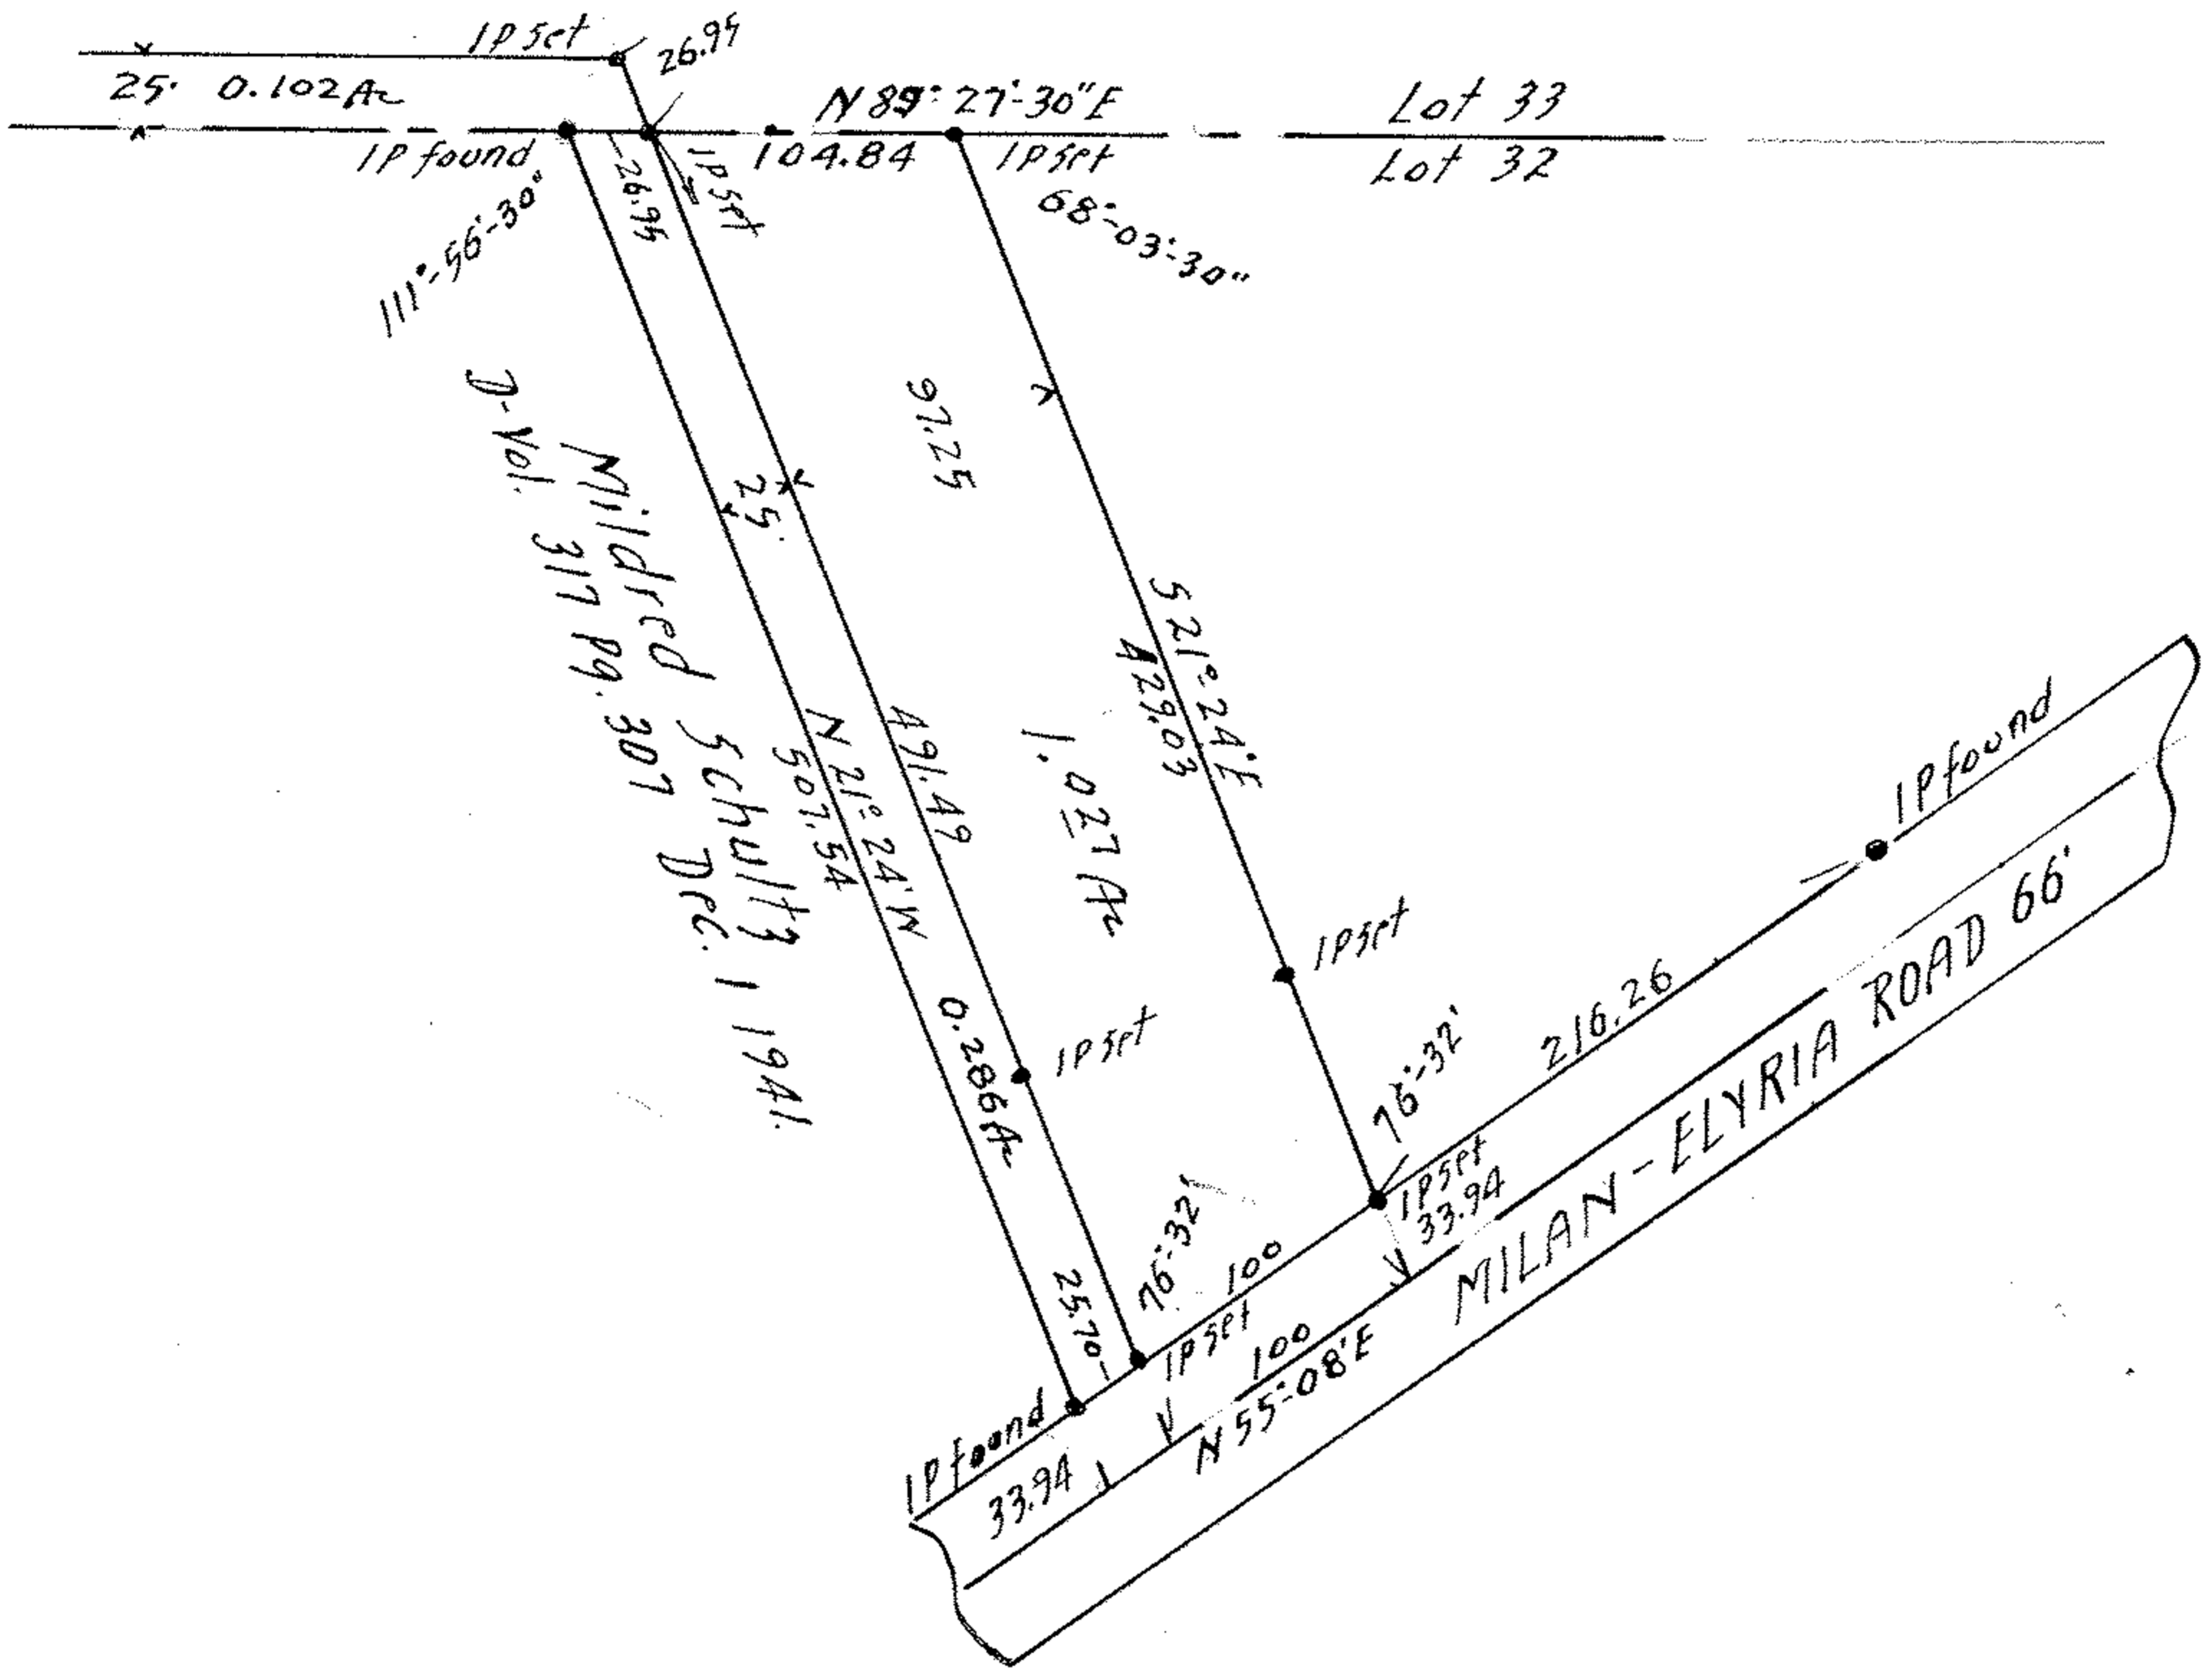

SURVEY FOR
ARCHIE W. SAWYER
D-VOL 455 PG. 395 NOV. 1, 1948
LOT 32 AMHERST TOWNSHIP
LORAIN COUNTY, OHIO
SCALE 1" = 100' SEPT. 28, 1955

MAP PG. 5-00-032-A
05-00-032-000-072, 074