


CARWOOD AVE.

ROOSEVELT AVE.

16-FT. ALLEY

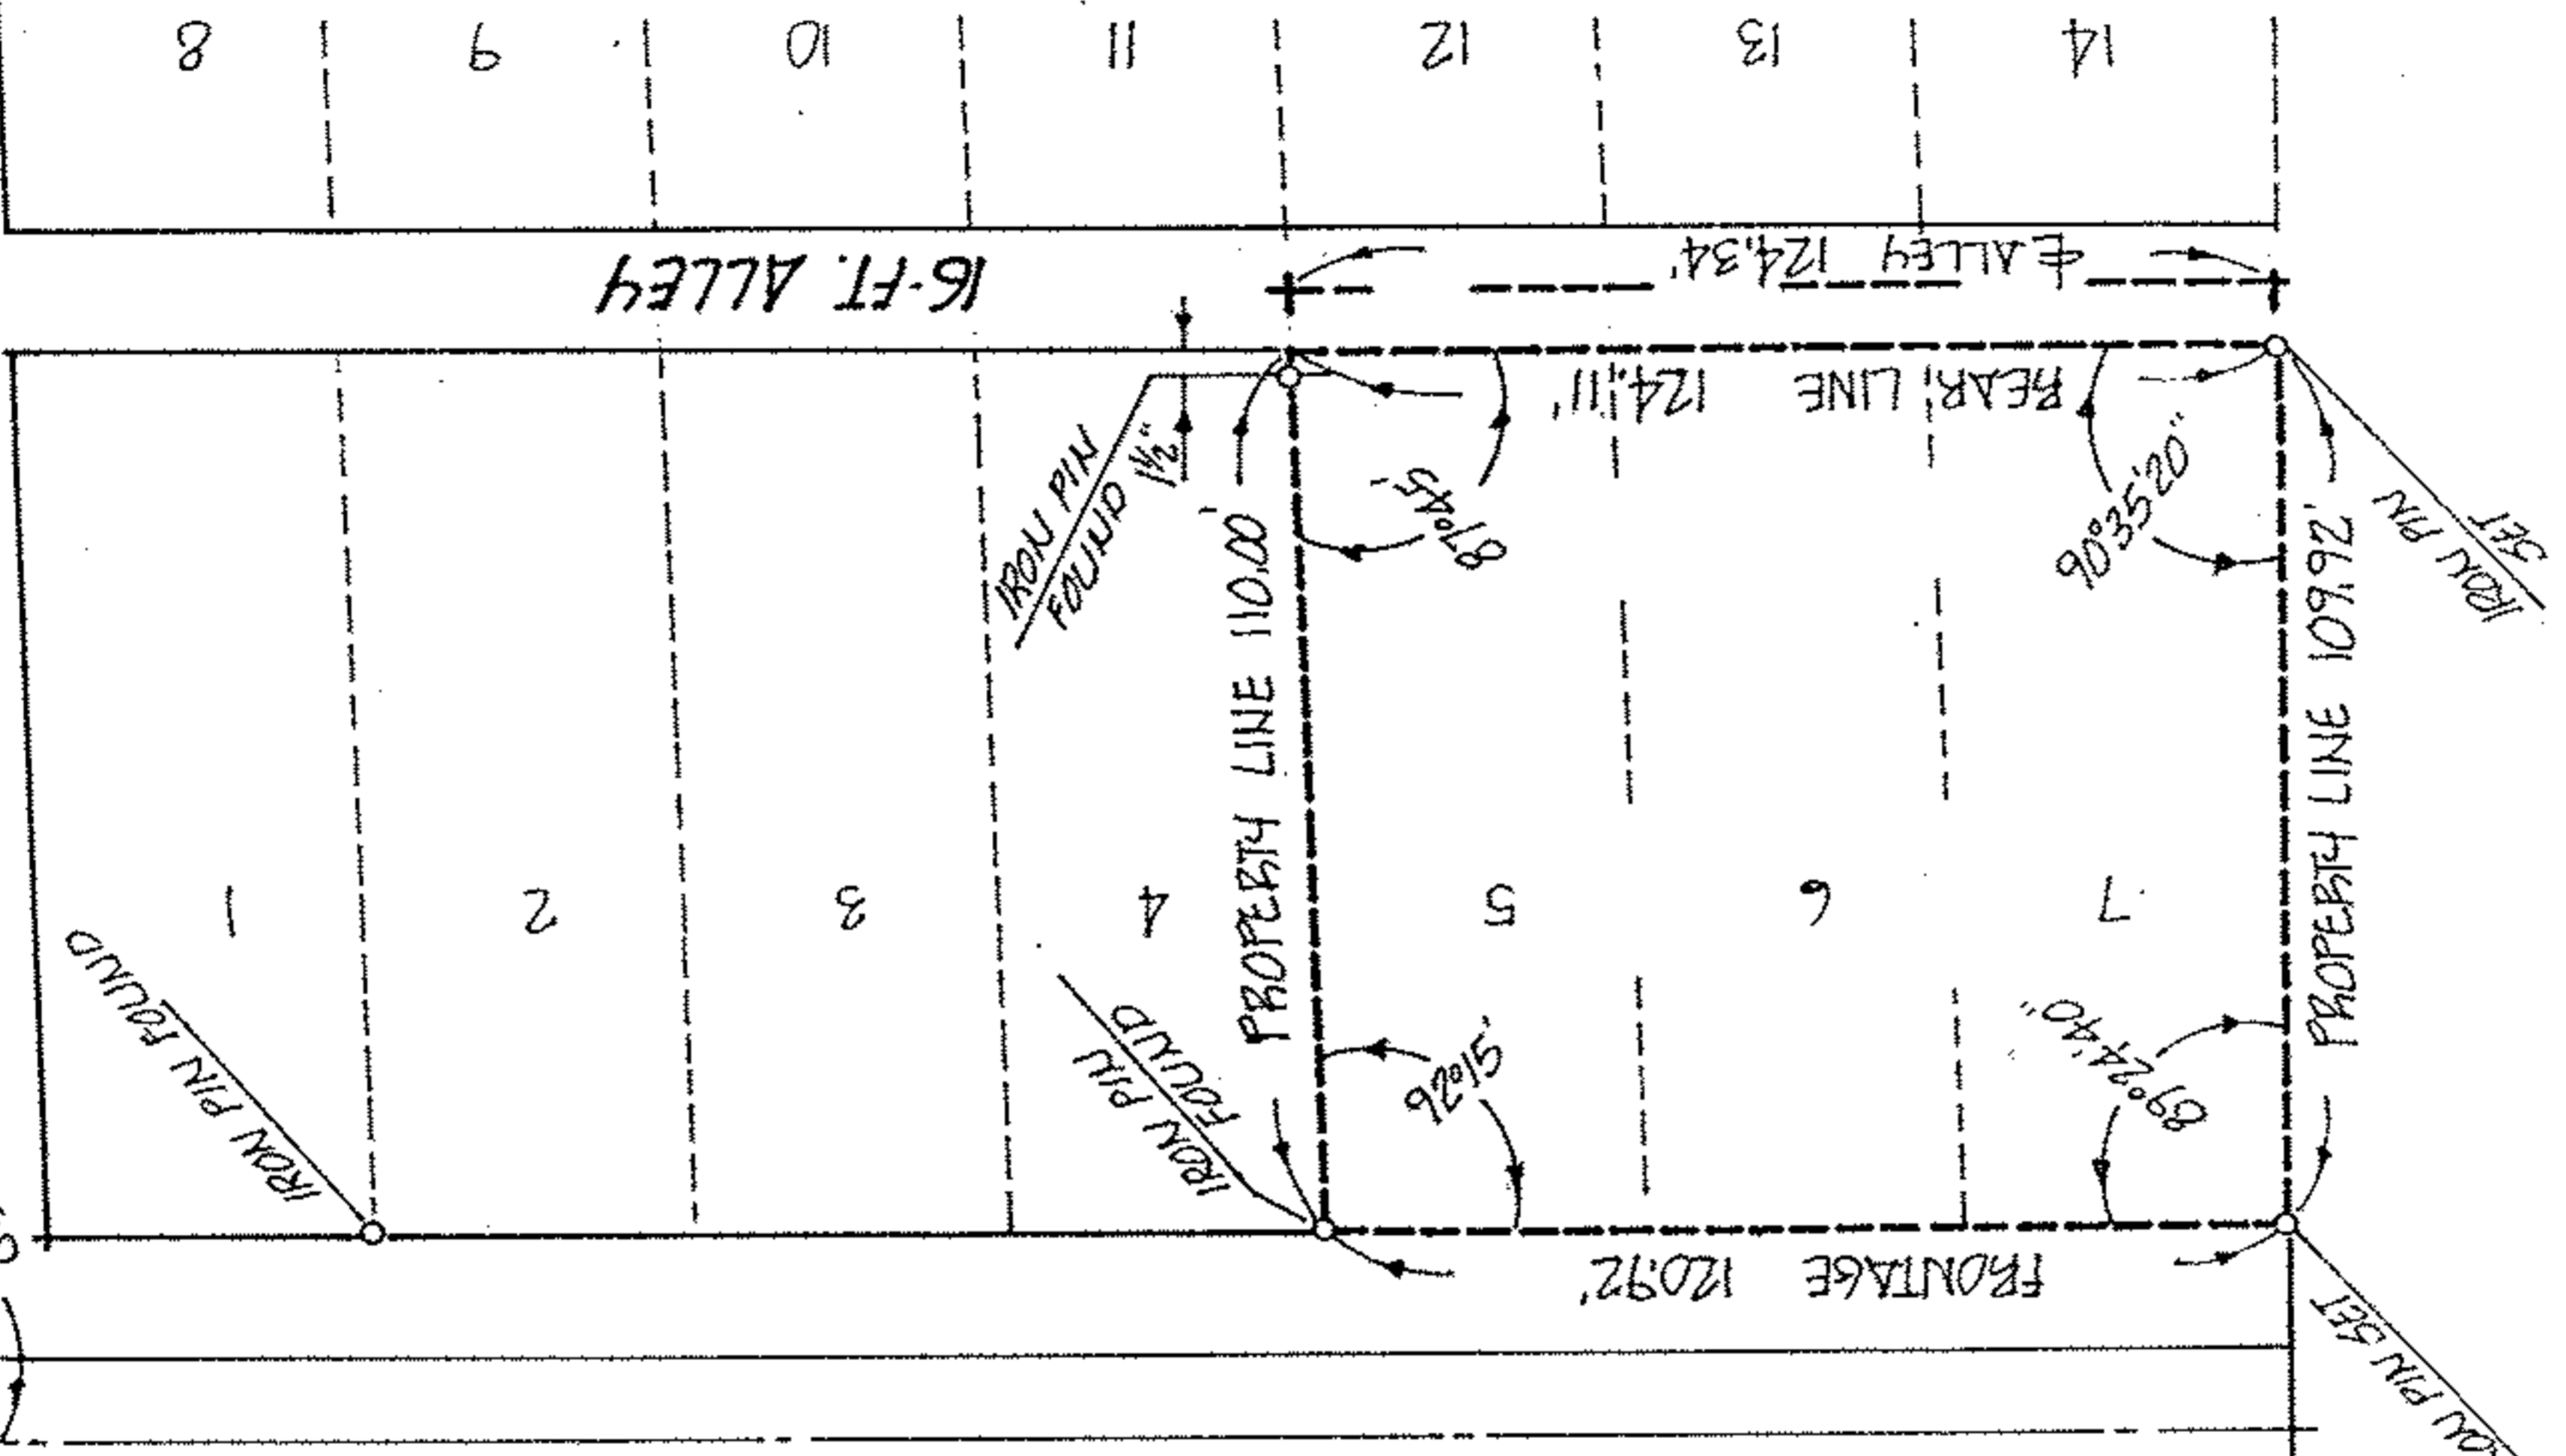

ACREAGE —
 DATE 07-14-86
 DRAWN MGH
 SCALE 1" = 50 ft.



PREPARED FOR MR. VIDAL RODRIGUEZ 277-1778
 2127 ROOSEVELT AVE. LORAIN, O.

MICHAEL G. HURA, registered surveyor.
 12706 MASON RD., VERMILION, O., Ph (216) 965 4040

PERIMETER SURVEY

SUBLOT(S) 5-6 & 7 of BLOCK "F" OF LORAIN
 HEIGHTS ALLOTMENT, Volume 6 Page 21 of PLATS
 PART OF O.L. 109 TRACT SECTION OF
 SHEFFIELD TOWNSHIP LORAIN CO., OHIO
 PERMANENT PARCEL NO: 3-00-109-115-011-013

CITY OF LORAIN