


43709

MAP P5 7-00-047-D  
PPN 07-00-047-000-222

SUGAR RIDGE ROAD 60'  
N-69-28-30-E 448.94  
100.00  
243.94

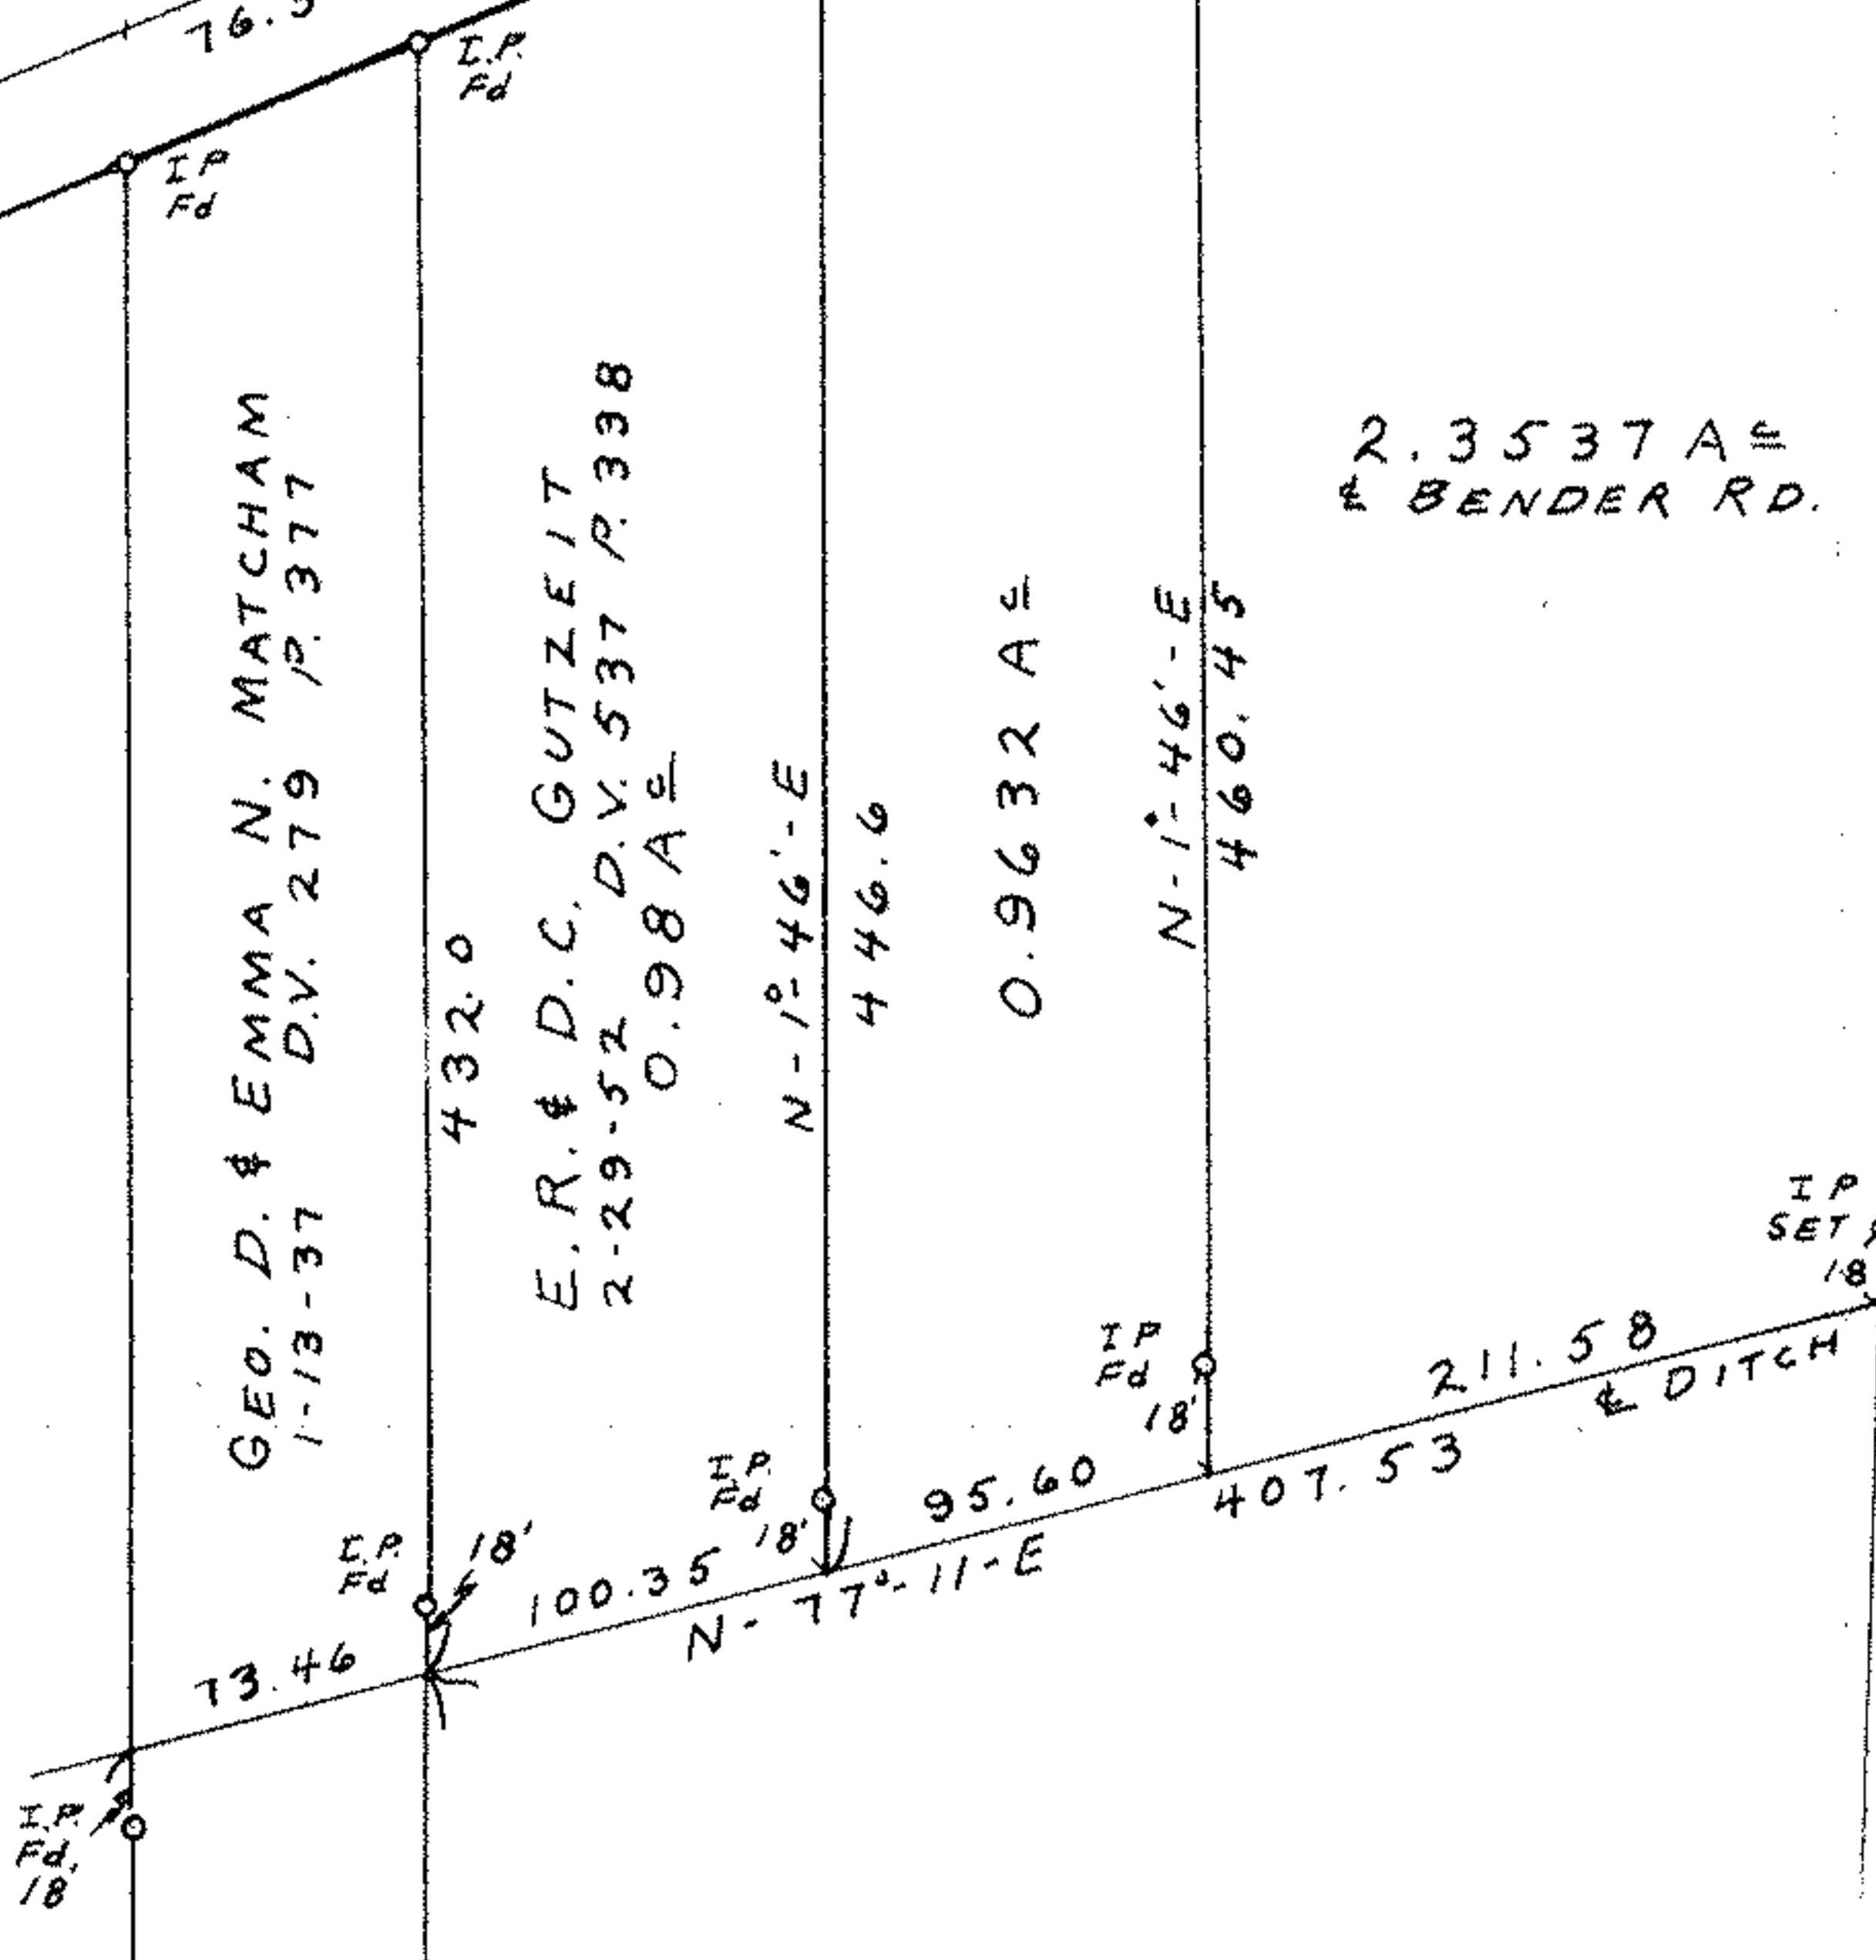

SURVEY FOR  
**FLORENCE L. & JOSEPH H.  
 ECKENFELS**  
 PART OF ORIGINAL LOT 47  
 RIDGEVILLE TWP. LORAIN CO. O.  
 SCALE 1"=100' MARCH 20 1959  
 LAUNDON & HUFFMAN REG SURVEYORS

0.L. 47 71.11 356.34  
 0.L. 48 I.P. Fd. I.P. Fd. I.P. Fd.  
 N-88°-32'-W 20.02