


43710

R. W. BECKETT CORP
5-28-47 D.V. 419-215

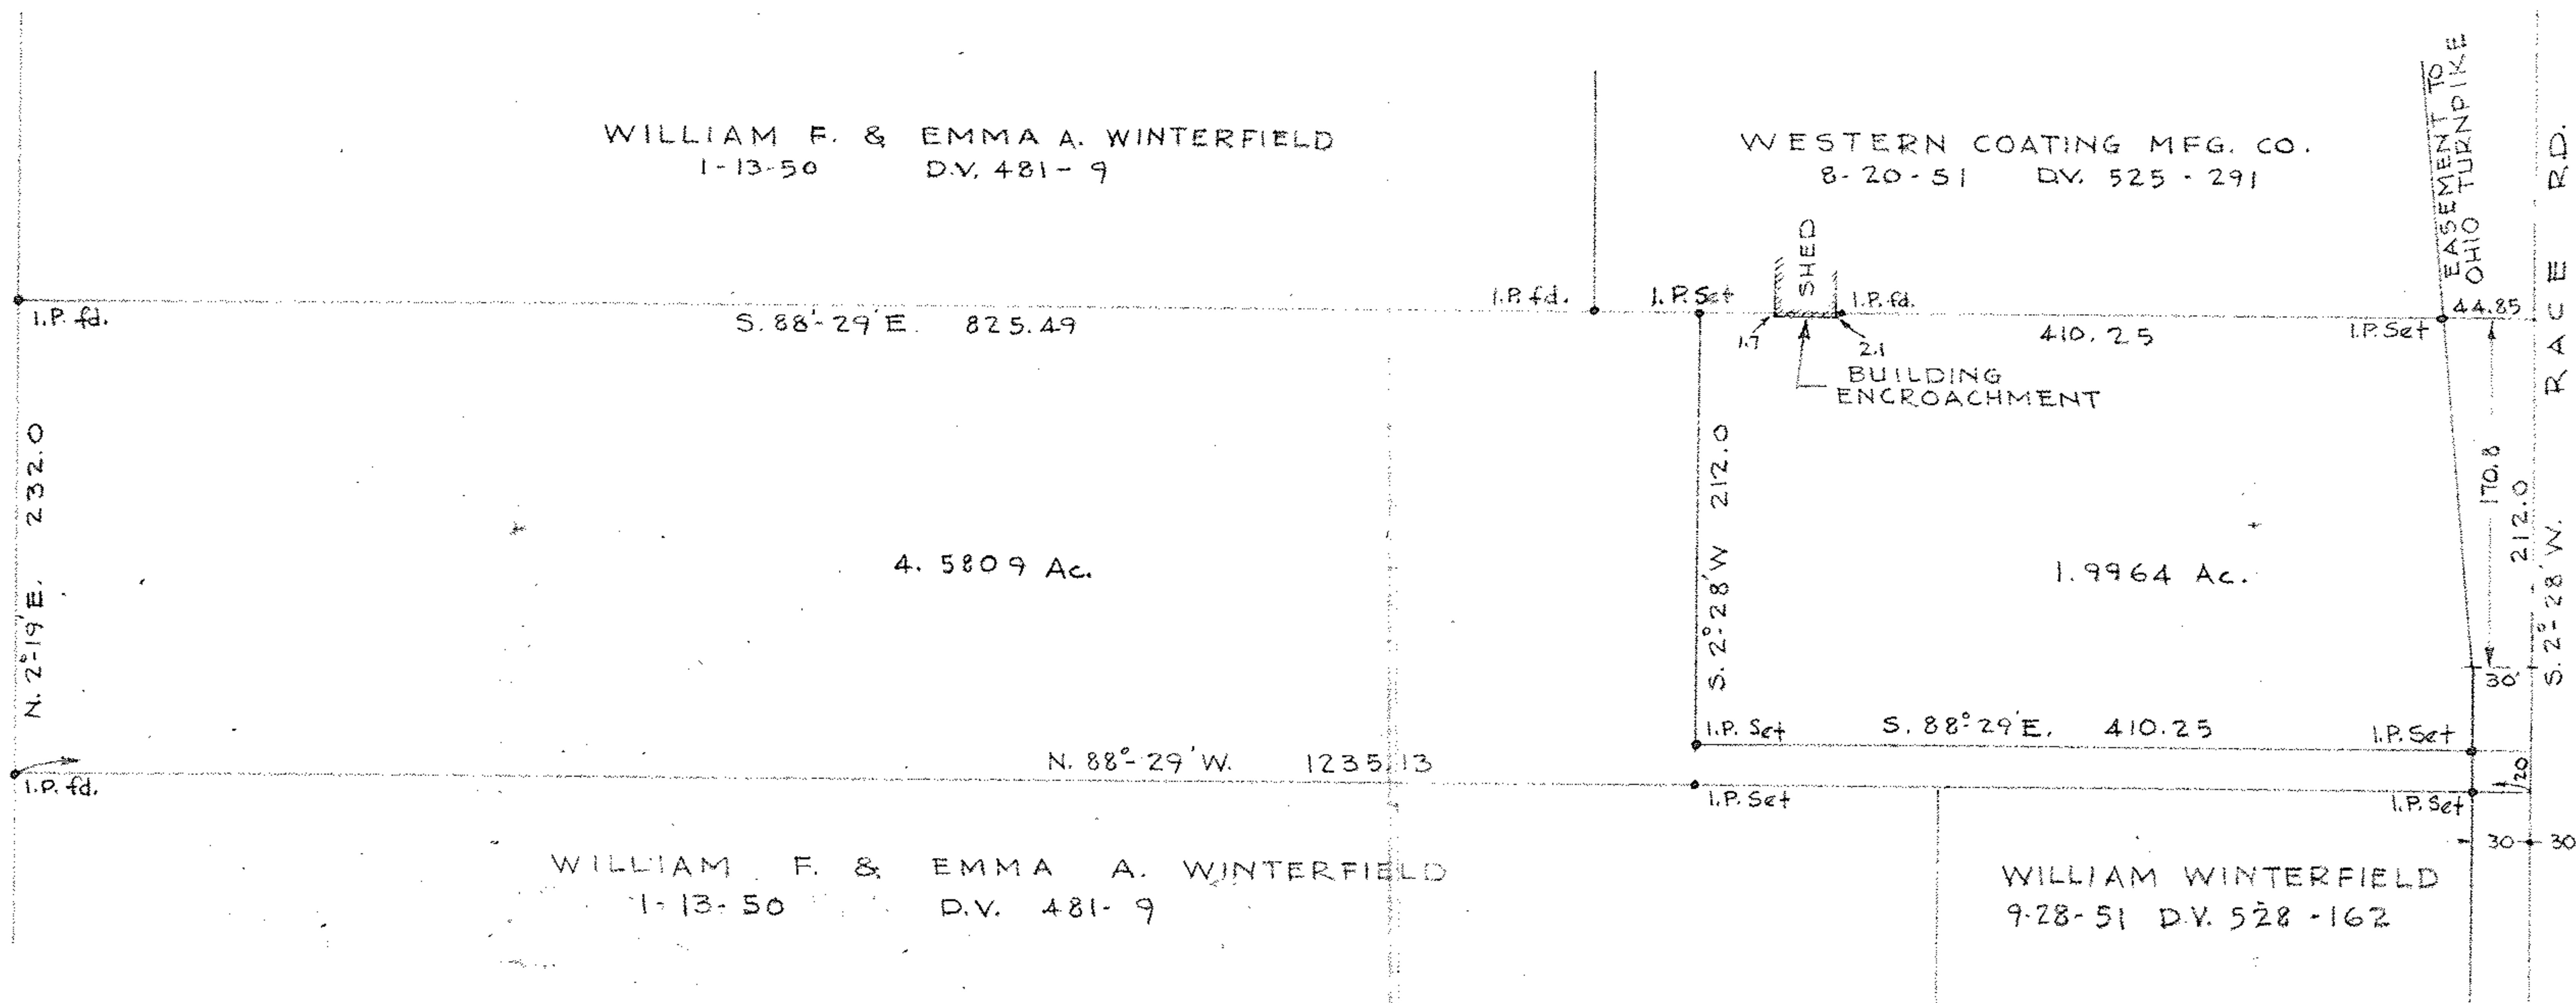

PPN 07-00-039-000-045

MAP PG 7-00-039-D

SURVEY FOR W.F. RYAN CORP.
 O.L. 39 RIDGEVILLE TWP. NORTH RIDGEVILLE CITY
 LORAIN COUNTY OHIO
 SCALE 1"=100'
 LAUNDON & HUFFMAN SURVEYORS
 DEC. 1961