

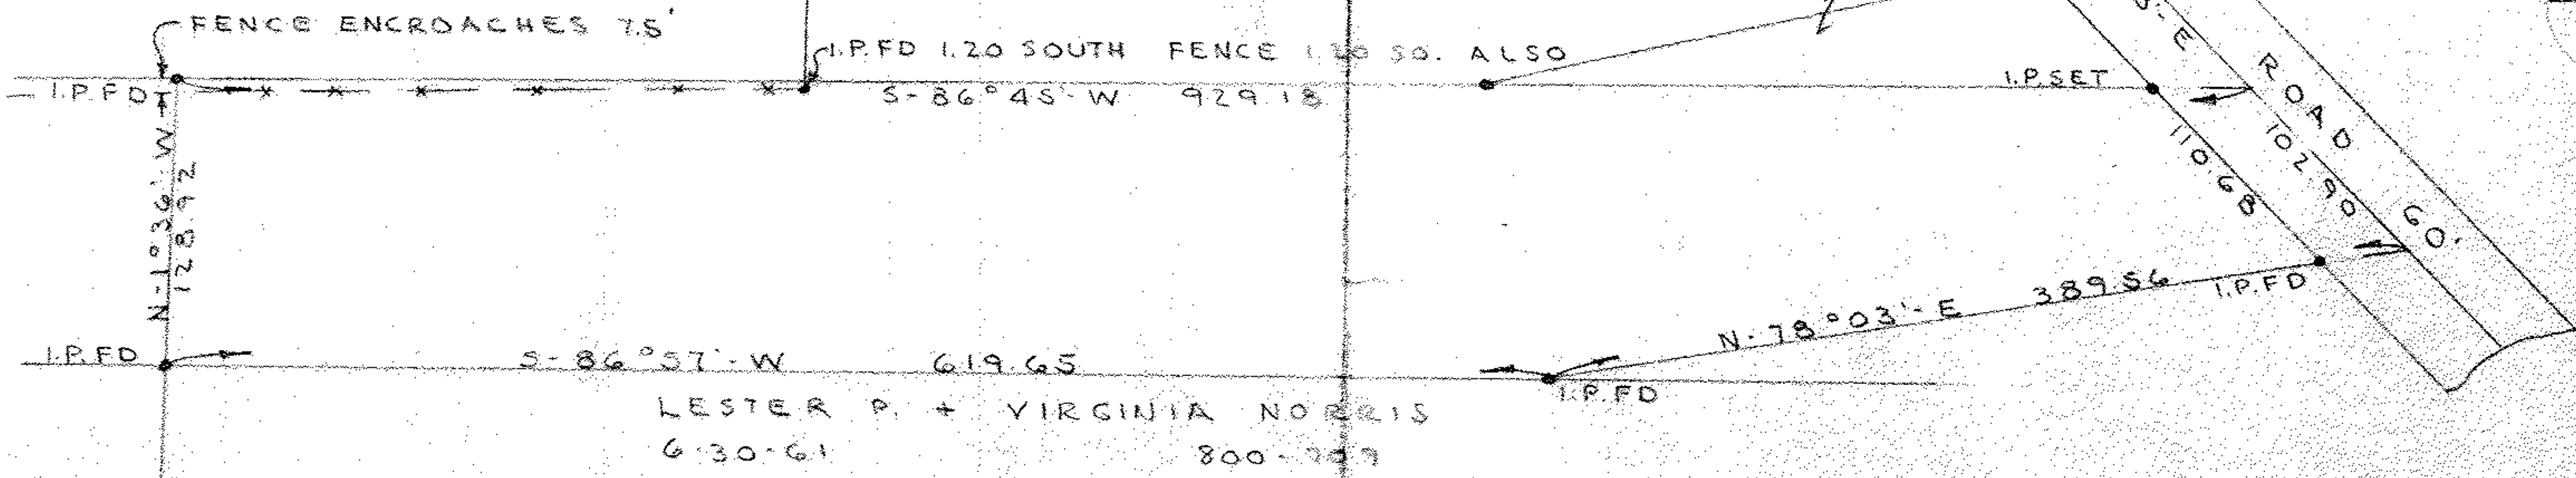


BETTY J. GERHART
7-1-57 699-232

BETTY J. GERHART
10-29-60 785-200

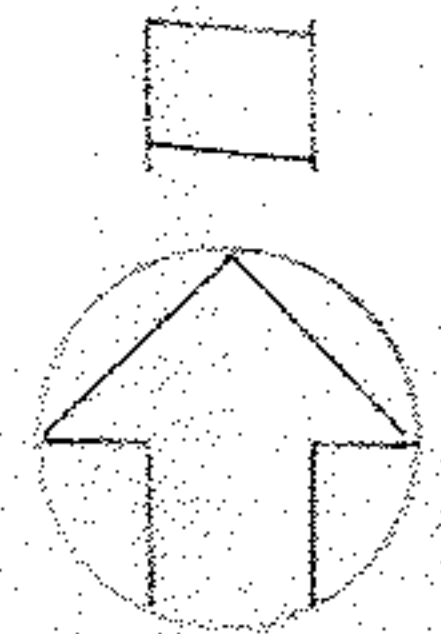

DRIVE LOCATION IN RELATION I.P. N.E. CORNER

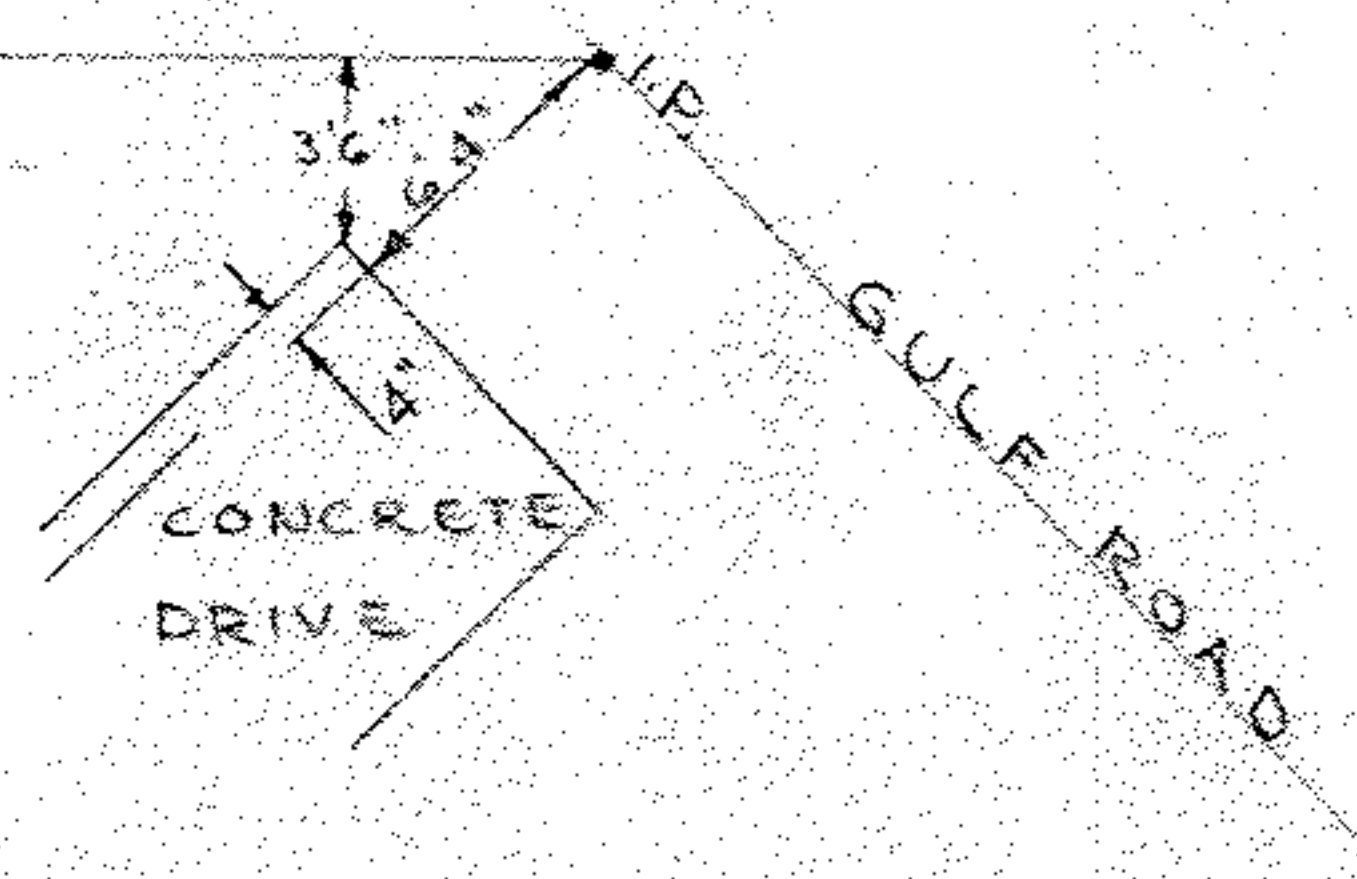

SURVEY FOR FRANK V. & HELEN FIRE
 LOT 6 BURRELL & DAY TRACT
 ELYRIA TOWNSHIP
 ELYRIA CITY LORAIN CO. OHIO
 SCALE 1"=100'
 LAUNDON & HUFFMAN REG SURVEYORS
 MARCH 1962