

MAP PG 5.00-032 A
43765

LORAIN & WEST VIRGINIA R.R. 100'

N 13° 30' E

MILAN
N 55° 28' E
232.10

ELYRIA RD.

66°

252.9

112.75

120.0

76.53

50-17 W 340 2

339.80

S 32° 32' E

271.93

94.54 34° 49'

0.097 AC.

54.08

0.9196 AC. E

697-58

4/23/57

RICH to JAMES

E. RETHA EBERHARDT

7-27-49
D.V. 471-111

N 60° 22' N

56.582


E. RETHA EBERHARDT

4-20-51-393
D.V. 515-393

S 55° 28' W

E. RETHA EBERHARDT

3-31-49
D.V. 461-116

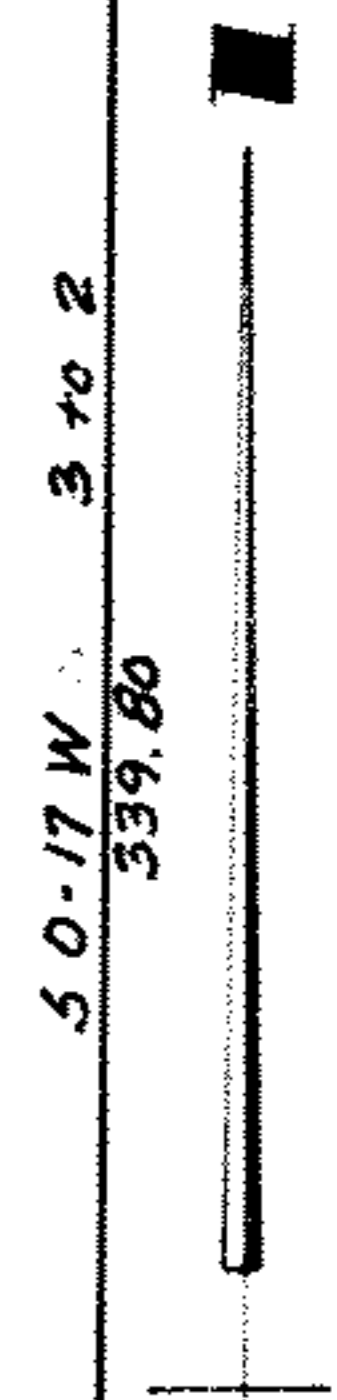

29-52 O.V. 537-13

C. J. EHRMAN to W. J. & M. J.

2/9/52
537-13

SURVEY FOR WM. & MARTHA JAMIE
PART OF O.L. 32 AMHERST TWP.
LORAIN COUNTY, OHIO
FEB. 19, 1959 - SCALE 1"=50'
LAUNDON & HUFFMAN - REG. SURVEYORS