


Plat of Survey
Brill View Farms

Pittsfield Twp.
 Lorain Co.

O.L. 108
 Ohio

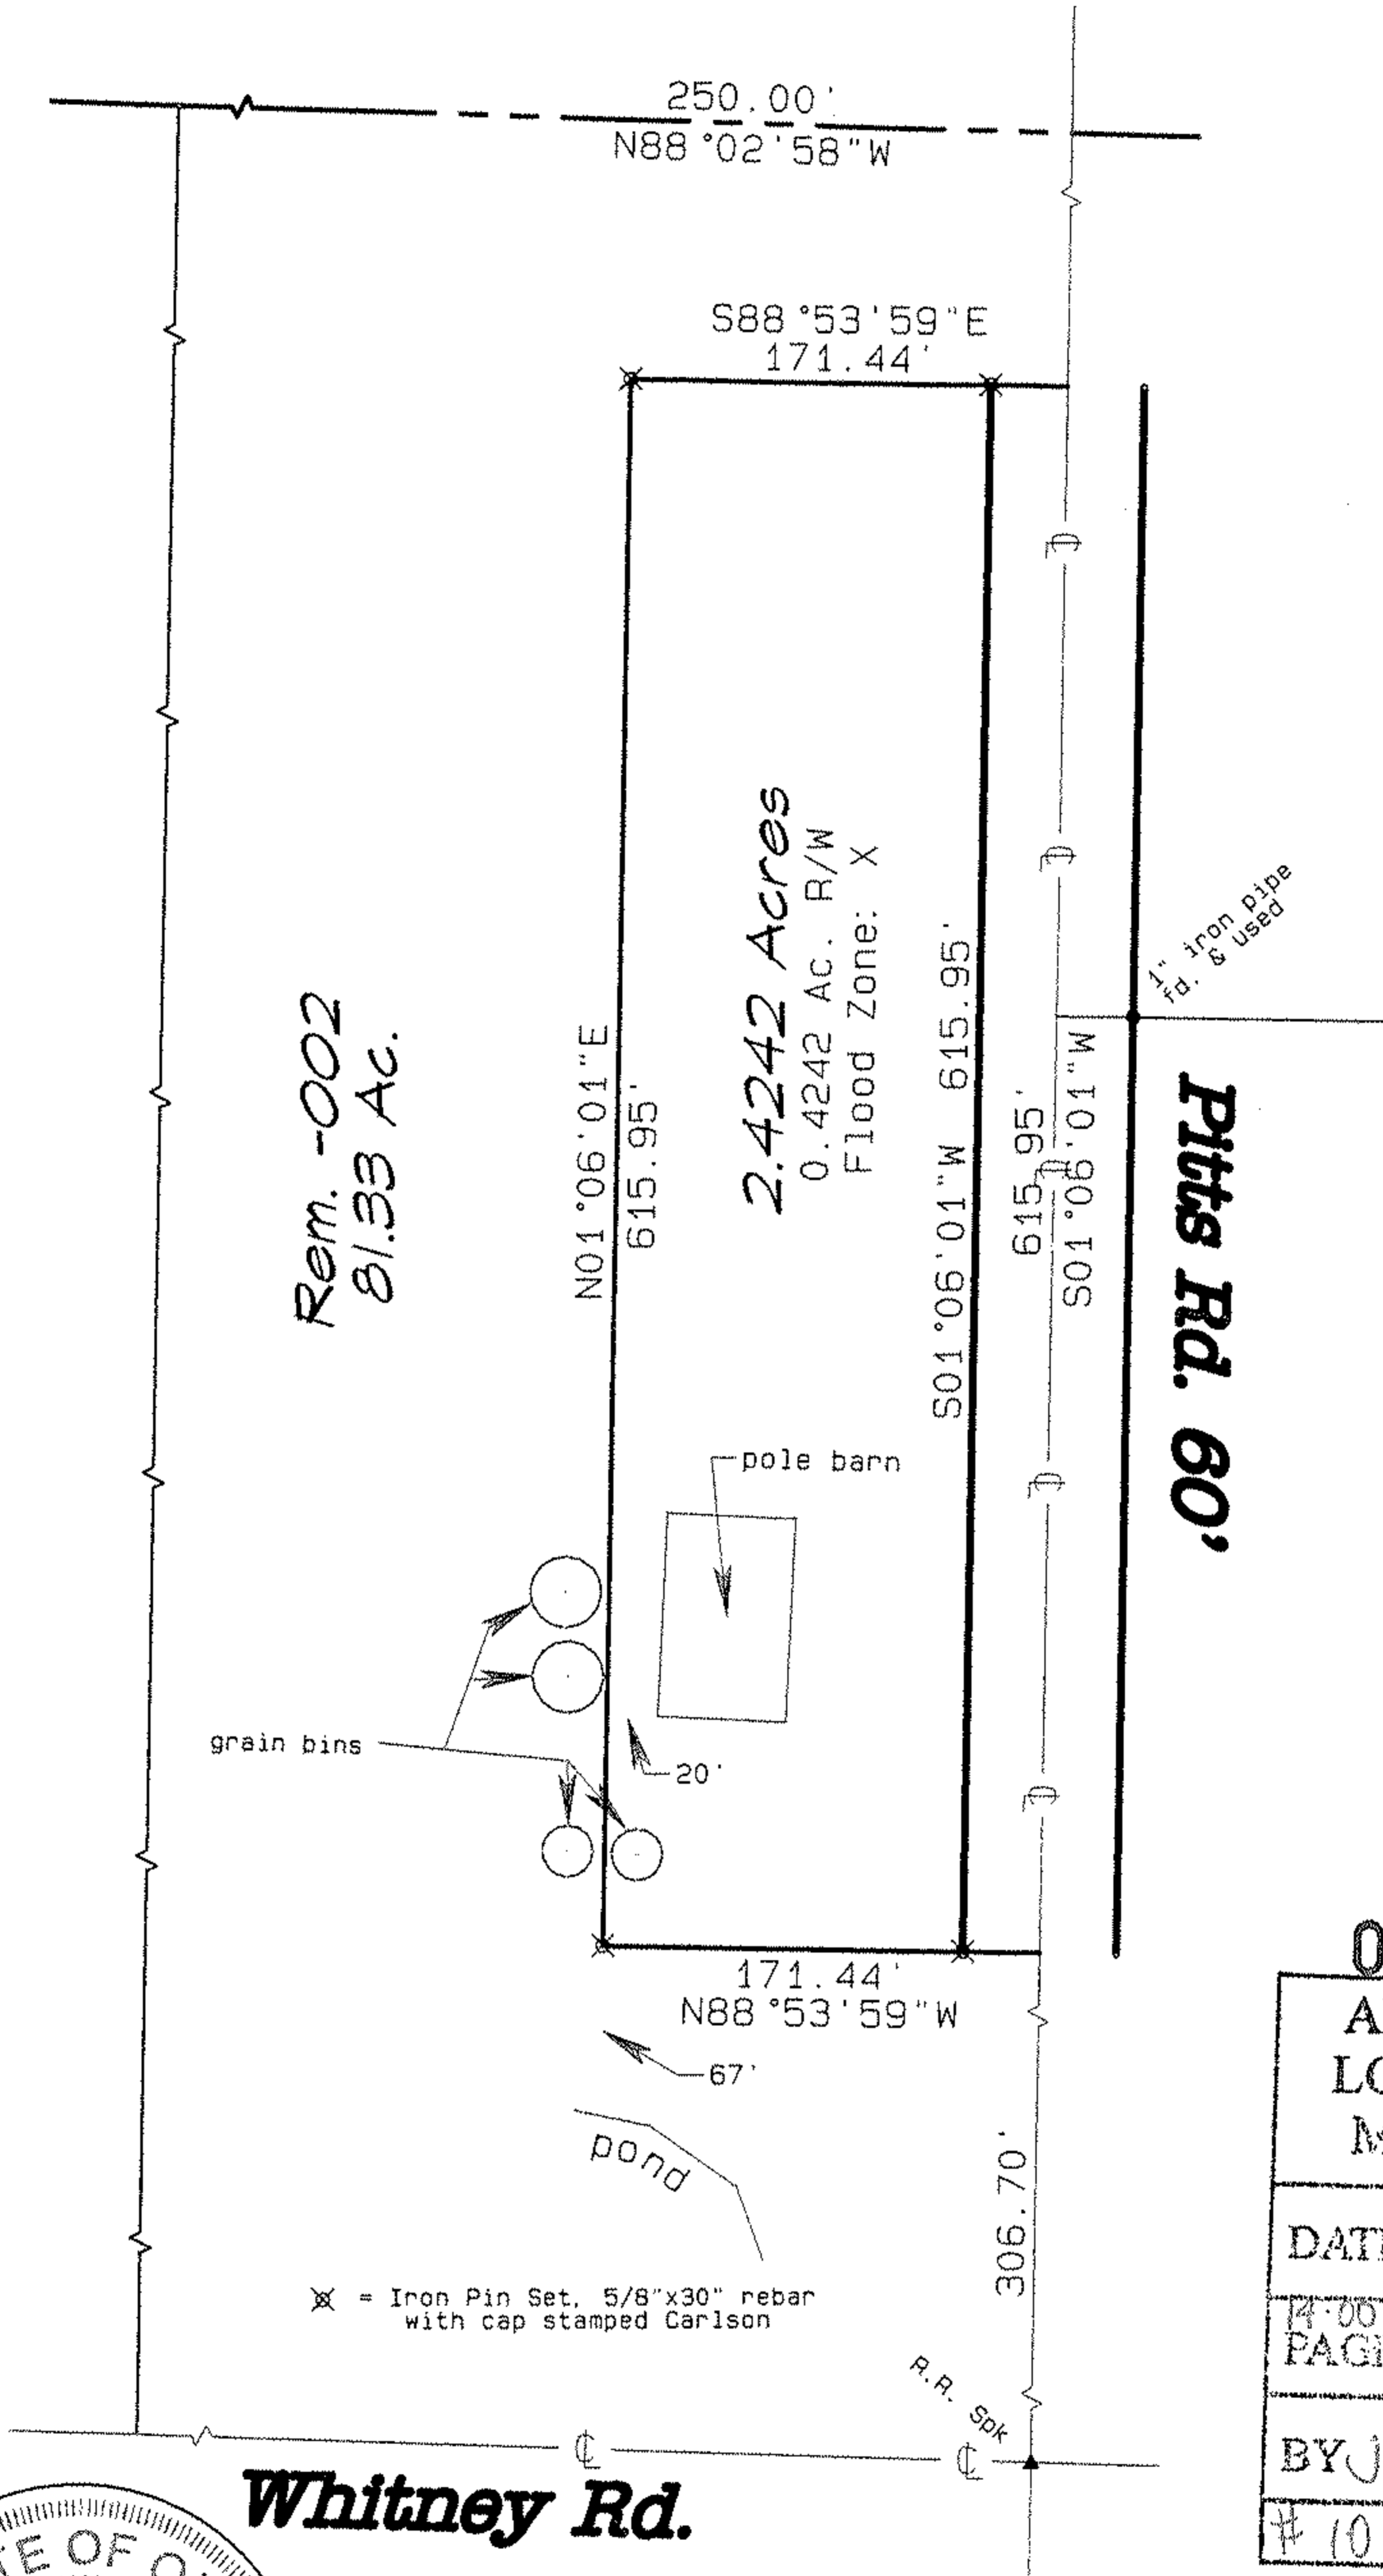


Rem. -002
 81.33 Ac.

2.4242 Acres
 0.4242 Ac. R/W
 Flood Zone: X

Pitts Rd. 60'

02803
APPROVED LORAIN CO. MAP DEPT
DATE 2-18-10
14-00-108-000-002 PAGE 14-00-108-AB
BY JHATfield
10-02803

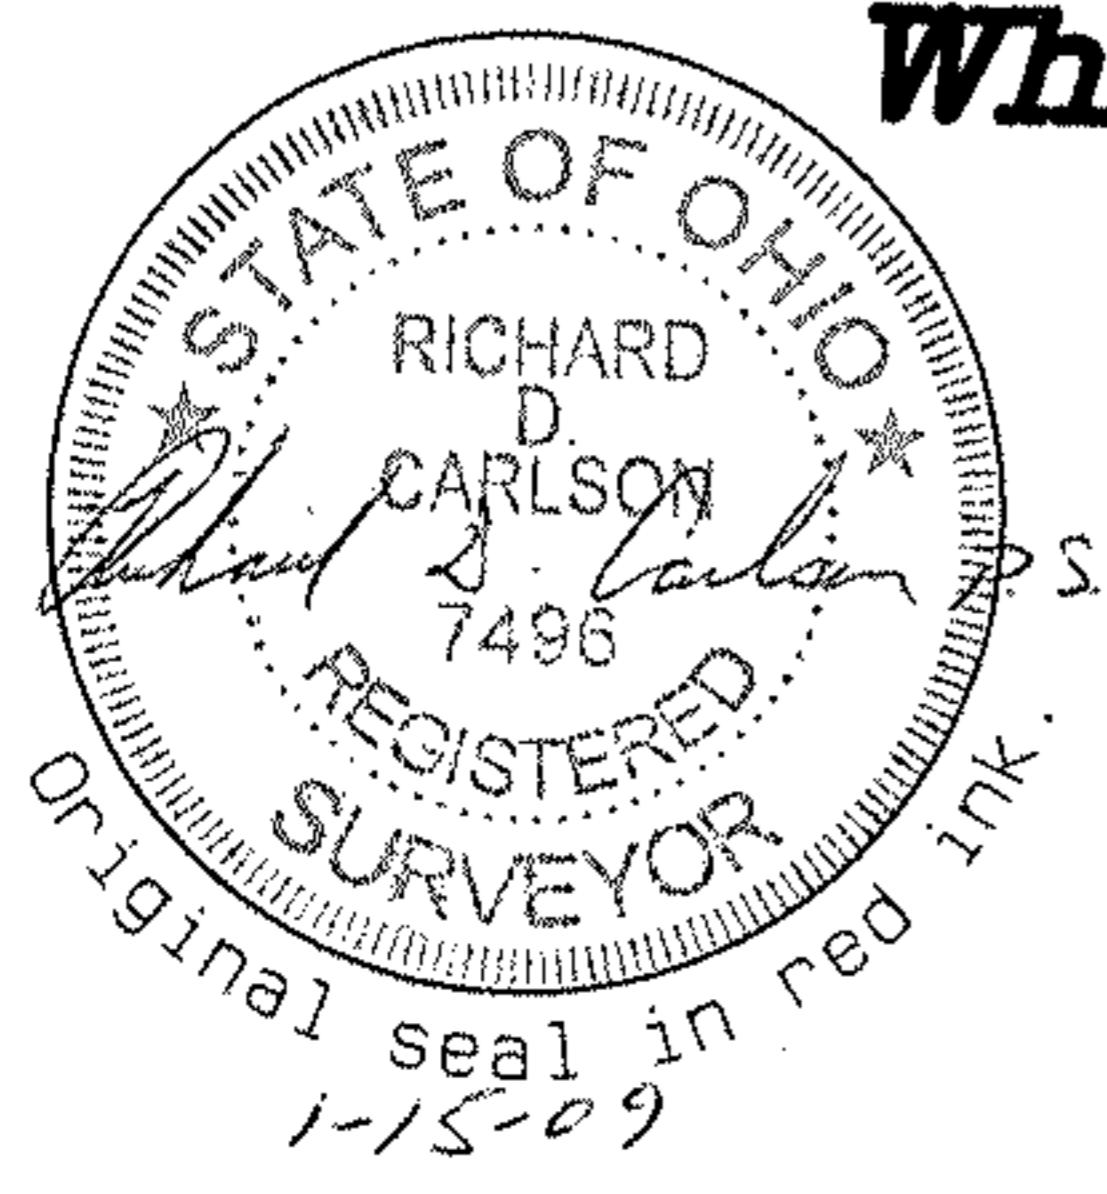

Carlson Surveys
 January 9, 2009
 Job: 1402-09R

Whitney Rd.