



PPN 09-00-055-000-030

9-F 09-00-055-000-030

MAP PG 9-F 43866

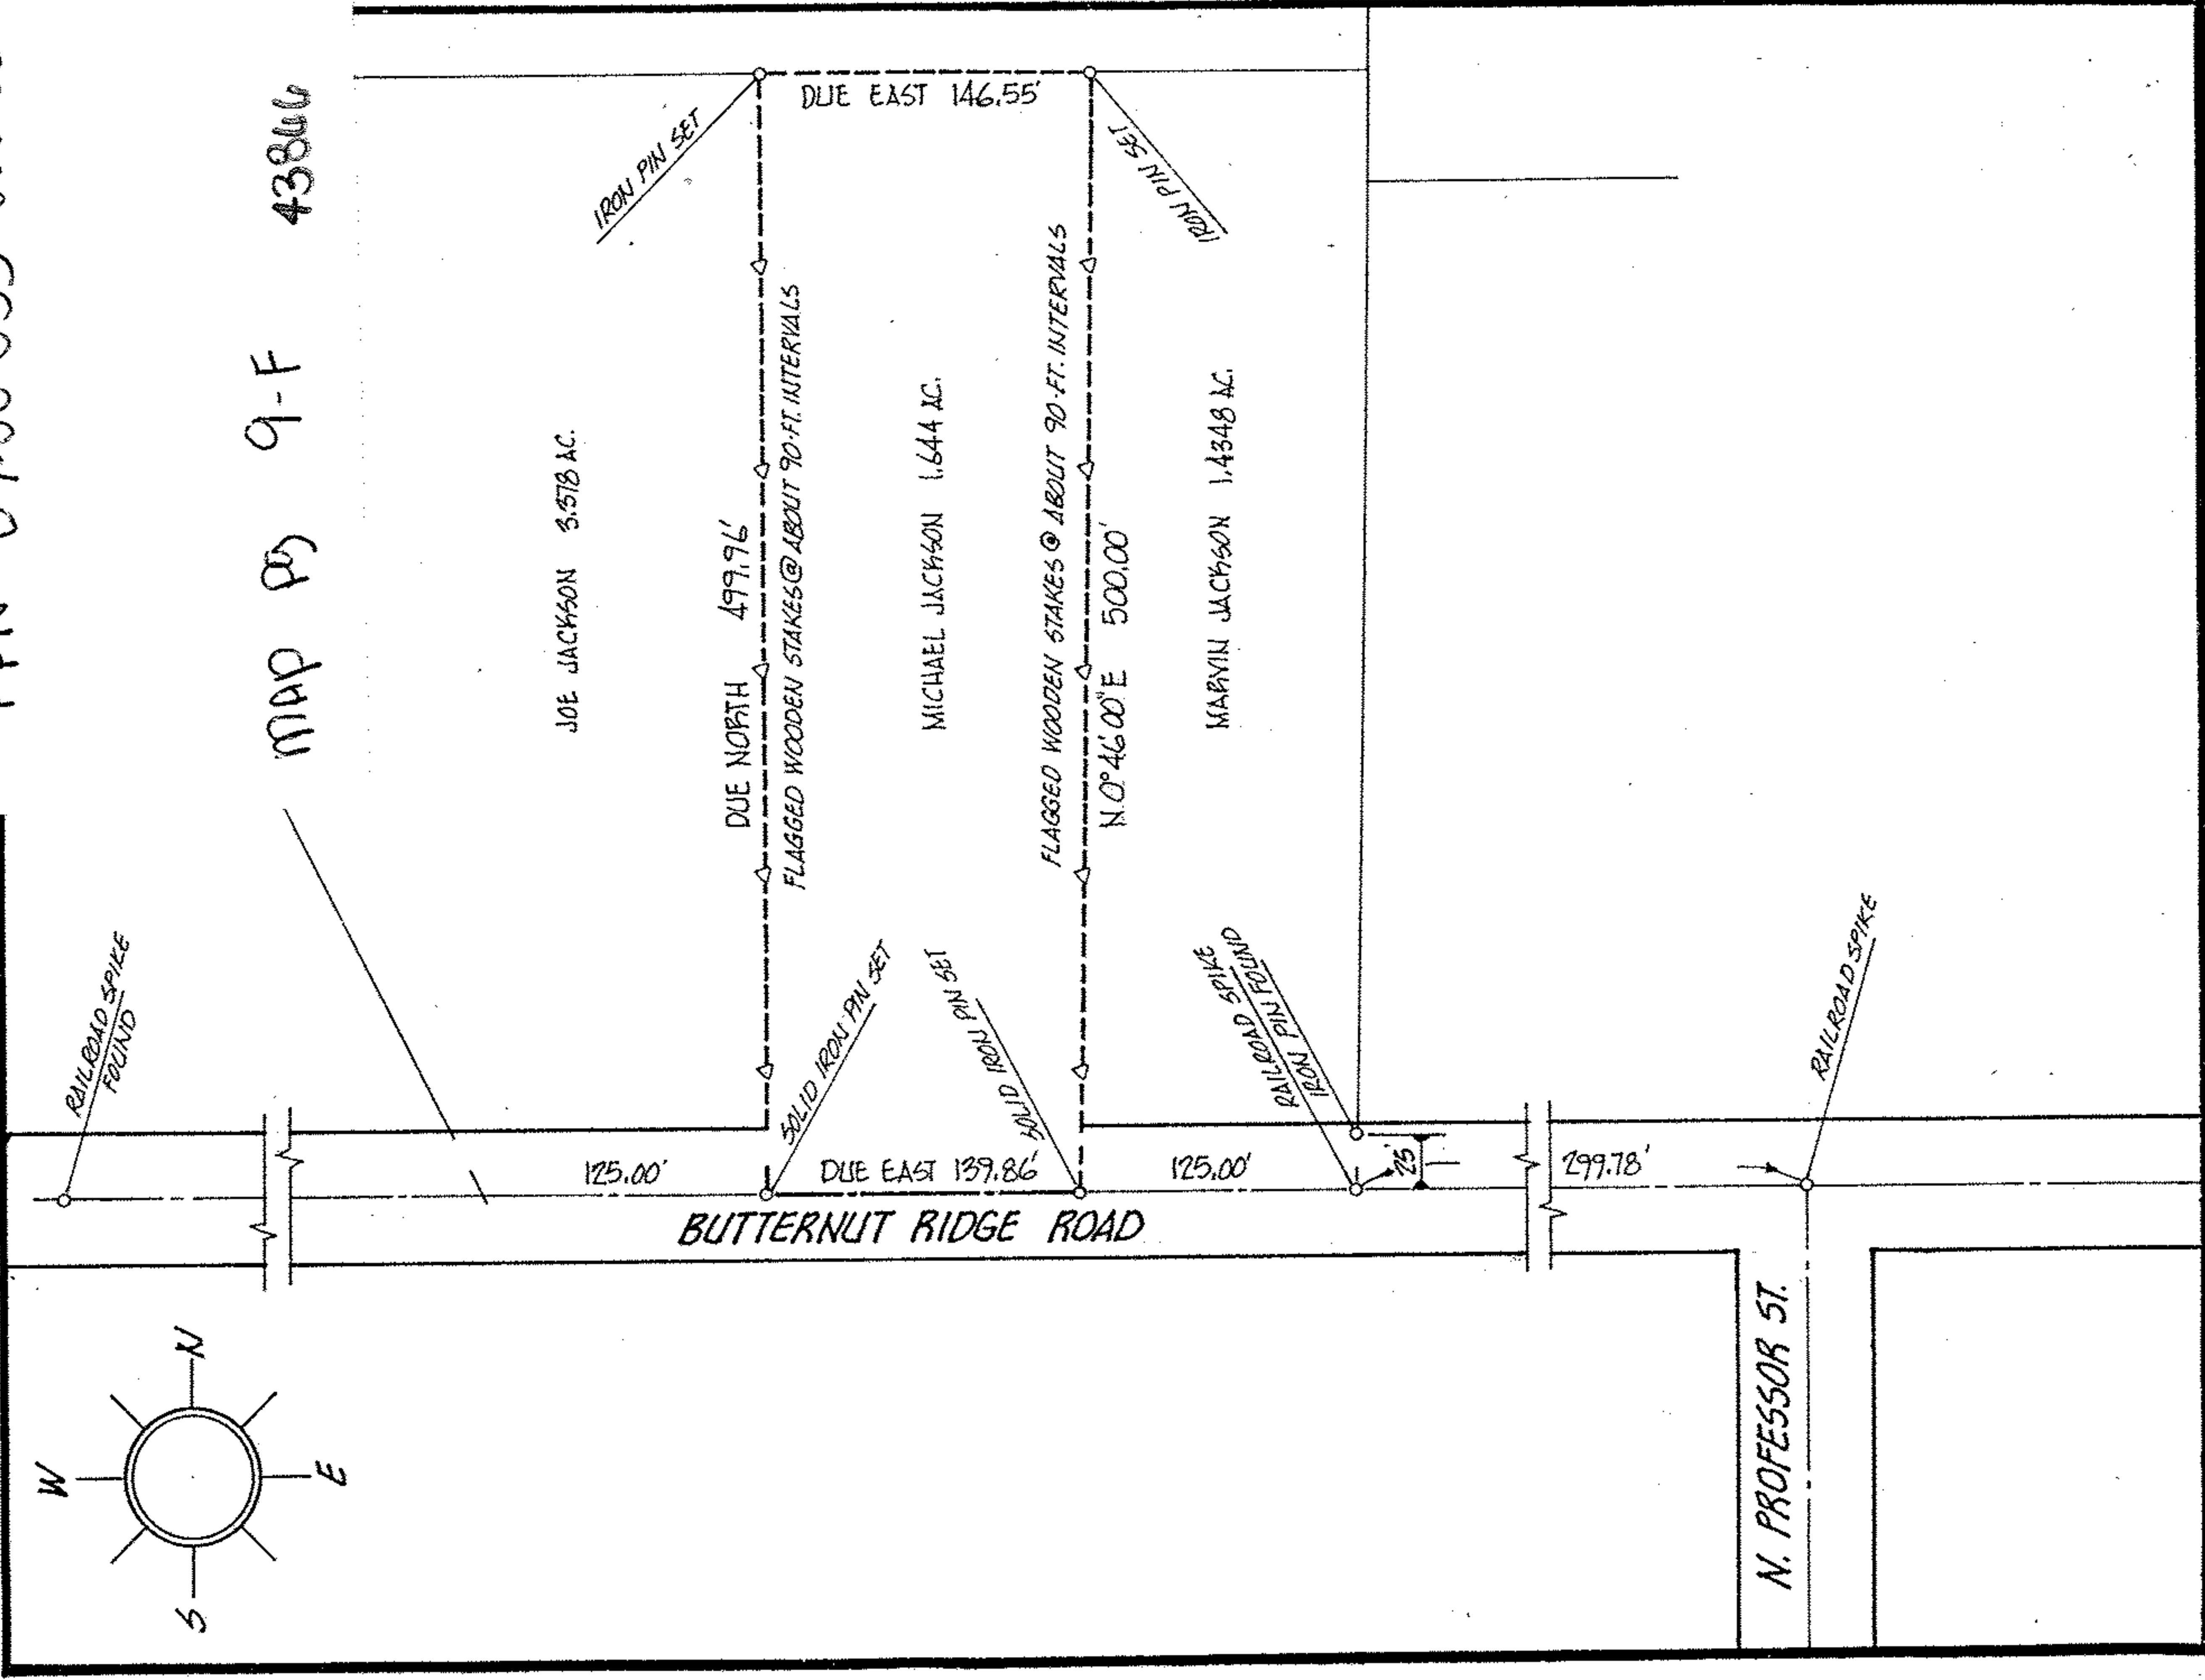

ACREAGE	1.644
DATE	06-26-86
DRAWN	MGH
SCALE	1" = 100 ft.
	
PREPARED FOR <u>MR. MICHAEL JACKSON</u> <u>2014 W. 25th ST. LORAIN, OHIO</u>	
CITY OF	
MICHAEL G. HURA, registered surveyor. 12706 MASON RD., VERMILION, O., Ph (216) 965 4040	
PERIMETER SURVEY	
SUBLOT(s) _____ of _____ of _____ of PLATS PART OF O.L. <u>55</u> TRACT _____ SECTION _____ OF <u>RUSSIA</u> TOWNSHIP <u>LORAIN</u> CO., OHIO	
PERMANENT PARCEL NO: _____	