


43870

MAP Pg 14-C

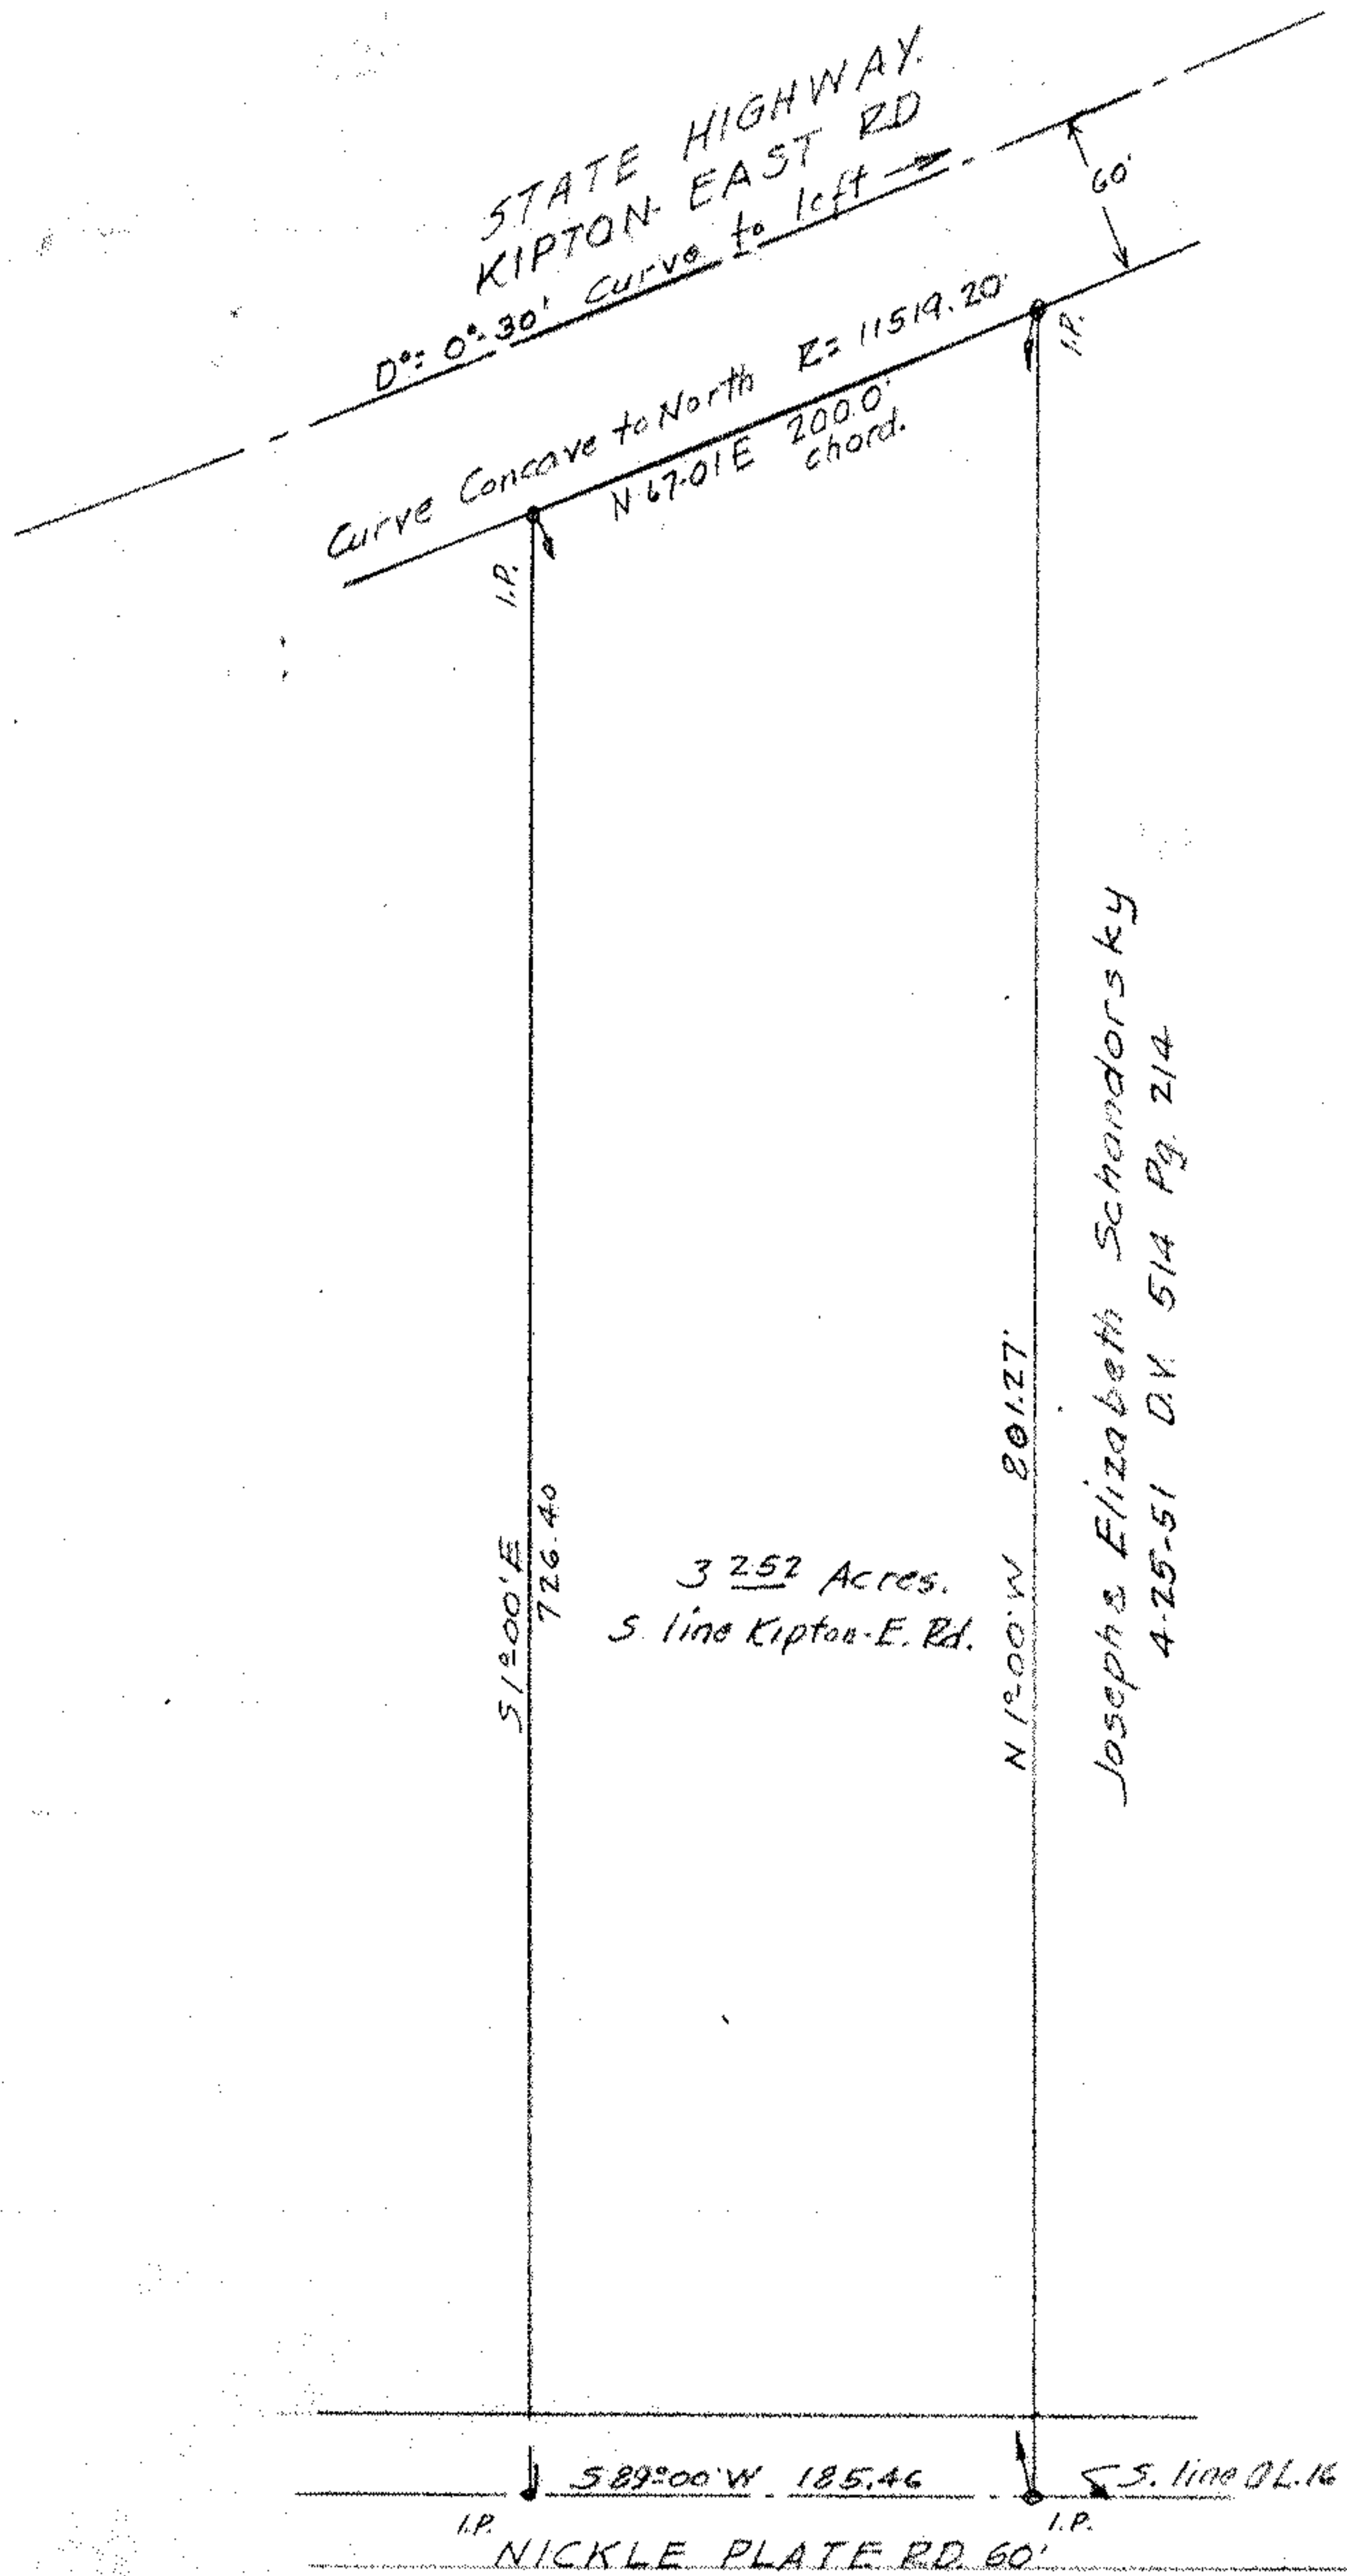

SURVEY FOR HELEN & ROLAND KOENITZER  
PART OF O.L. 16 PITTSFIELD TOWNSHIP  
LORAIN CO. OHIO SCALE 1" = 100'  
FEBY. 27 1952 T.W. LAUNDON REG. SURVEYOR.