


PPN 09-00-095 106-012


MAP pg 09-00-095-B  
43952

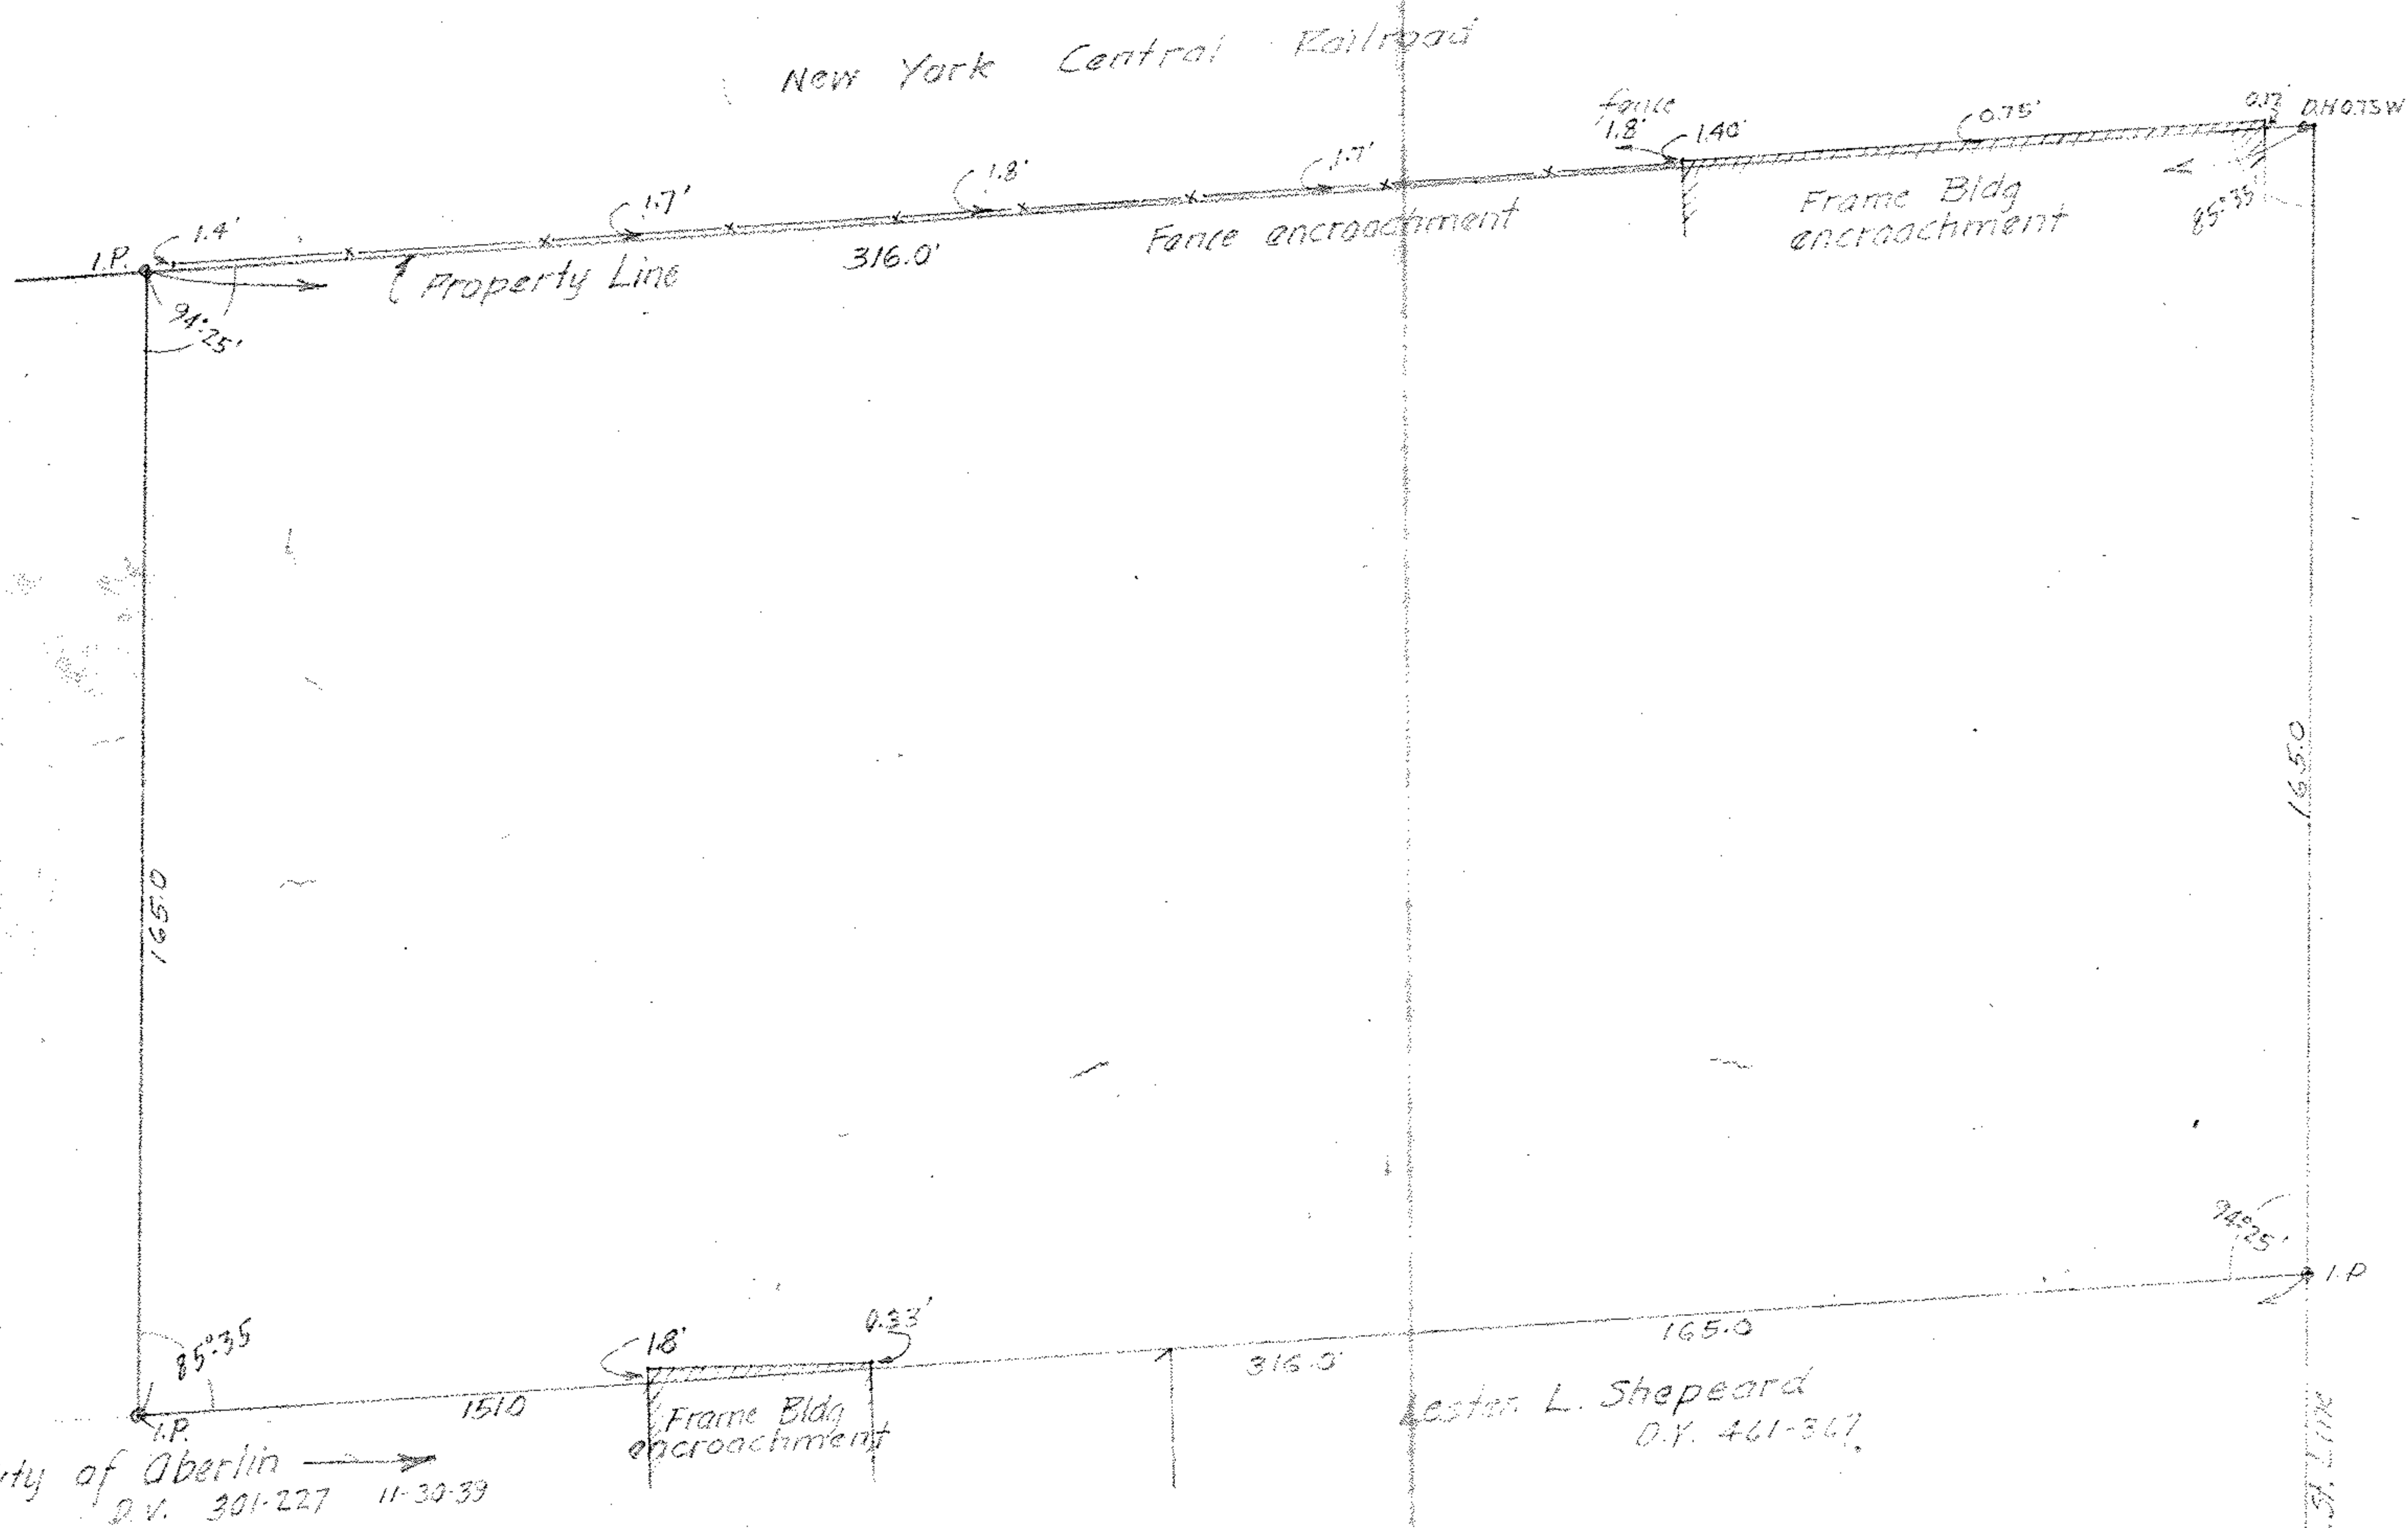

SOUTH MAIN ST. 66'

City of Oberlin  
D.V. 301-227 11-30-39

Lester L. Sheppard  
D.V. 461-367

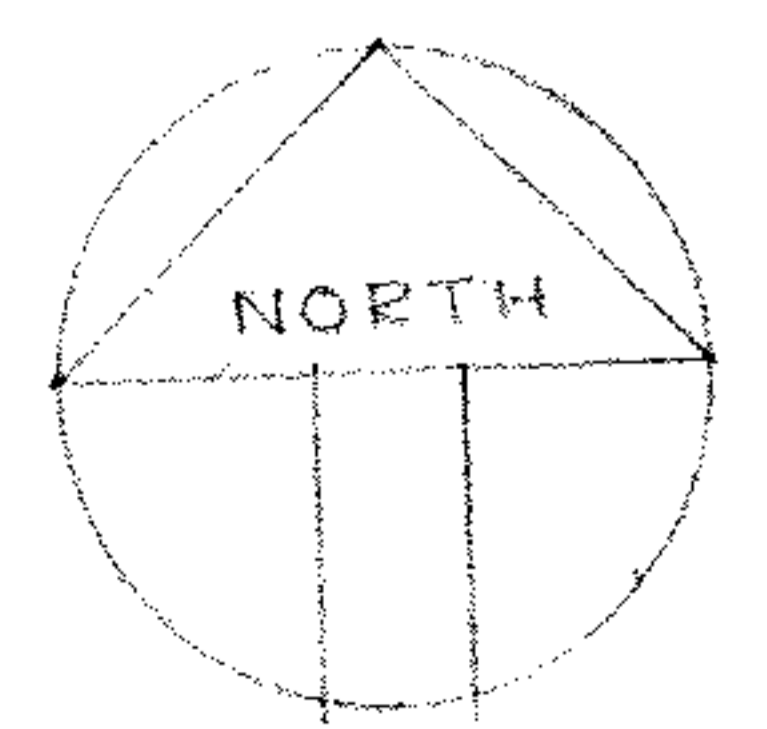

SURVEY FOR HIXON-PETERSON LUMBER CO.  
 PART SUB LOT 7 FOLLETT'S 1ST ADDN  
 OUTLOT 60 TOWNSHIP LOT 95 RUSSIA TWP.  
 OBERLIN CITY, LORAIN CO. OHIO.  
 SCALE 1" = 30' AUG. 23 1954  
 T.W. LAUNDON REG. SURVEYOR 689