


PPN 09-00-095-102-???

MAP Pg 09-00-095-A

43954

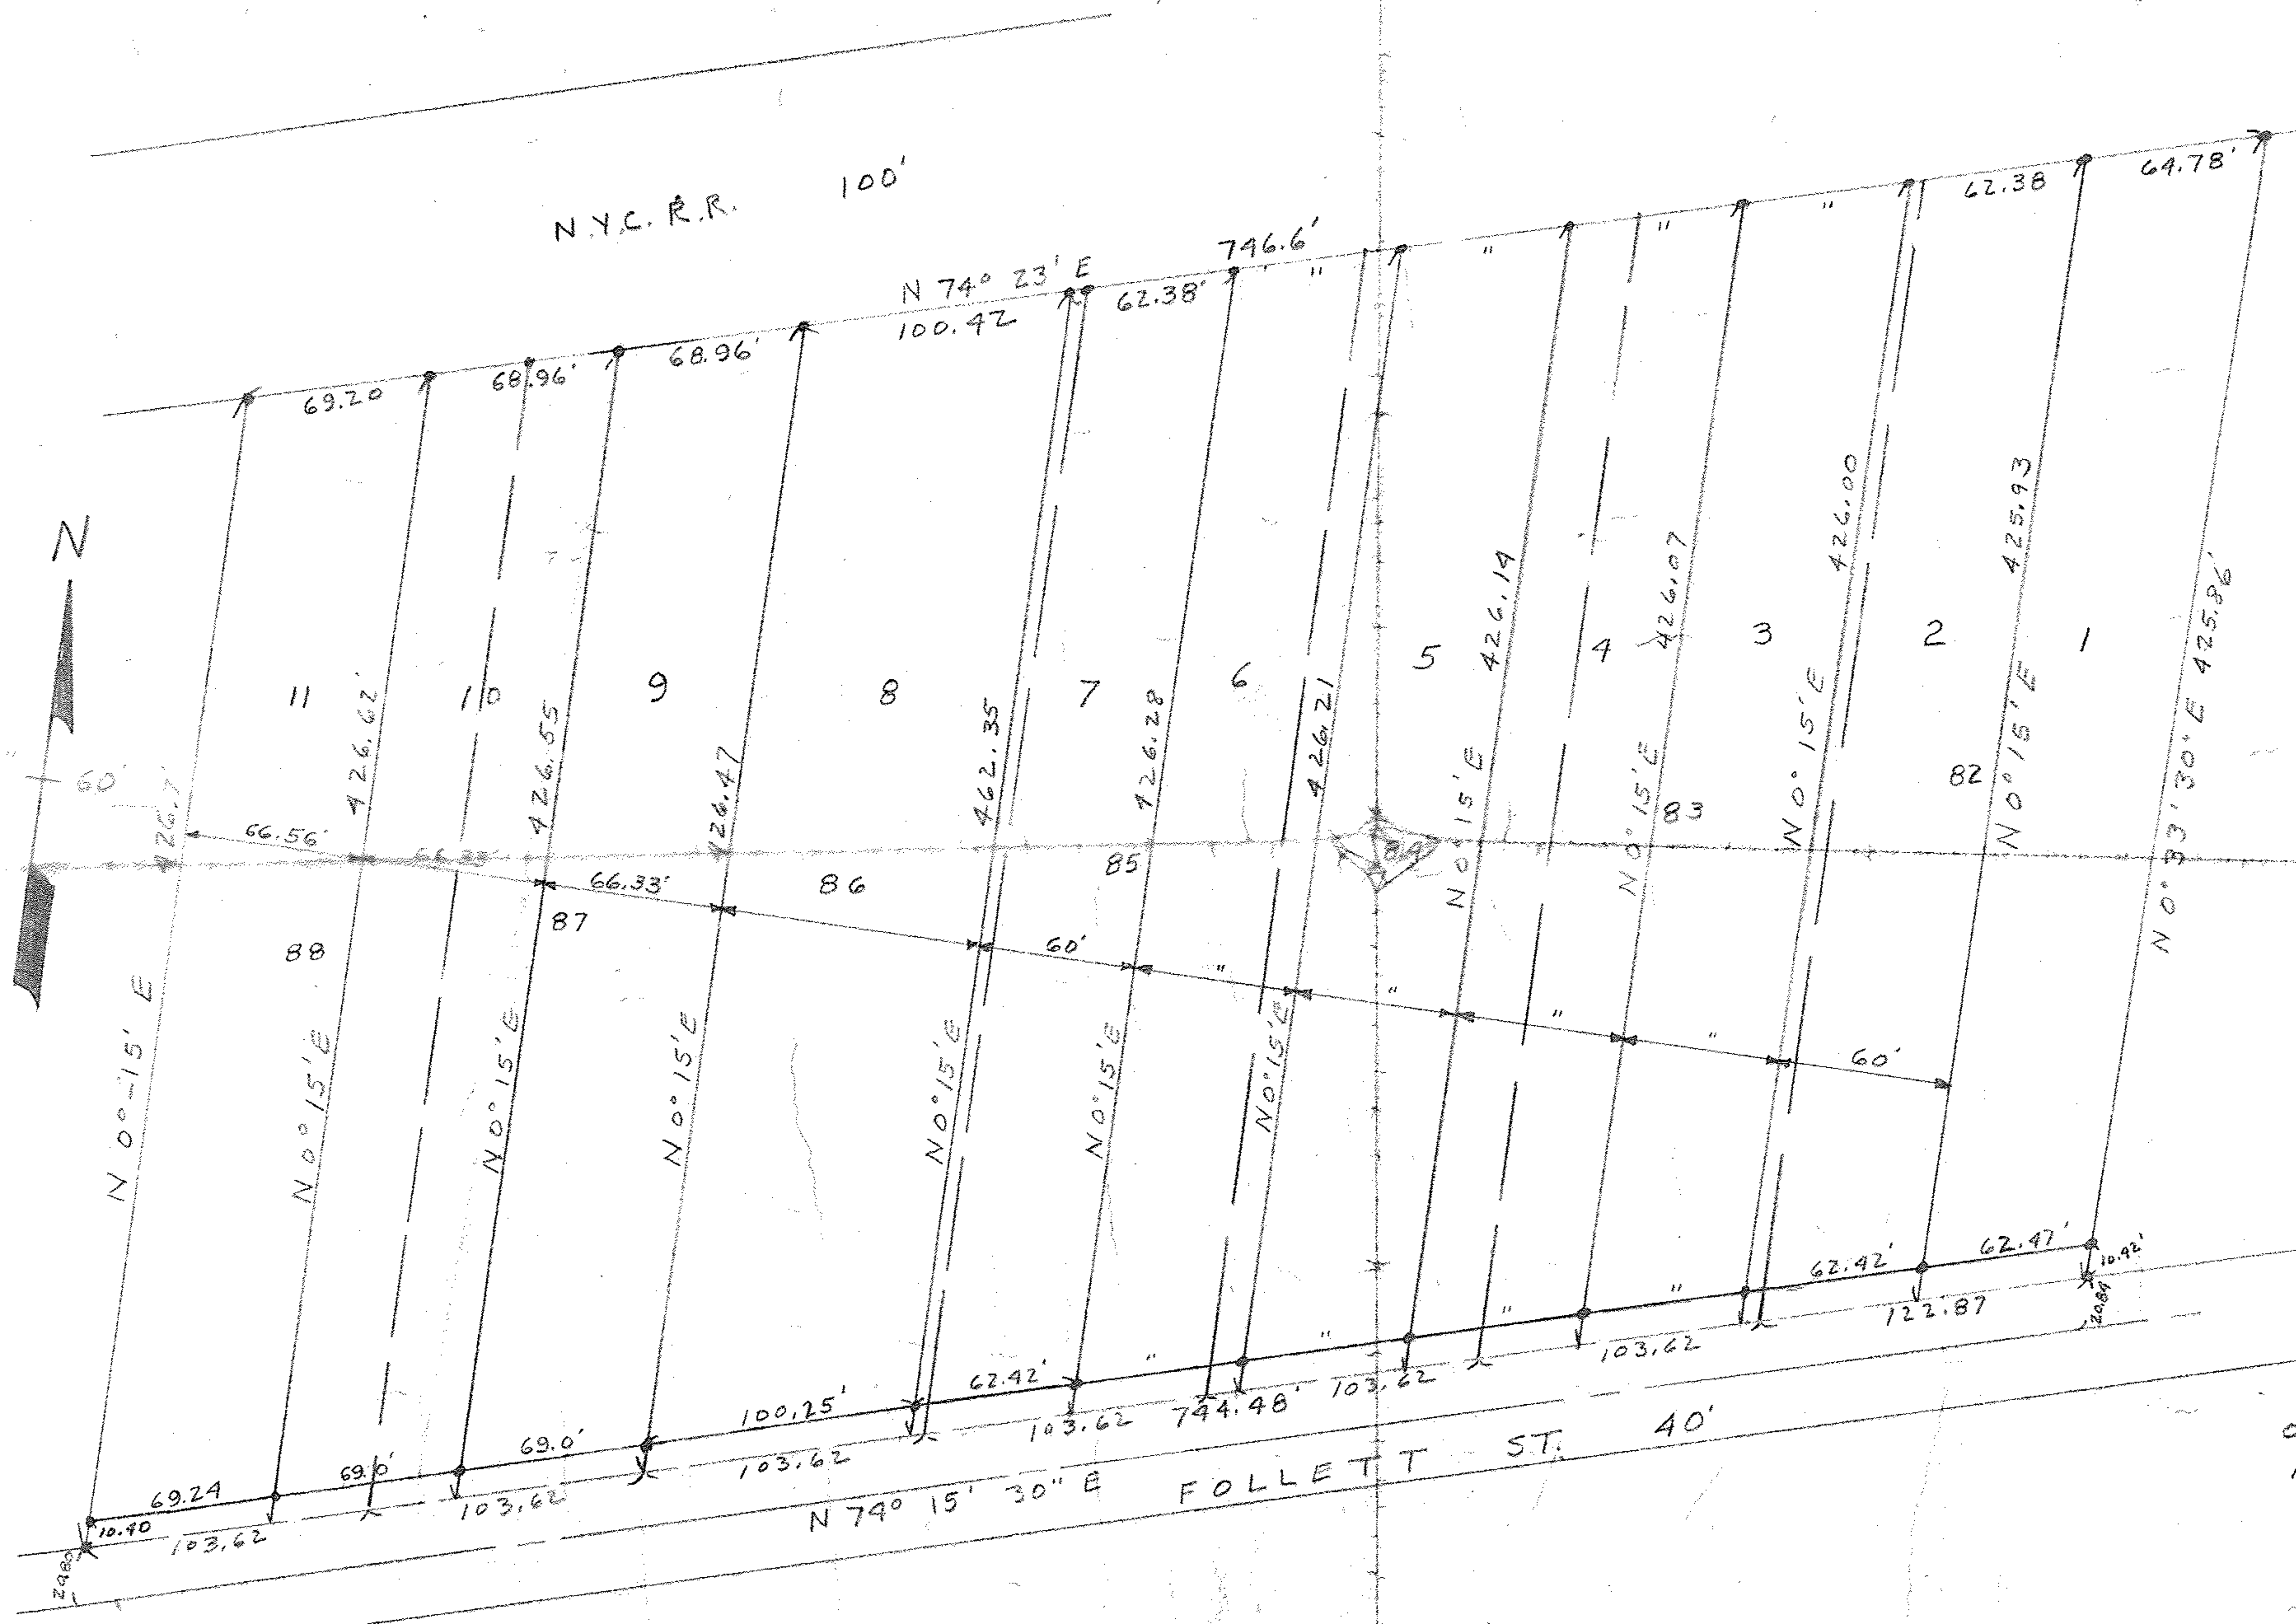

Map of Survey  
 for: Maybelle & Ray Fain  
 James & Mattie Henderson  
 James & Sarah Dotson  
 Fannie May Coop  
 Ben Allen Coates

Parts D.L. 94 & 95 Russia Twp.  
 Sublots 82, 83, 84, 85, 86, 87, & 88

Pins found or set marked thus:  
 Survey lines are solid lines  
 Sublot lines are dotted lines  
 Parcels numbered 1 thru 11

O.S. Hillman, Reg. Surv.  
 August 31, 1959 Scale 1"=60'