


ELIZABETH J. SKIDMORE
9-14-78 V.1216 P.662

S. 87° 48' 15" E.

I.P. Set
0.90 South

250.00'

I.P. Fd.

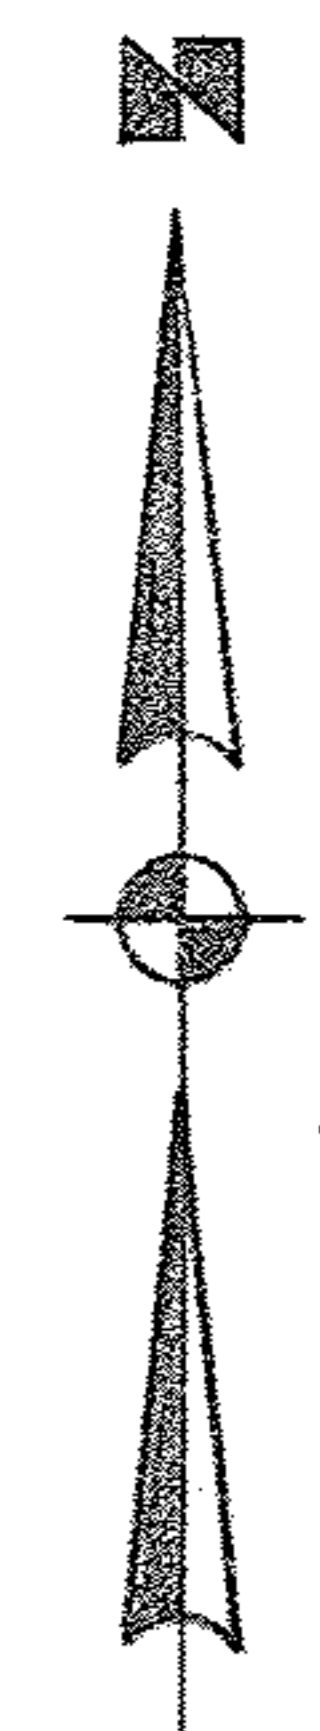

SCALE 1"=100'
JAN. 7, 1980

HALLAUER RD. 60'

JAMES & JUDITH CORNISH
V. 1187 P. 28

7.5042 Ac.

N. 2° 14' 15" E. 1310.47'

S. 2° 14' 15" W. 1304.61'
1637.38'

43980

PPN 14-00-044-000-012

MAP PG 14-C

600'

400'

N. 89° 08' 45" W.

250.07'

I.P. Set

I.P. Fd.

R.R. S.F.D.
0.18 W.

SURVEY FOR

CONC. MONS.

CONC. MONS.

CONC. MONS.

HUGHES RD. 60'

± HUGHES RD. AS ESTABLISHED
BY COUNTY ENGINEER - JUNE, 1992
ROAD RECORD VOL. 4 P. 416

MARGARET J. FILAK

O.L. 44 PITTSFIELD TWP.
LORAIN COUNTY OHIO
LAUNDON • SIMON • CAHL & ASSOC.
ENGINEERS SURVEYORS
JOB No 80-938