
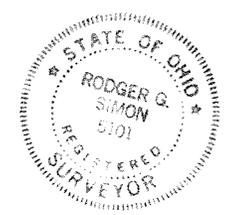


PPN 14-00-153-000-009  
011  
013

14-00-153-000-009  
14-00-153-000-011  
14-00-153-000-013  
14-F

MAP PG 14-F 43981

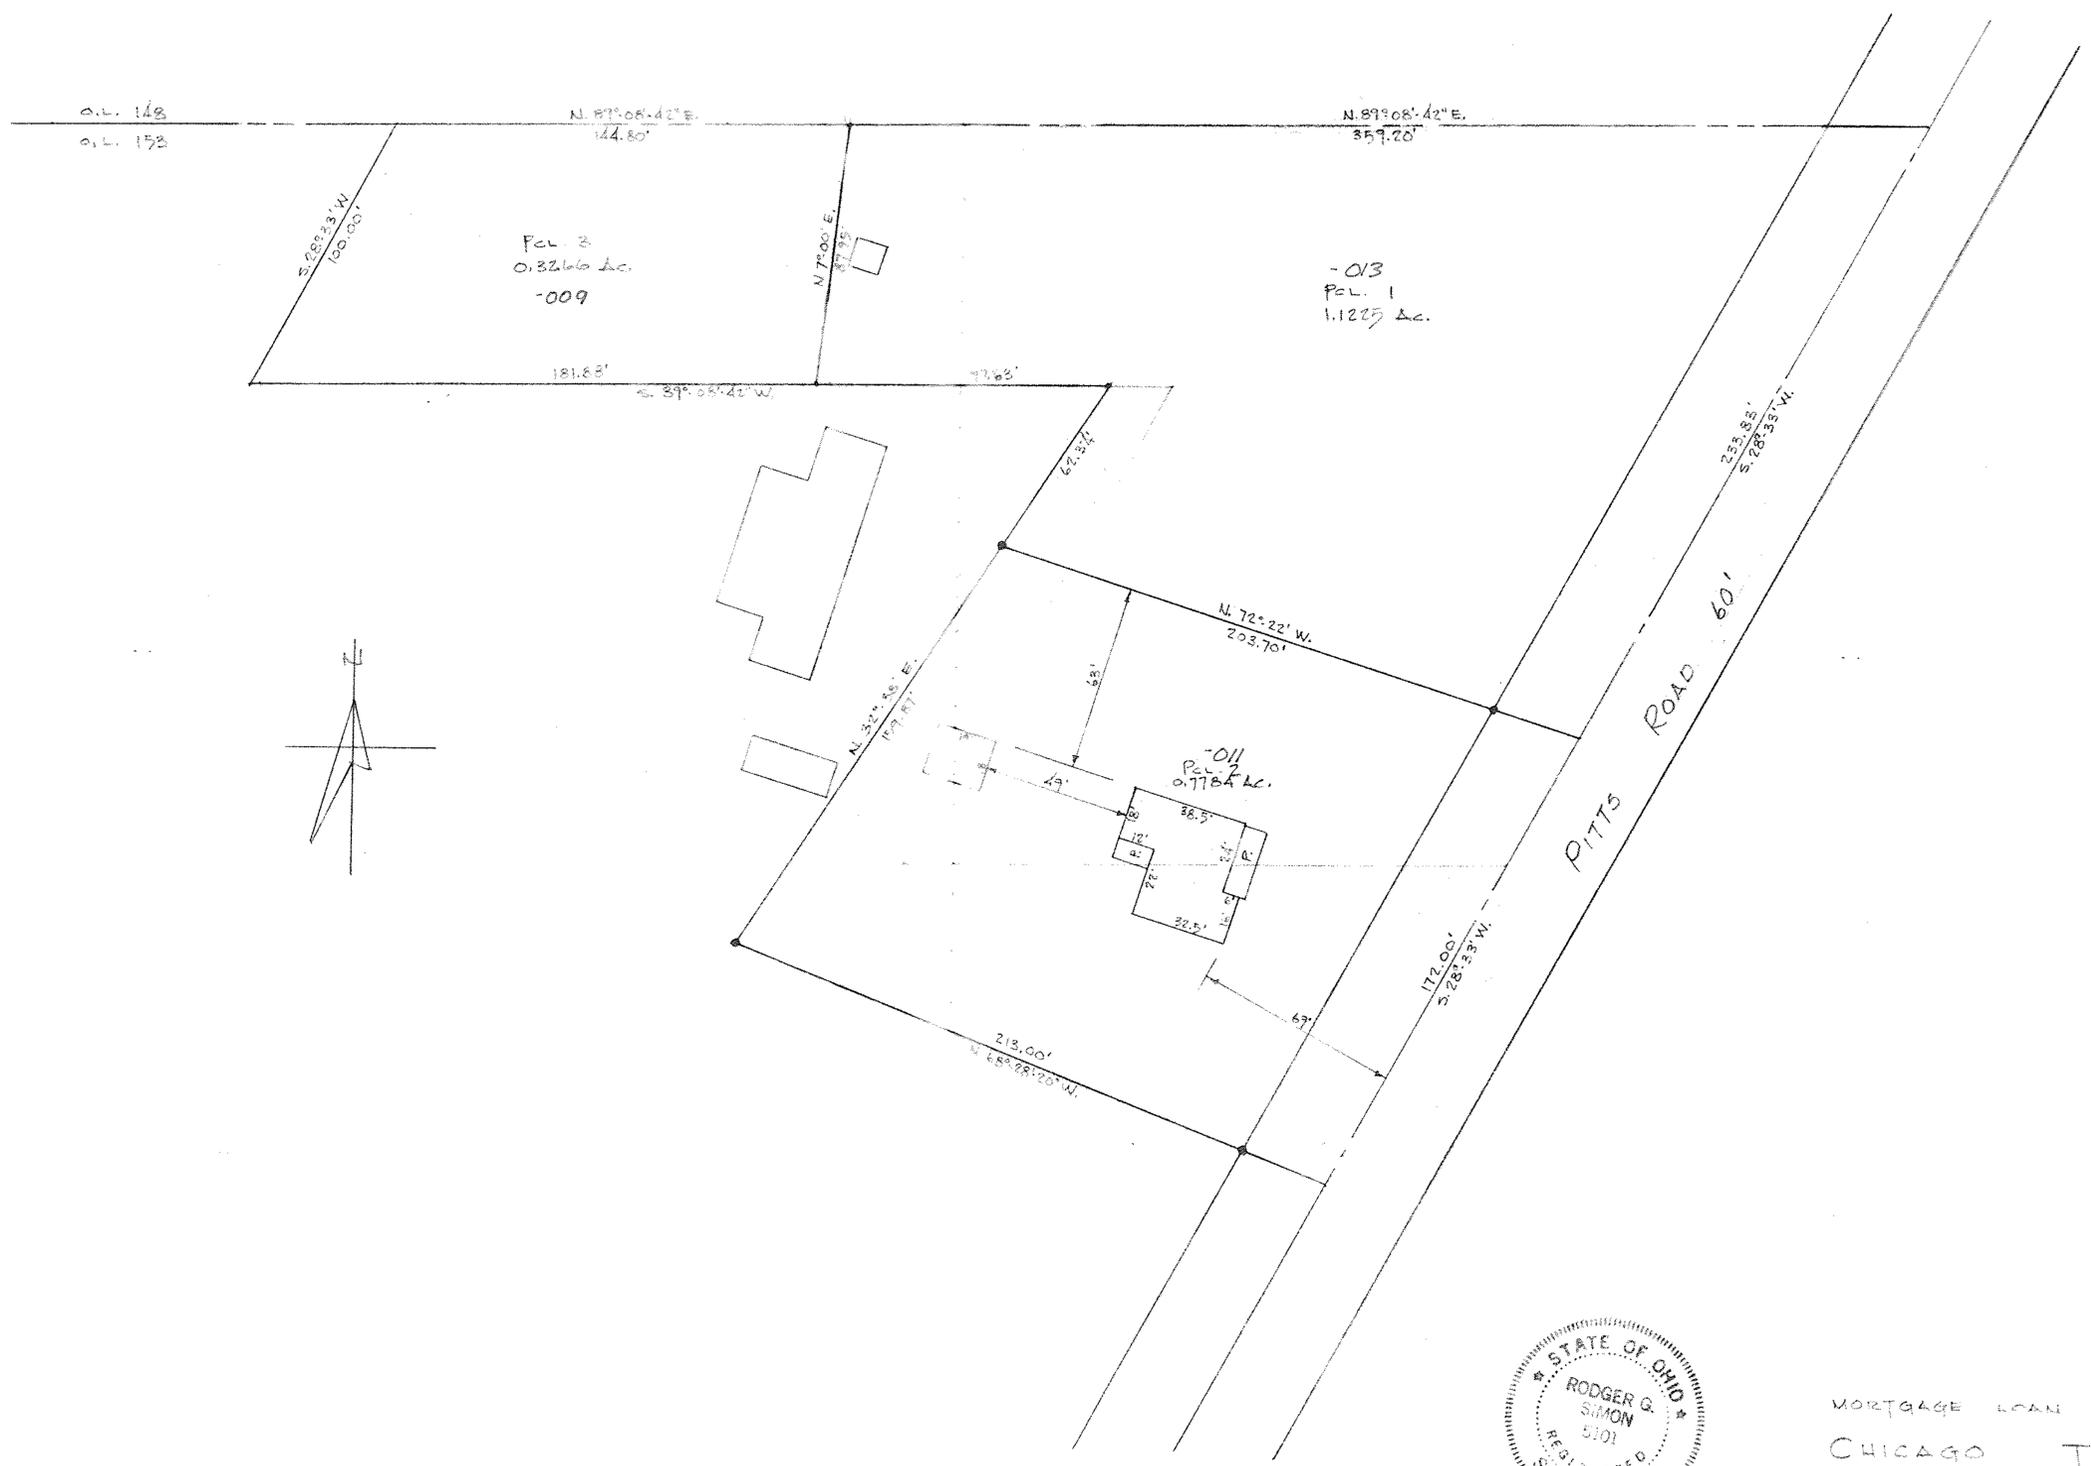

*Rodger G. Simon*  
For Mortgage Purposes only  
Not a plat of survey

MORTGAGE LOAN SURVEY  
CHICAGO TITLE  
O.L. 153 PITTSFIELD TWP.  
LORAIN COUNTY OHIO  
SCALE 1"=40' MAY, 1978  
78-721 E-174998